



Oregon Water Resources Department  
 725 Summer Street NE, Suite A  
 Salem, Oregon 97301  
 (503) 986-0900  
 www.oregon.gov/OWRD

# Ownership Update for Certificated Rights Only

RECEIVED  
 OCT 19 2020

**NO FEES ARE REQUIRED TO SUBMIT THIS FORM** OWRD

**NOTICE:** A certificate of water right typically stays with the land. In order to track water right ownership, the Department requests that this form be submitted to the Department. **To update multiple rights, a separate form is required for each right.**

If you have any questions about this form, please contact your local watermaster, or call the Water Resources Department at (503) 986-0900.

This form is not for Applications, Permits, Transfers, Groundwater Registrations, or Limited Licenses. To notify the Department of changes in ownership to these types of authorizations, an Assignment is required.

**Current Landowner Information**

Name: M. CAROL HART-CANON

Mailing Address: 40011 SW DIXON MILL RD

City: GASTON State: OR Zip: 97119  
971.998.0947

Phone (Home): \_\_\_\_\_ Work: \_\_\_\_\_ Other: \_\_\_\_\_

**Property Description**

County: WASHINGTON Township: 1S Range: 3W Section: 32

Taxlot Number(s): 1100

Street Address of water right property: 40011 SW DIXON MILL RD, GASTON

Water Right Information: Application: \_\_\_\_\_ - \_\_\_\_\_ Permit: \_\_\_\_\_ - \_\_\_\_\_ Certificate #: 47663

Are all the lands associated with this water right owned by the requester?  Yes  No (If No, include a map showing the portion of the right involved.)

Name of individual completing this form: \_\_\_\_\_ Phone: \_\_\_\_\_

Signature of requestor: \_\_\_\_\_ Date: \_\_\_\_\_

The Department does not change names on certificates. This form will be placed in the file for future reference only. The Department does not provide acknowledgement that this form has been received.

This form can be mailed to the address above or sent via email to wrd\_dl\_customerservice@oregon.gov.

RECEIVED  
OCT 19 2020  
OWRD

## STATE OF OREGON

COUNTY OF WASHINGTON

## CERTIFICATE OF WATER RIGHT

This Is to Certify, That ERIC JAMES CANON

of Rt. 1, Box 65, Gaston, State of Oregon, 97119, has made proof to the satisfaction of the Water Resources Director, of a right to the use of the waters of a spring

a tributary of Tualatin River for the purpose of domestic use for one family including the irrigation of lawn and garden not to exceed  $\frac{1}{2}$  acre in area. under Permit No. 38393 and that said right to the use of said waters has been perfected in accordance with the laws of Oregon; that the priority of the right hereby confirmed dates from July 10, 1973 that the amount of water to which such right is entitled and hereby confirmed, for the purposes aforesaid, is limited to an amount actually beneficially used for said purposes, and shall not exceed 0.01 cubic foot per second

or its equivalent in case of rotation, measured at the point of diversion from the stream. The point of diversion is located in the NW $\frac{1}{4}$  SW $\frac{1}{4}$ , Section 32, T. 1 S., R. 3 W., W. M., 130 feet South and 1290 feet East from the W $\frac{1}{2}$  Corner, Section 32

The amount of water used for irrigation, together with the amount secured under any other right existing for the same lands, shall be limited to ----- of one cubic foot per second per acre,

and shall conform to such reasonable rotation system as may be ordered by the proper state officer.


A description of the place of use under the right hereby confirmed, and to which such right is appurtenant, is as follows:

NW $\frac{1}{4}$  SW $\frac{1}{4}$   
Section 32  
T. 1 S., R. 3 W., W. M.

The right to the use of the water for the purposes aforesaid is restricted to the lands or place of use herein described and is subject to the existing minimum flow policies established by the Water Policy Review Board.

WITNESS the signature of the Water Resources Director, affixed

this date. March 16, 1979,

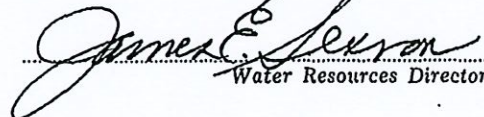
  
Water Resources Director

T.1S. R.3W.,W.M.

RECEIVED

OCT 19 2020

OWRD

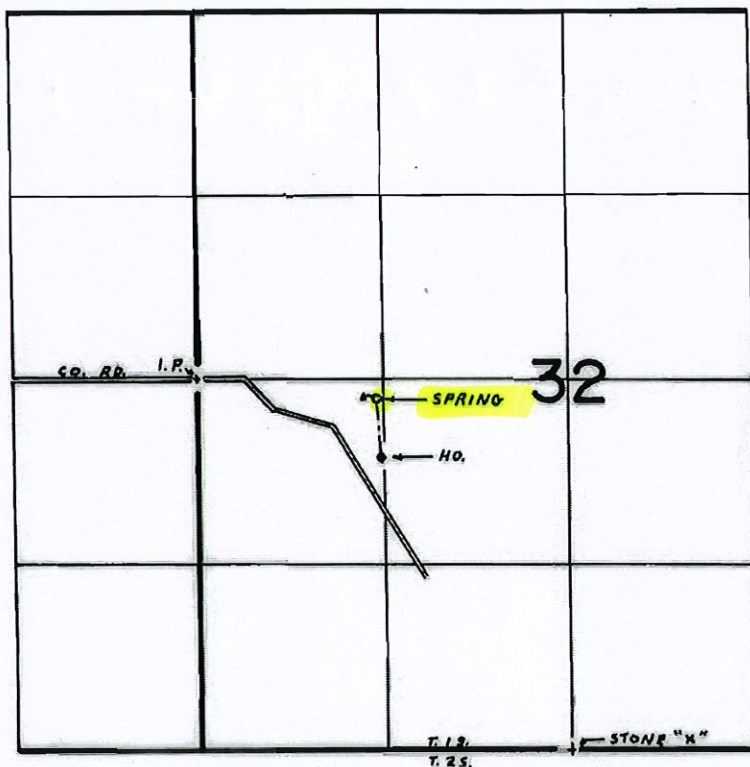

SPRING LOC. 1290' E. & 130' S. FROM W. 1/4 COR. SEC. 32

**FINAL PROOF SURVEY**  
UNDER

Application No. 50849... Permit No. 38393...  
IN NAME OF

.....ERIC JAMES CANON.....

Surveyed MAY 3, 1977, by D.M. NORBY.....