


RECEIVED
MAR 15 2021
OWRD

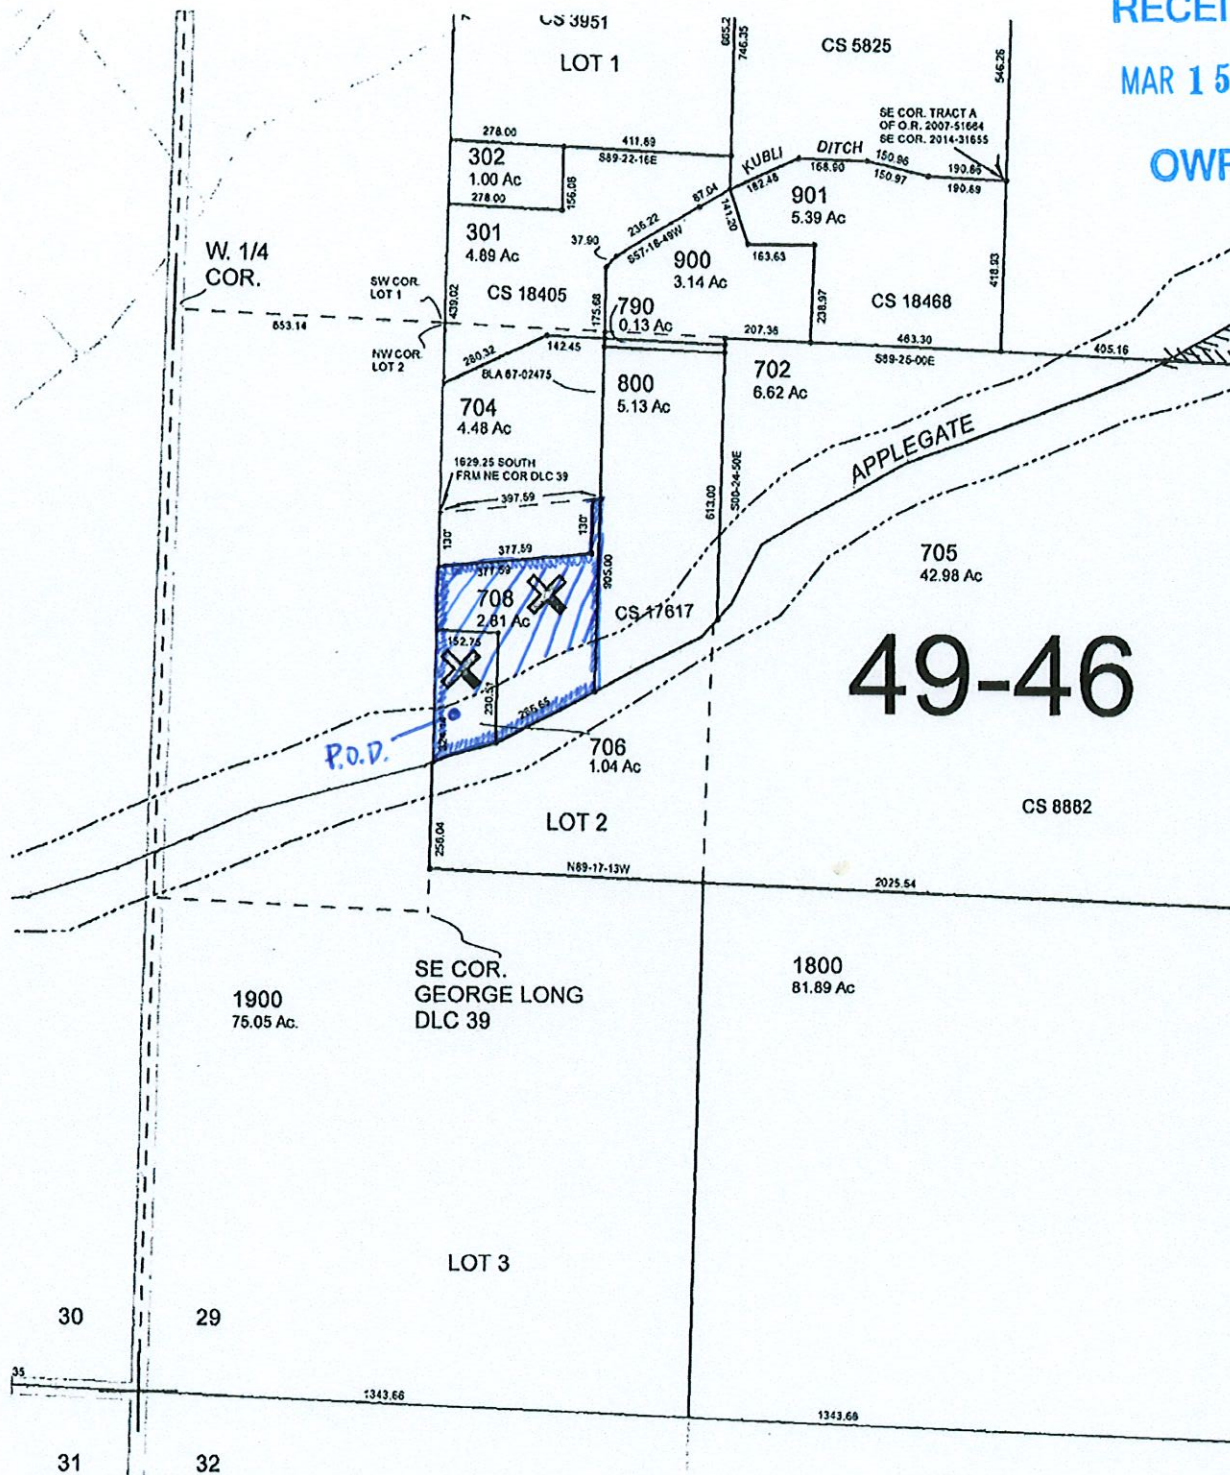

49-46

TOWNSHIP 38 RANGE 3W SECTION 29
THIS MAP IS FOR LOCATION PURPOSES ONLY
NO LIABILITY IS ASSUMED FOR VARIATIONS
DISCLOSED BY SURVEY OR COUNTY RECORDS
FIRST AMERICAN TITLE



S.
C.
SEE MAP:

1" = 450'

POINT OF DIVERSION IS APPROXIMATELY
650' WEST AND 400' NORTH OF THE
SE 1/4 OF THE SW 1/4 OF SECTION 29



CS 2

CS 3424

CS 3702

NE COR.
DLC 39

PROVOLT

HWY

MEDFORD

PART. PLAT
P-3-199

W. 1/4
COR.

APPLEGATE

RIVER

49-46

SEE MAP 38 3 W 30

P.O.D.

708
2.81 Ac

706
1.04 Ac

LOT 2

SE COR.
DLC 39

P.1

P.2

RECEIVED
FEB 16 2021
OWRD
SALEM, OREGON

RECEIVED
MAR 15 2021
OWRD

40-2

11-2020

78.06
127.54

1601
20.00 Ac

