


Reservoir Application
TAJS Enterprises
T.22S R.8W Section 25 & 36
Douglas County
Scale: 1"=800'

RECEIVED
MAR 22 2021
OWRD

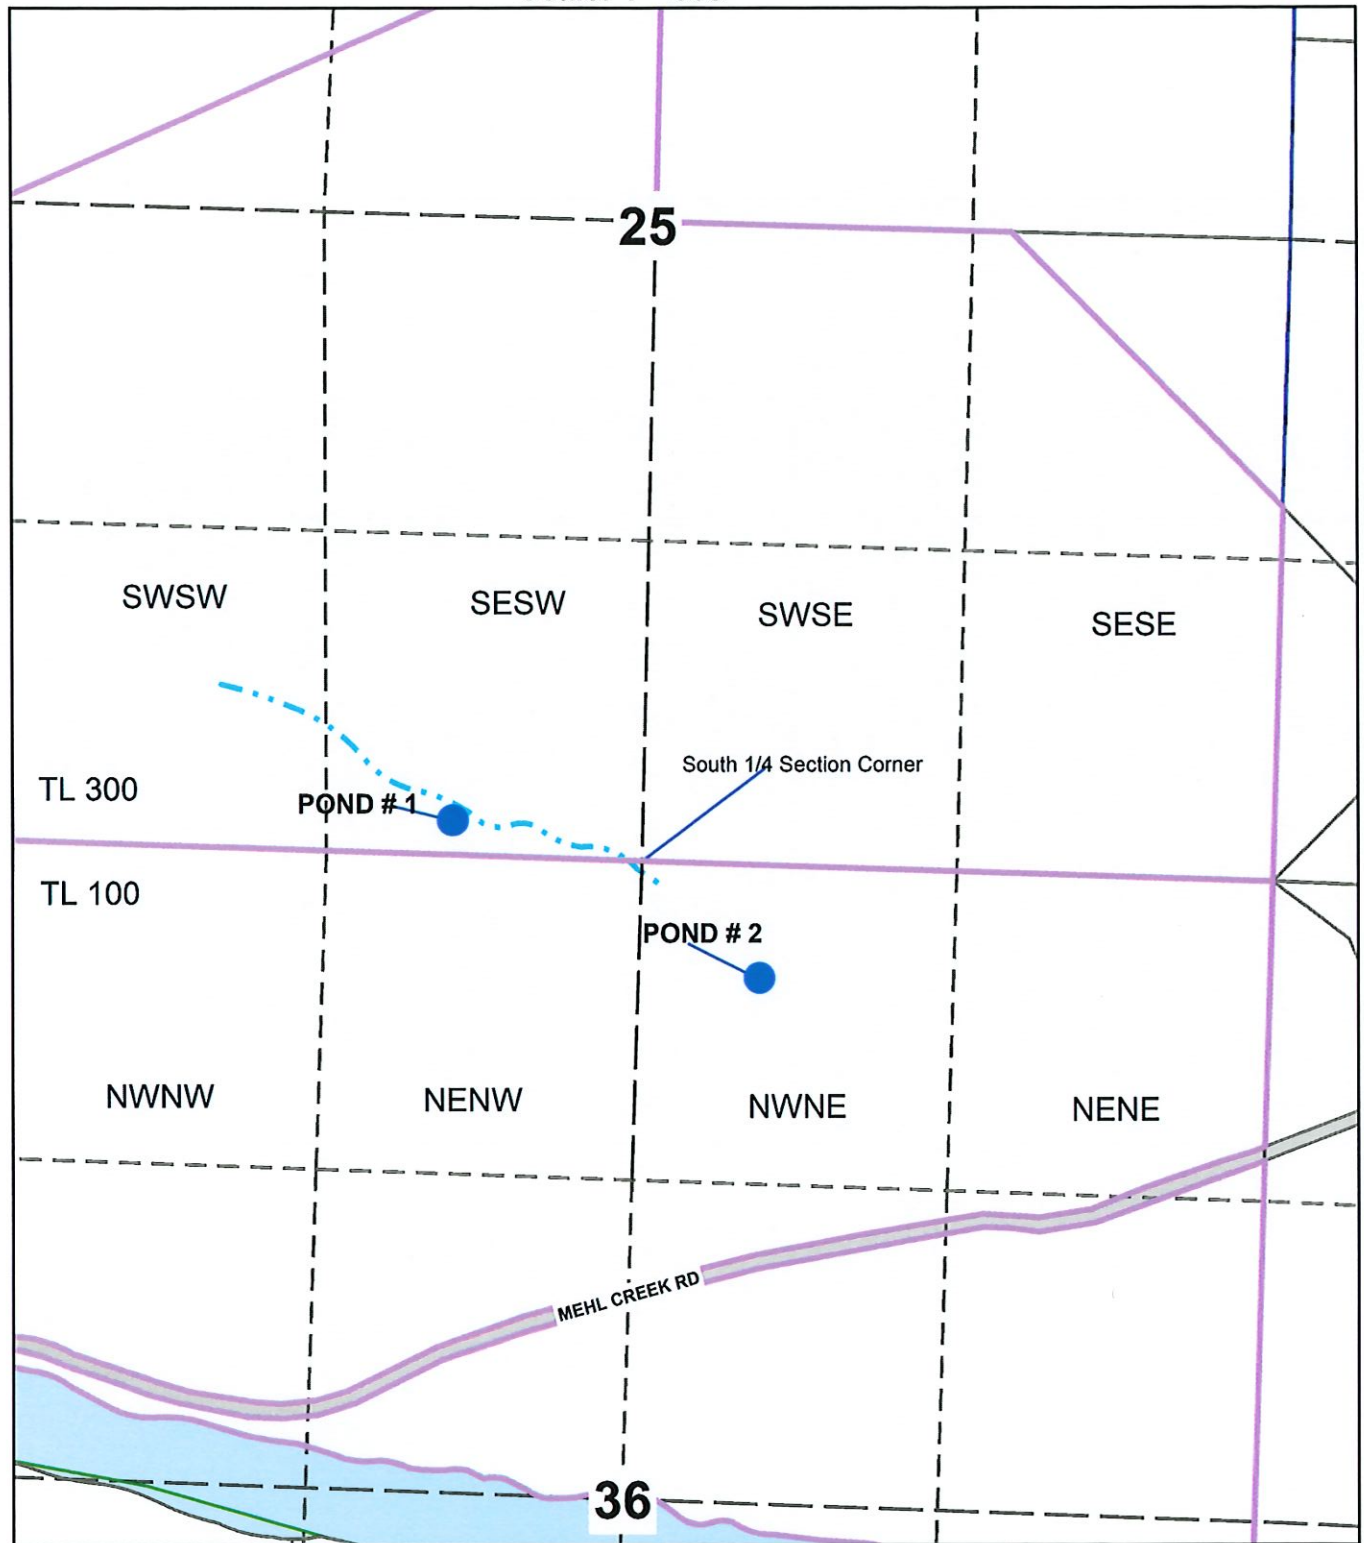

Pond #1 is 142 ft North and 800 ft West from the South 1/4 Section Corner of 25

Pond #2 is 475 ft South and 795 ft East from the South 1/4 Section Corner of 25


The purpose of this map is to identify the location of a water right.
Not intended to show property ownership.

THIS MAP WAS PREPARED FOR ASSESSMENT PURPOSE ONLY.

SEC.25 T.22S. R.8W. W.M.
DOUGLAS COUNTY
1" = 400'

REVISED ON
3-6-96

22 8 25

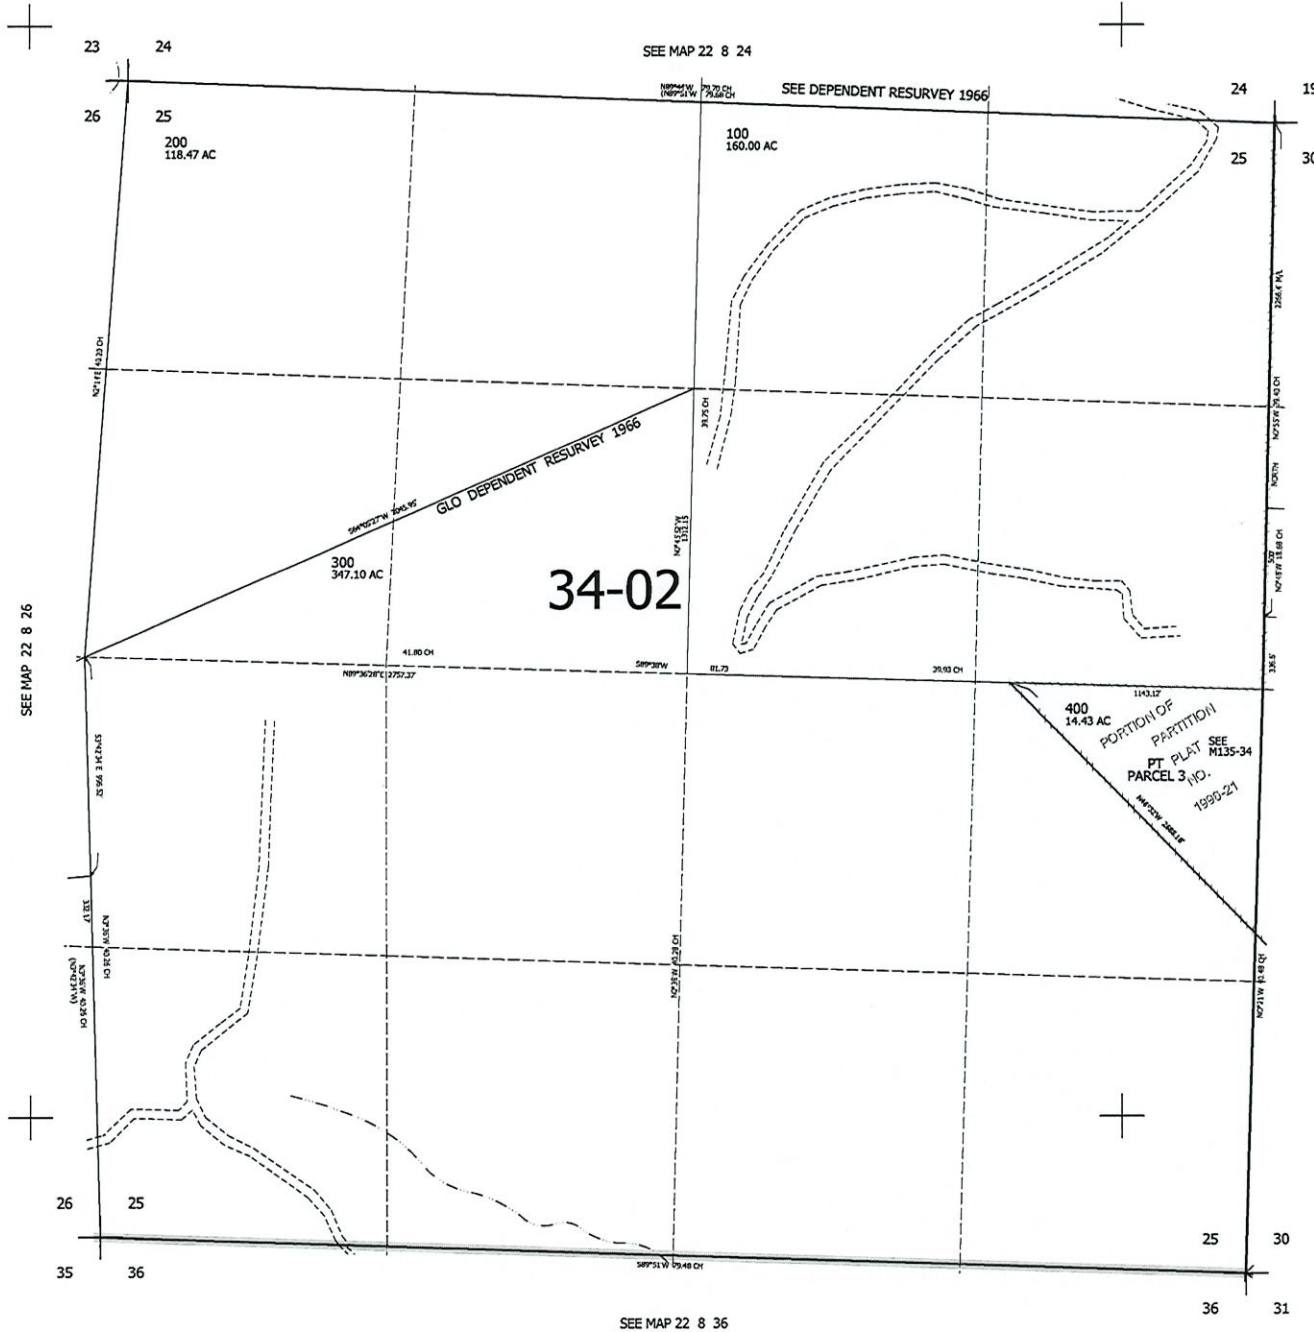

CANCELLED NO'S

OWRD

RECEIVED
MAR 2 2 2021

728,000

22 8 25