


Township 1 S., Range 44, E. W. M.

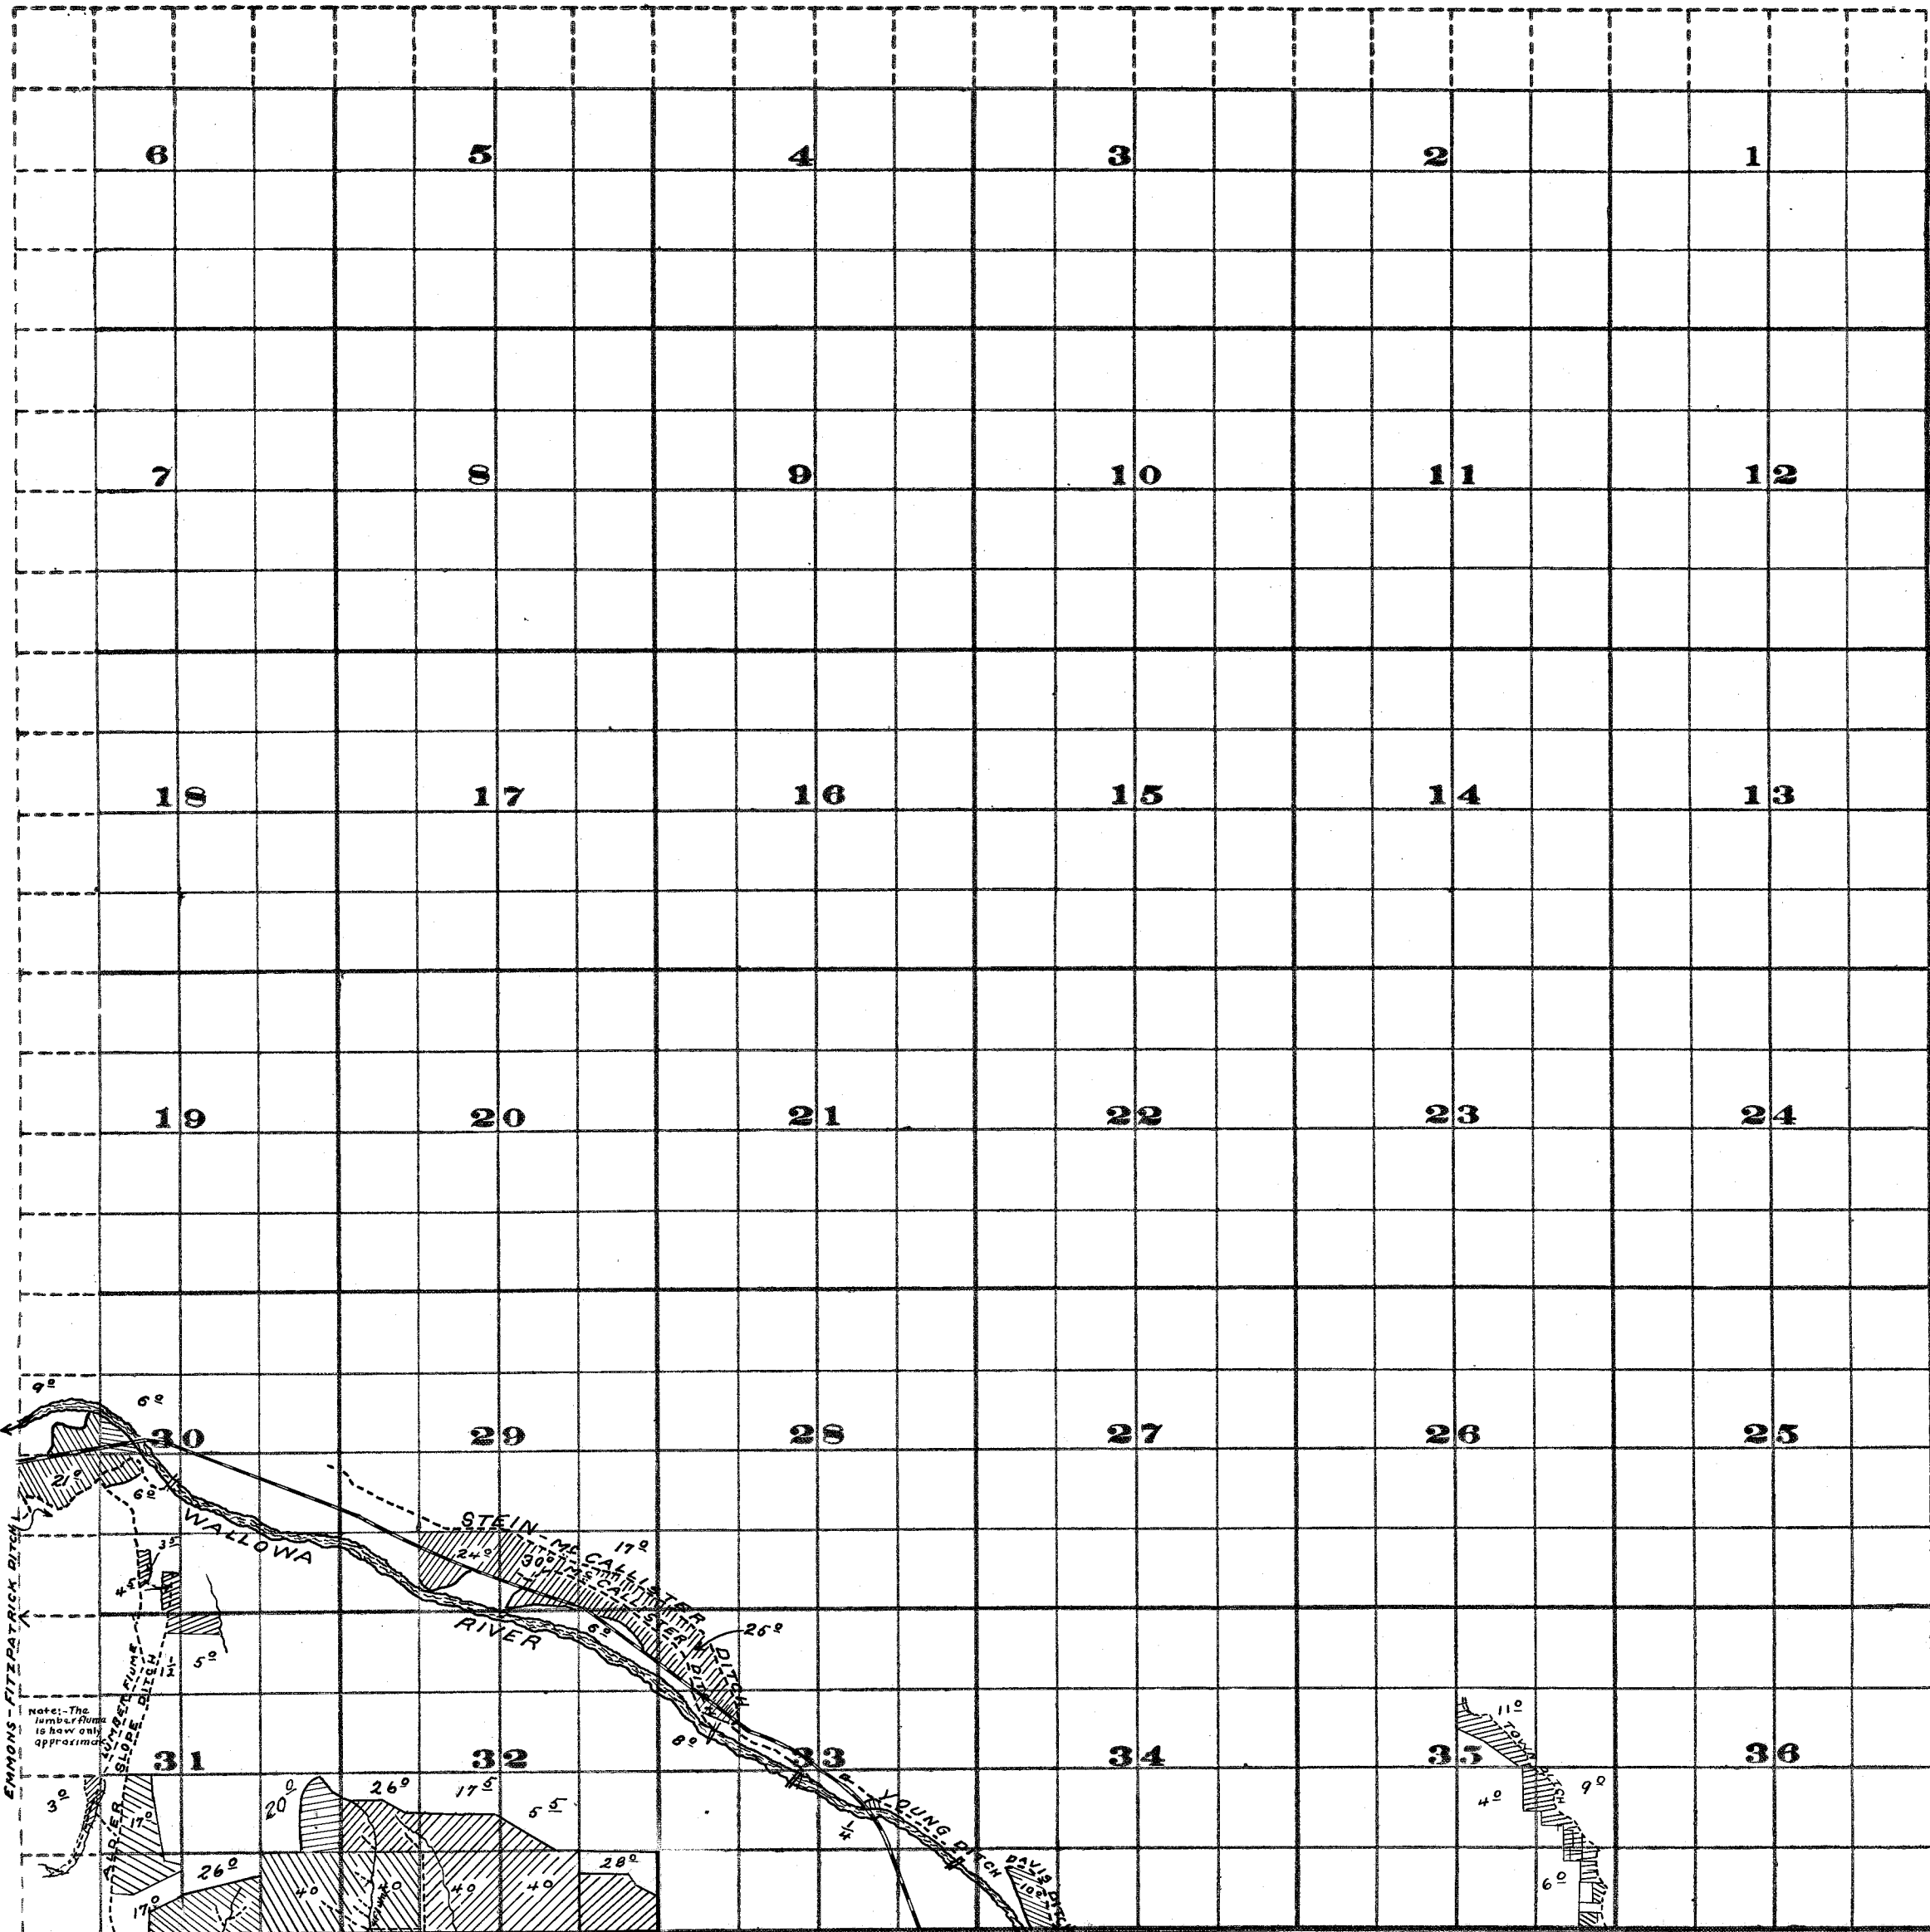

EMMONS-FITZPATRICK SURVEY

Note: The lumber flume is here only approximately



Scale of Feet.




Survey Oct. 1914.

FROM OFFICE OF THE STATE ENGINEER, NALEM, OREGON

Adjudication Survey
Wallowa River
and
Tributaries.

- LEGEND -
- Irrigated land with area
 - Ditches.
 - Streams.
 - Located corners.

Township 2 S., Range 44 E.W.M.

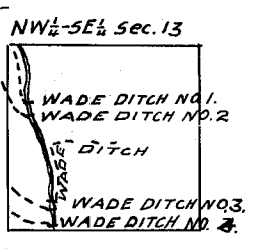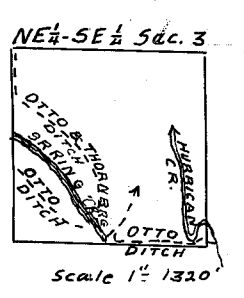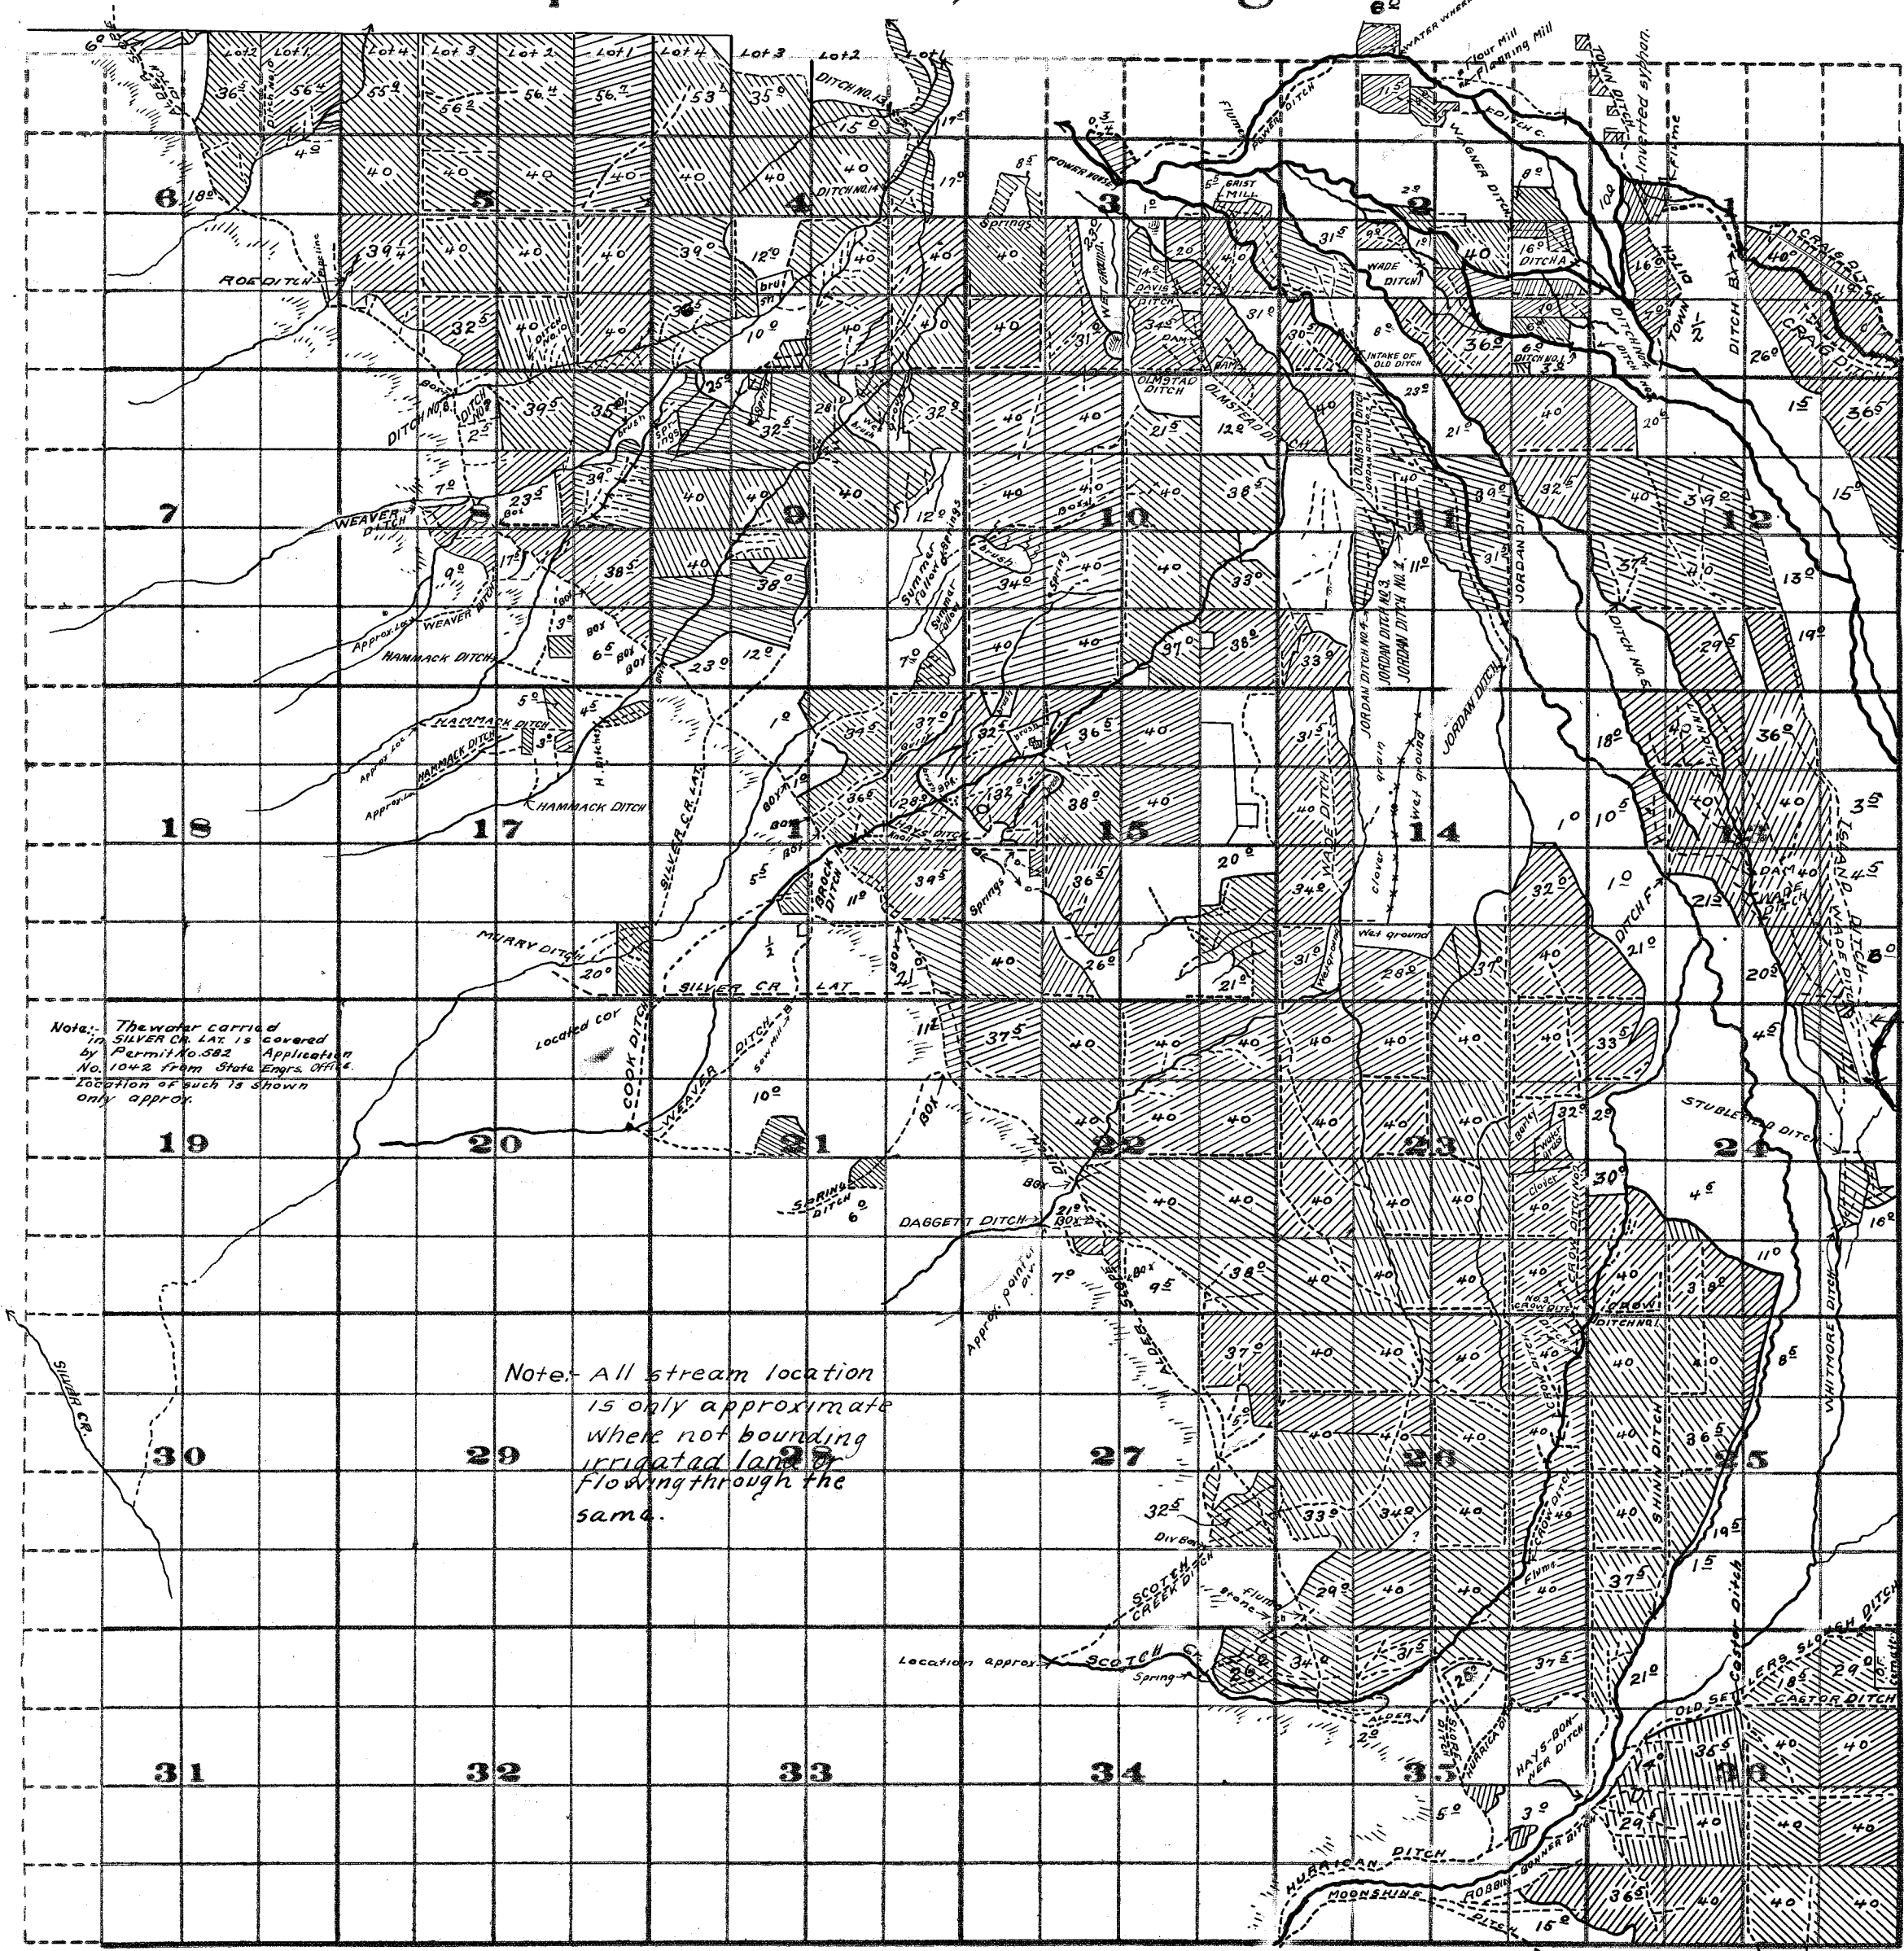

- LEGEND -
 Irrigated land with areas.
 Ditches.
 Streams.
 Located corners.

Survey Sept. 1914.

Adjudication Survey
 Wallowa River
 and
 Tributaries.