

October 24, 1994

Oregon

RUTH E HAUSOTTER

1994 PRUNER RD
RIDDLE, OR 97469

WATER
RESOURCES
DEPARTMENT

REFERENCE: File # P-74622;
Notice of Exempt Reservoir (Pond)

Your exempt reservoir notice has been received by the Department and has been assigned the above-referenced file number. We would like to ask you to refer to this number if you should need to contact us about the notice, your pond, or ponds if you have more than one.

To avoid any misunderstanding, we feel it is important to tell you that although we have received and filed your notice, we have not yet determined whether you are exempt from water right requirements. The watermaster responsible for the area in which the pond(s) is (are) located will help us apply the Water Resources Commission's administrative rules to your situation. These rules set the standards that determine which ponds require water rights and which are exempt. We will let you know the results as soon as we are able to complete our review of your pond(s)'s nature.

Since the department must rely initially on the information you submit to us, it is very important that the information be complete and accurate. If inspections show that your pond(s) does (do) not qualify as exempt, you could be asked to drain the pond(s) or submit a water right application or both. If you submit your application after January 1, 1995, it will be processed like any other application, since that is the deadline for filing water rights under the pond amnesty program.

The department will process your information as quickly as possible. However, because water right processing staff members are working hard to reduce a backlog of applications, it may be some weeks before you hear from us.

If you have questions, you may contact your watermaster. The enclosed brochure lists watermaster names, telephone numbers and addresses by county.

Sincerely,



Mr. Cory C. Engel
Water Rights Research Assistant
Water Rights/Adjudication Division

Enclosure: New Water Right Law for Pond Owners Brochure



Commerce Building
158 12th Street NE
Salem, OR 97310-0210
(503) 378-3739
FAX (503) 378-8130

STATE OF OREGON
WATER RESOURCES DEPARTMENT

NOTICE OF EXEMPT RESERVOIR

RECEIVED

SEP 13 1994

WATER RESOURCES DEPT.
SALEM, OREGON

This notice is submitted pursuant to ORS 537.141, which provides that a water right is not needed for certain ponds/reservoirs which were in existence before January 1, 1993, are located off-channel and store less than 9.2 acre-feet of water or have a dam less than 10 feet in height.

Landowner: Ruth E Hausalter Application No. P-74622

Authorized Agent: (if applicable) _____ Permit No. _____

Address: 1994 Prunna Rd.

Riddle ORE 97469 874-2495
City State Zip Telephone No.

I/WE SUBMIT NOTICE OF THE FOLLOWING RESERVOIR(S):

NOTE: Multiple reservoirs may be included in a single notification, provided the reservoirs are within the same ownership, on contiguous property and within the same drainage basin. For items 1-6 below, attach extra sheets for additional reservoir descriptions.

1. The reservoir is located in Section 13, Township 30 S, Range 6 W, in DOUGLAS County. (Enclose a US Geological Survey topographical map or a tax lot map showing the location of the reservoir(s). Copies of portions of the maps are acceptable, provided information on the copy verifies the correct legal description.)
2. Source of water: SPRING & RAIN RUN-OFF.
3. Maximum height of the dam: 3'.
4. Maximum water depth in the reservoir: 9'.
5. Maximum storage capacity of reservoir: 1.2 AF.
6. Size, description and location of any outlet pipe: NONE
7. Enclose evidence that the reservoir(s) existed before January 1, 1993, such as one or more of the following:
 - 7.1 A dated aerial photograph which shows the immediate area above, below and surrounding the reservoir(s);
 - 7.2 An affidavit signed by the landowner or other knowledgeable person;
 - 7.3 A dated map prepared by a local, state or federal agency showing the location of the reservoir; or
 - 7.4 Construction receipts or other forms of documentation.

Declaration by Owner/Authorized Agent:

Each of the reservoirs described herein was in existence before January 1, 1993, is located off-channel and stores less than 9.2 acre-feet of water or has a dam less than 10 feet in height.

I/We believe the reservoir(s) qualifies under ORS 537.141 and OAR 690-11-041 for exemption from Oregon's water right filing requirements.

Notice to Owners/Authorized Agent:

Reservoirs that qualify for exemption under ORS 537.141 and OAR 690-11-041 shall be subject to the following conditions:

1. The right to store or use water in the reservoir shall not have priority over any water right; and
2. The right to store and use water in the reservoir(s) shall be subordinate to all future permitted or certificated water rights.

THE UNDERSIGNED VERIFIES THAT TO THE BEST OF HIS/HER KNOWLEDGE AND BELIEF THE INFORMATION CONTAINED IN THIS NOTICE IS TRUE, CORRECT AND COMPLETE.

Landowner/agent signature: Franklin D. Hausetter

(Print Name and Title) FRANKLIN D. HAUSER

Date: 9/12/94

FOR WATER RESOURCES DEPARTMENT USE ONLY

The foregoing Notice and accompanying data have been examined by authorized staff of the Water Resources Department. Based on review of the information submitted, this Notice is accepted on _____, 1994 and assigned FILE NUMBER _____.


cc: Watermaster District # _____
To Data Center (date) _____

RECEIVED

SEP 13 1994

WATER RESOURCES DEPT.
7 SALEM, OREGON

SEE MAP 30 6 12D

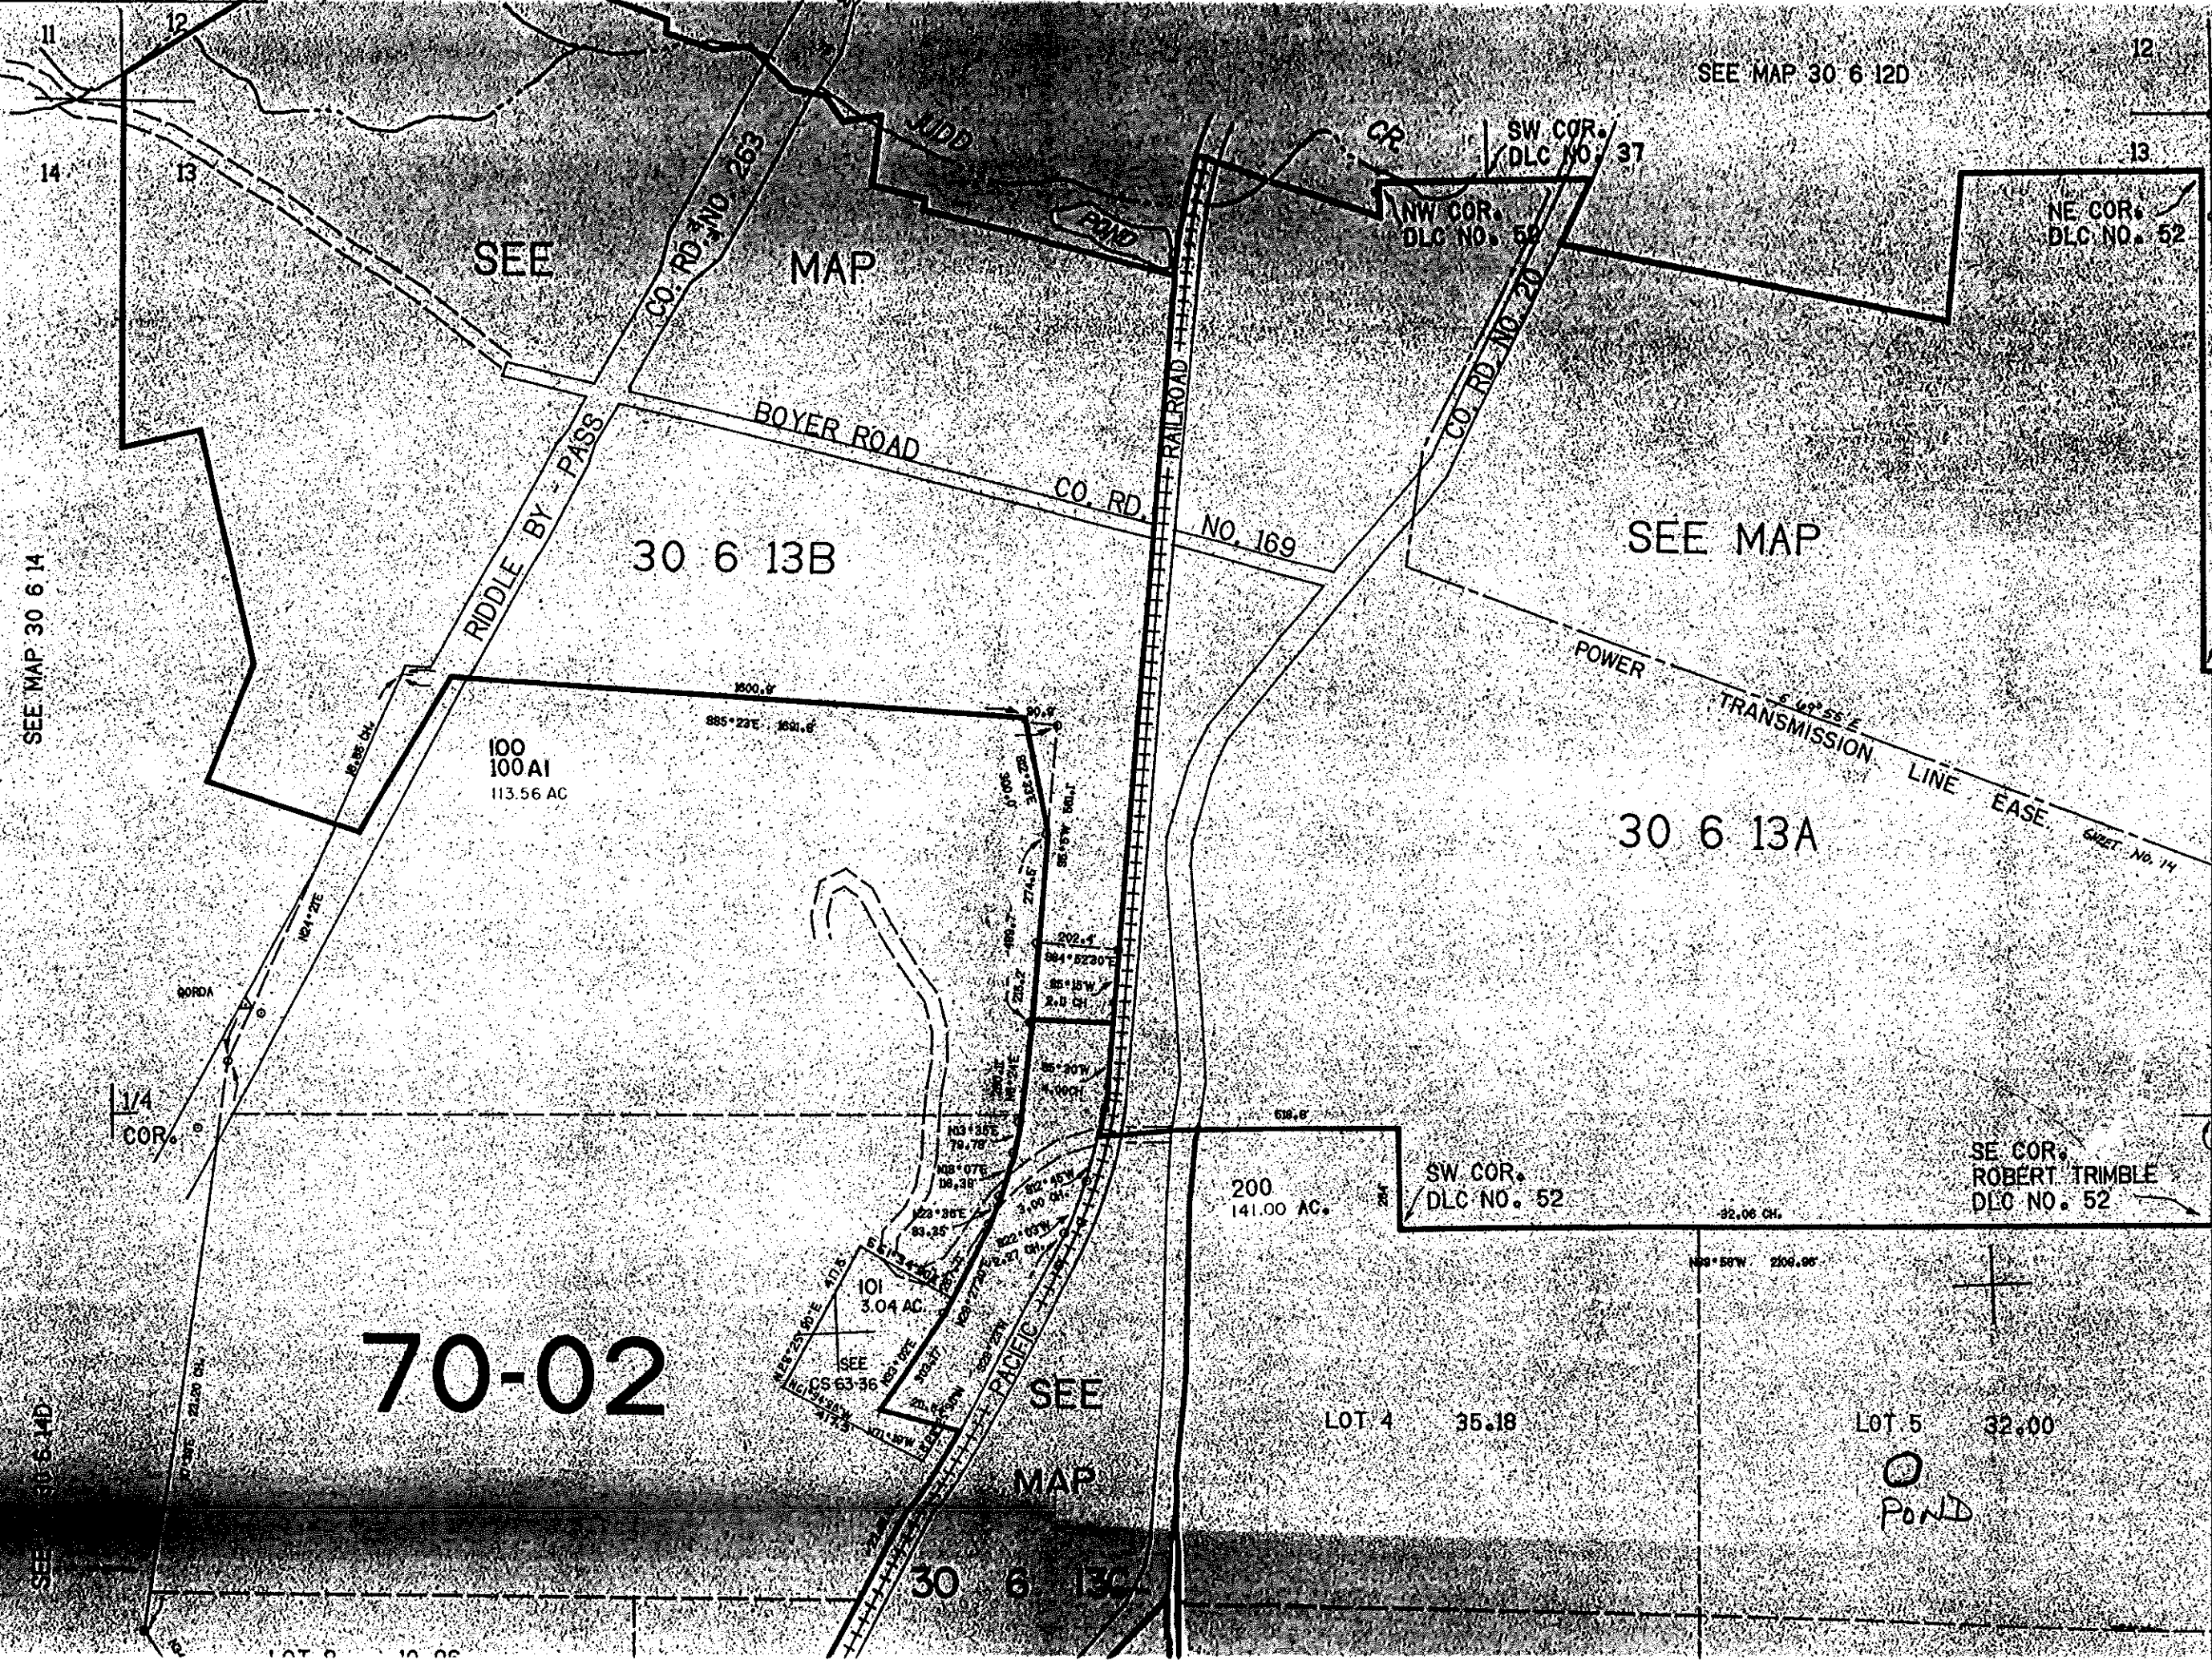

70-02

SEE MAP

30 6 13B

30 6 13A

30 6 13C

SW COR. DLC NO. 42

NE COR. DLC NO. 52

NW COR. DLC NO. 52

SW COR. DLC NO. 37

SE COR. ROBERT TRIMBLE DLC NO. 52

SW COR. DLC NO. 52

POWER TRANSMISSION LINE EASE
5 1/2° 55' E
622.14

485,000

SEE MAP 30 5 18

SEE MAP 30 6 14

SEE 30 6 14D

POND

LOT 4 35.18

LOT 5 32.00

18

12

13

14

13

12

11

1/4 COR.

1/4 COR.

SEE MAP CS 63-36

SEE MAP

SEE

MAP

JUDD

POND

GR

BOYER ROAD

RIDDLE BY-PASS

RAILROAD

CO. RD. NO. 169

CO. RD. NO. 263

CO. RD. NO. 20

100
100 AI
113.56 AC

200
141.00 AC.

101
3.04 AC.

LOT 4 35.18


LOT 5 32.00

30 6 13C

30 6 13B

30 6 13A

70-02

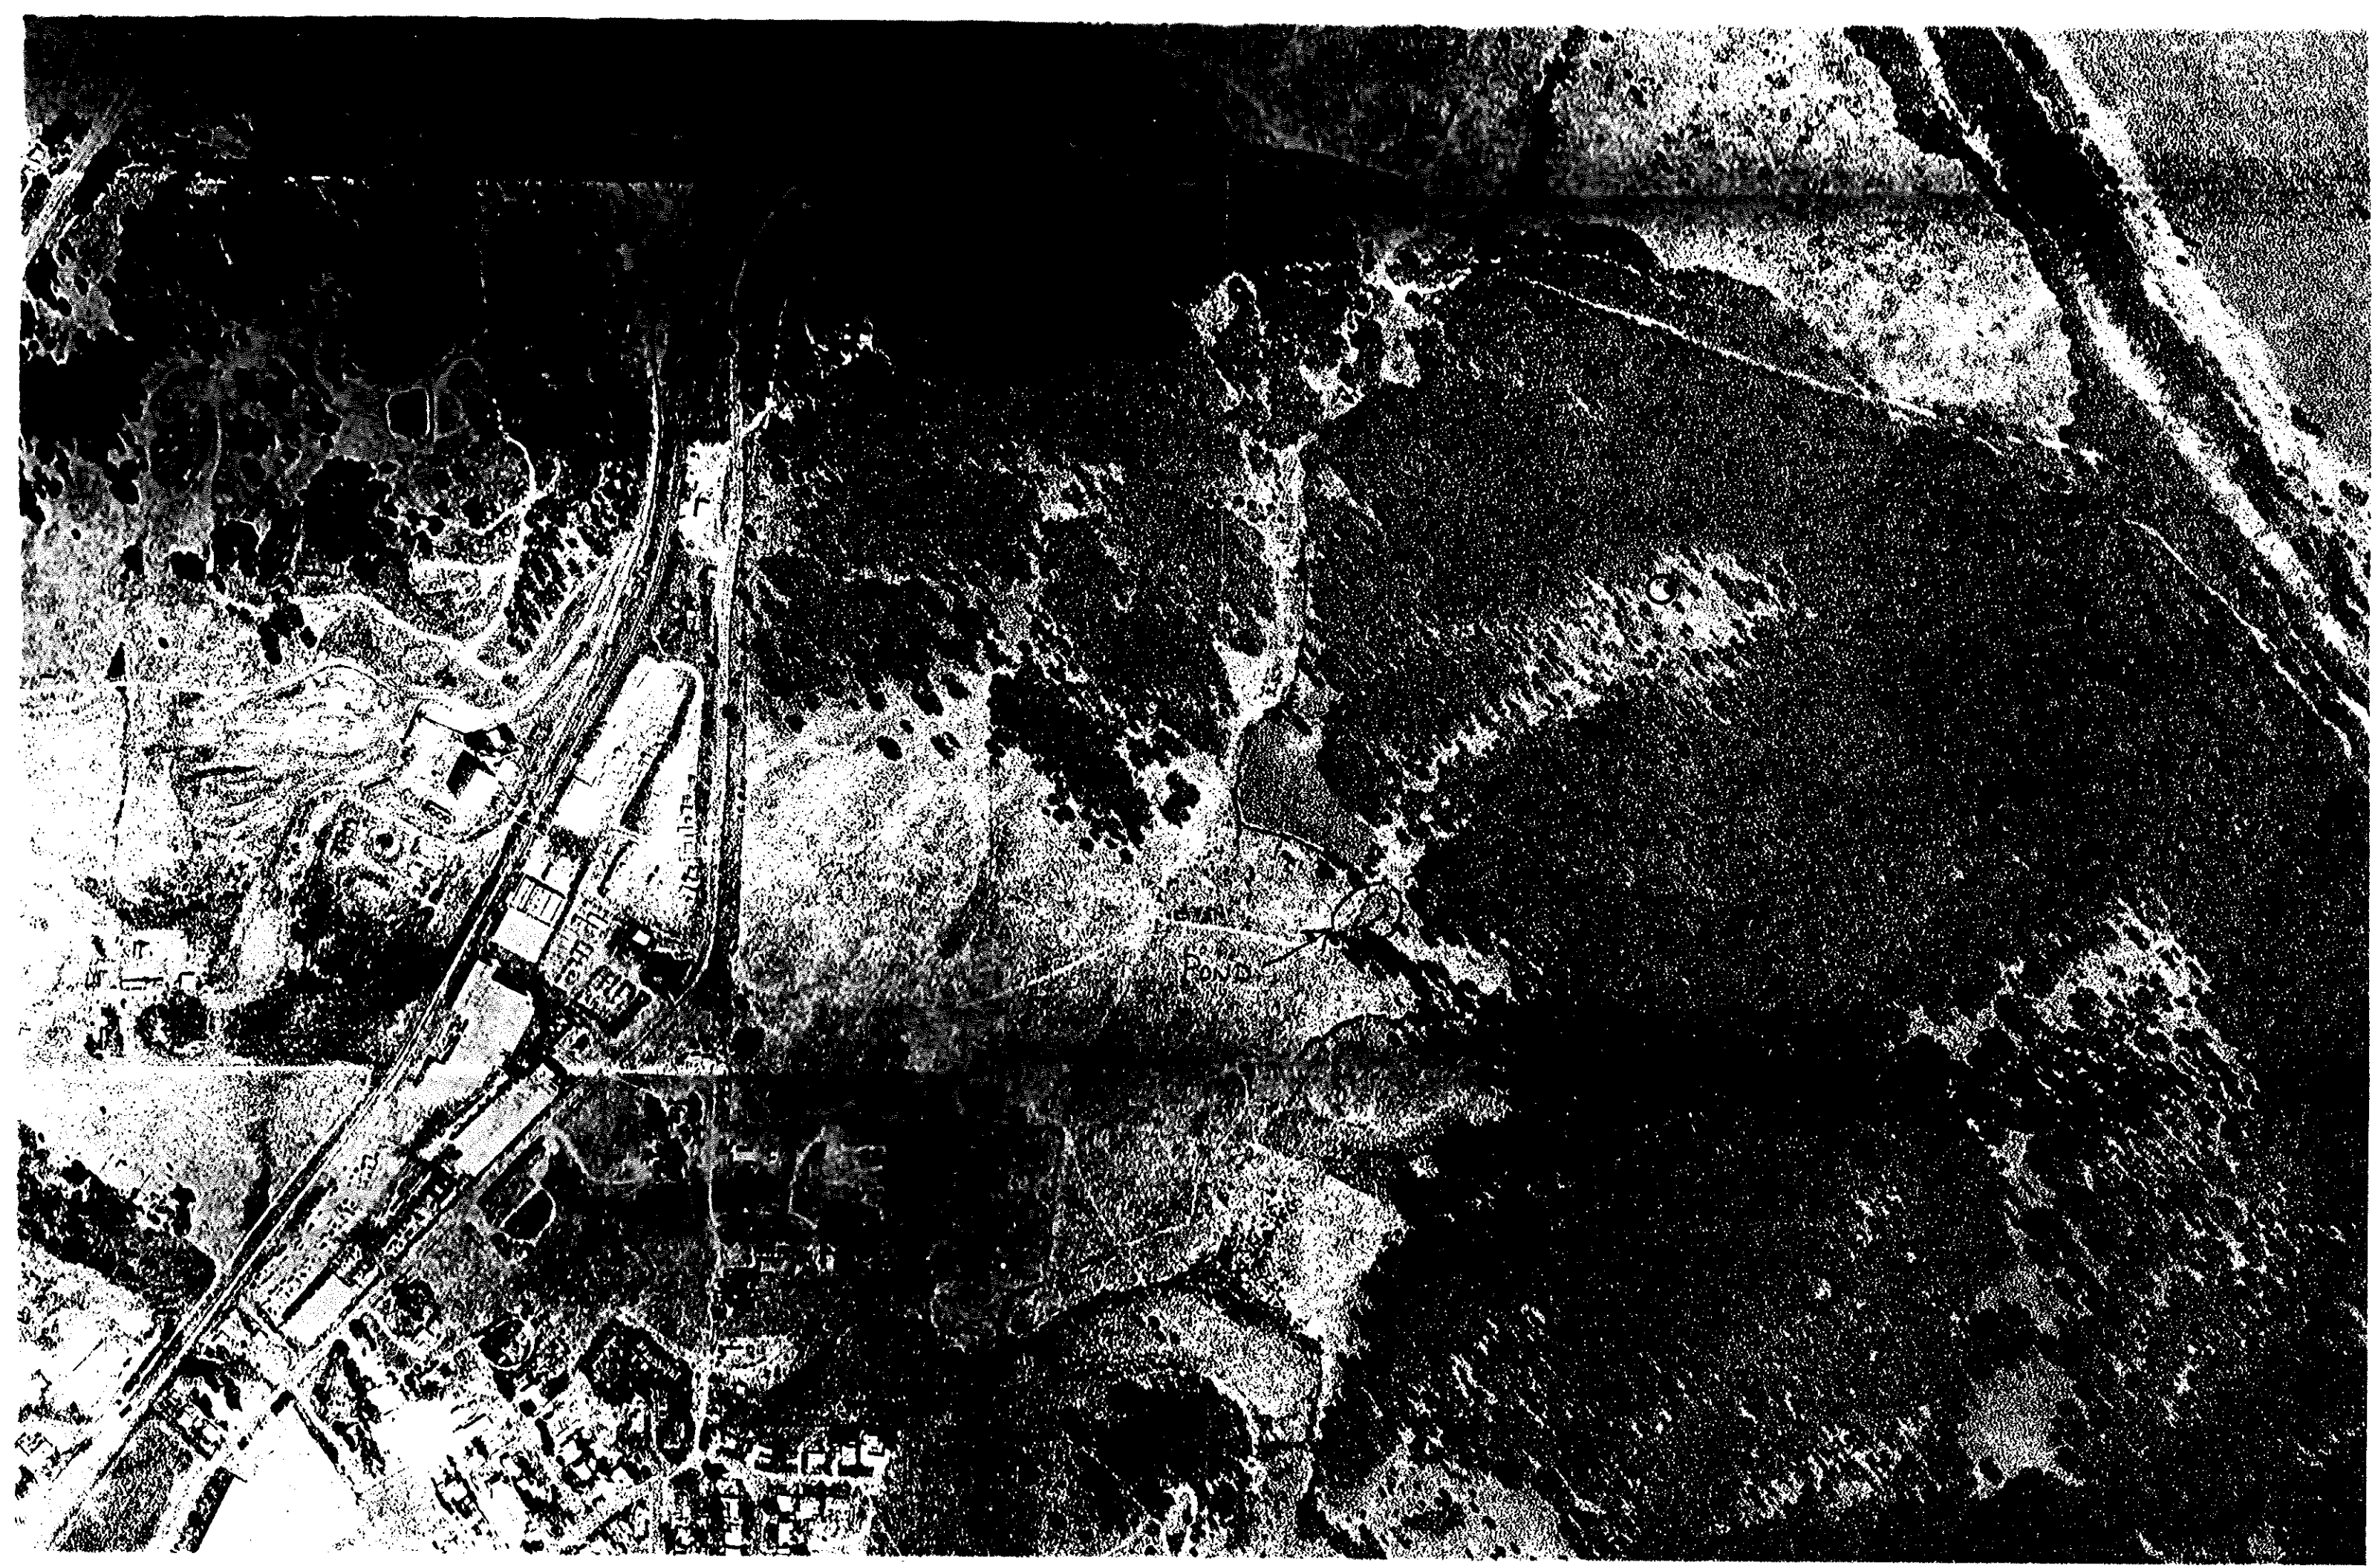

PRE-TR APPLICATION PROCESSING OUTLINE

Application File # 74622

MINIMUM REQUIREMENTS TO FILE

OAR 690-11-020

DATE STAMP

<u>DATE</u>	<u>INITIAL</u>	
_____	_____	Name and mailing address of applicant
_____	_____	Source of water
_____	_____	Quantity of water
_____	_____	Map showing location of POD & POU
_____	_____	Use of water
_____	_____	Names and addresses of legal owners
_____	_____	Signature of applicant
_____	_____	Oath
_____	_____	Application date stamped per money receipt date
_____	_____	Land use approved _____ pending _____
_____	_____	If reservoir < 5 AF \$_____, if > 5 AF \$_____
_____	_____	HB 2153/HB 2107 APPLICATION -- SEE REVERSE
_____	_____	Route to Data Center (Unless 2153/2107)

DATA CENTER

_____	_____	Stream Code _____
_____	_____	Entered into WRIS

SUPPORT SERVICES

<input checked="" type="checkbox"/>	<input checked="" type="checkbox"/>	Stamp contents with application number
<input checked="" type="checkbox"/>	<input checked="" type="checkbox"/>	Mail ack letter (provided by Data Center) with receipt to applicant, cc to CWRE and file
<u>11/22/94</u>	<u>Jh</u>	Place label on file and calender card

APPLICATION SECTION

_____	_____	Stream Indexed	Basin # _____
_____	_____	Plat Carded and copy made	<u>YES</u> <u>NO</u>
_____	_____	If dam is over 10 feet or storage exceeds 9.2 AC-FT, route file to Dam Safety Section	

TR CASEWORKER

_____	_____	TR Checklist complete	<u>YES</u> <u>NO</u>
_____	_____	Within Irrigation District	_____
_____	_____	District Notified	_____
_____	_____	District excerpt received	_____
_____	_____	TR Mailed DATE	_____
_____	_____	Public Interest Checklist complete	_____
_____	_____	Management Codes	_____

REMARKS: _____

MINIMUM APPLICATION REQUIREMENTS TO FILE:

HB 2153 - existing, small, EXEMPT ponds

Copy (date & initials) NOTICE OF EXEMPT RESERVOIR form (or letter if prior to April 8, 1994).

RECEIVED SEP 24 1994 Appropriate map (see item 1 on form).

SEP 24 1994 Evidence that reservoir existed before January 1, 1993 (one or more of the following: dated aerial photo, NOTARIZED affidavit, dated map from agency, construction receipts or other documentation).

Items 2, 3, 4, 5, and 6 are completed.

Signature (and title, if applicable)

HB 2153 - non-exempt existing ponds (large, on-channel)

Complete Minimum Requirements to File on reverse, except before routing to Data Center, change priority date to 1/1/1993. Also, confirm the following:

Receipt of evidence that reservoir existed before January 1, 1993 (one or more of the following: dated aerial photo, NOTARIZED affidavit, dated map from agency, construction receipts or other documentation)

HB 2107 - wetland, stream restoration and storm water management

Complete Minimum Requirements to File on reverse EXCEPT DO NOT ROUTE TO DATA CENTER, BUT DO ROUTE TO CAROL. Also confirm the following:

- Name/address of adjacent property owner within 1/4 mile
Map with scale not less than 2 in.=1 mi. CWRE map if > 10 feet dam or > 9.2 AF
Description of proposed use
Condition addressed
Resulting benefits

Public notices (circle) #1 #2