


THIS MAP WAS PREPARED FOR ASSESSMENT PURPOSE ONLY.

T-400

70
~~XXXXXXXXXX~~

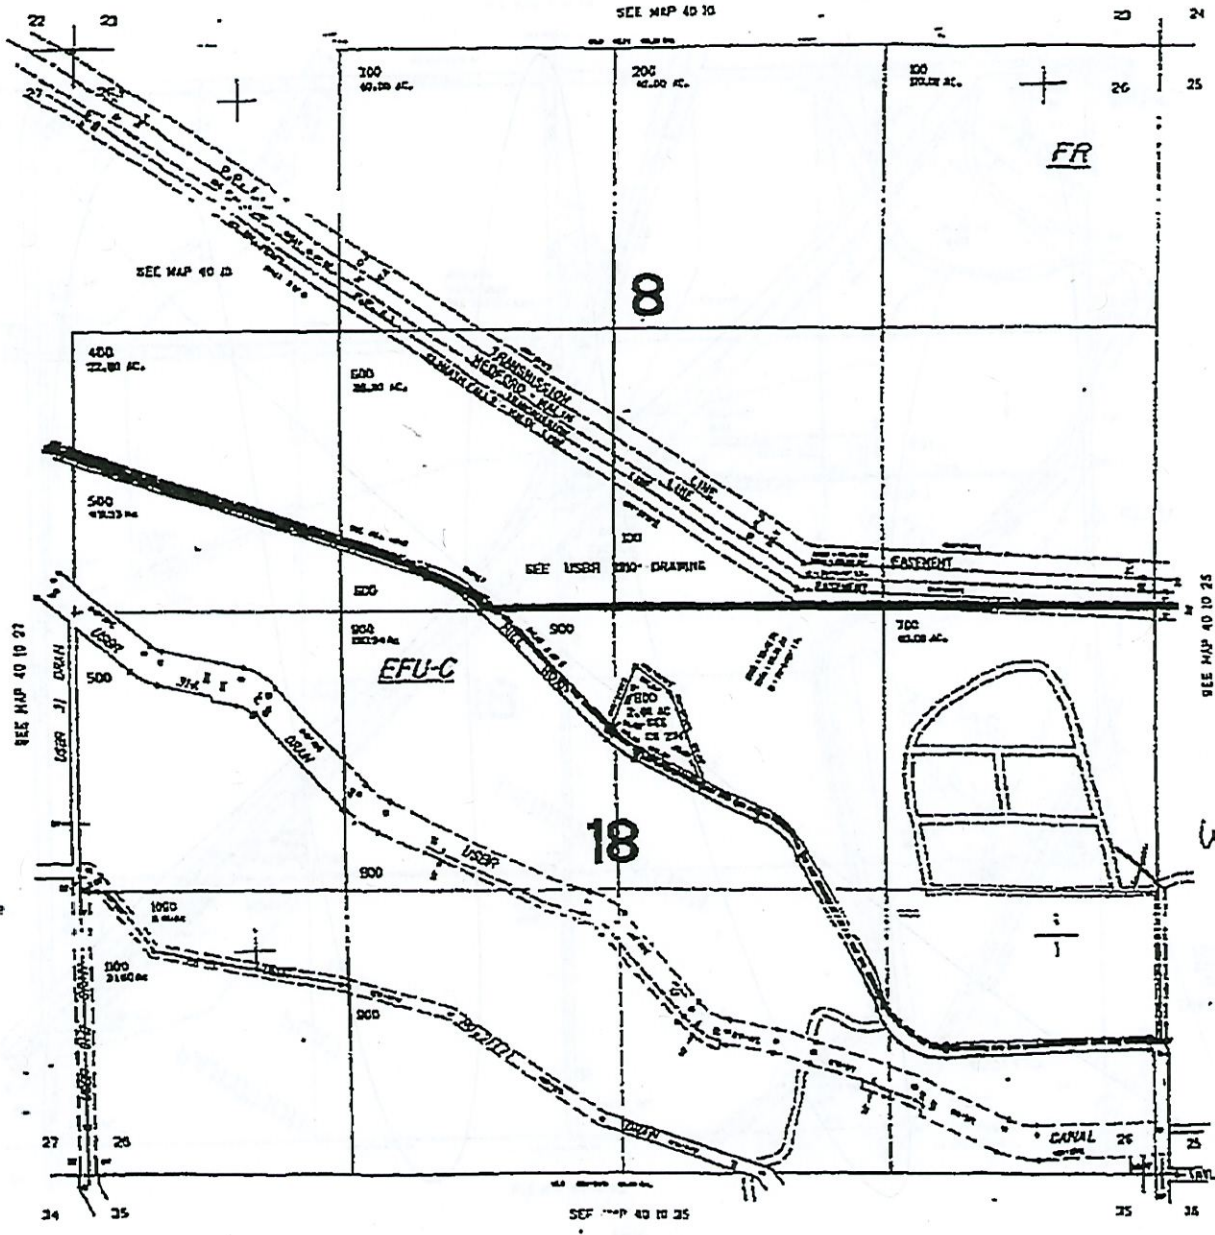

Map 1 of 7

RECEIVED
MAY 28 2020
OWRD

NORTH
T. 40 S. R. 1 E
Sec. 26

Well location
1380' NORTH of
80' West of
SE corner
Sec. 26

SEE MAP 40 TO 35

SEE MAP 40 TO 25

SEE MAP 40 TO 27

24 25

25 26

superseded

Map 1 of
40 10 26

Map created
02/05/2021


Hill
Hickey
Carleton

REVISED 04-14-15
THIS MAP WAS PREPARED FOR
ASSESSMENT PURPOSE ONLY

SECTION 26 T.40S. R.10E. W.M.
KLAMATH COUNTY
T-400°

NORTH

T40S R10E
SEC. 26

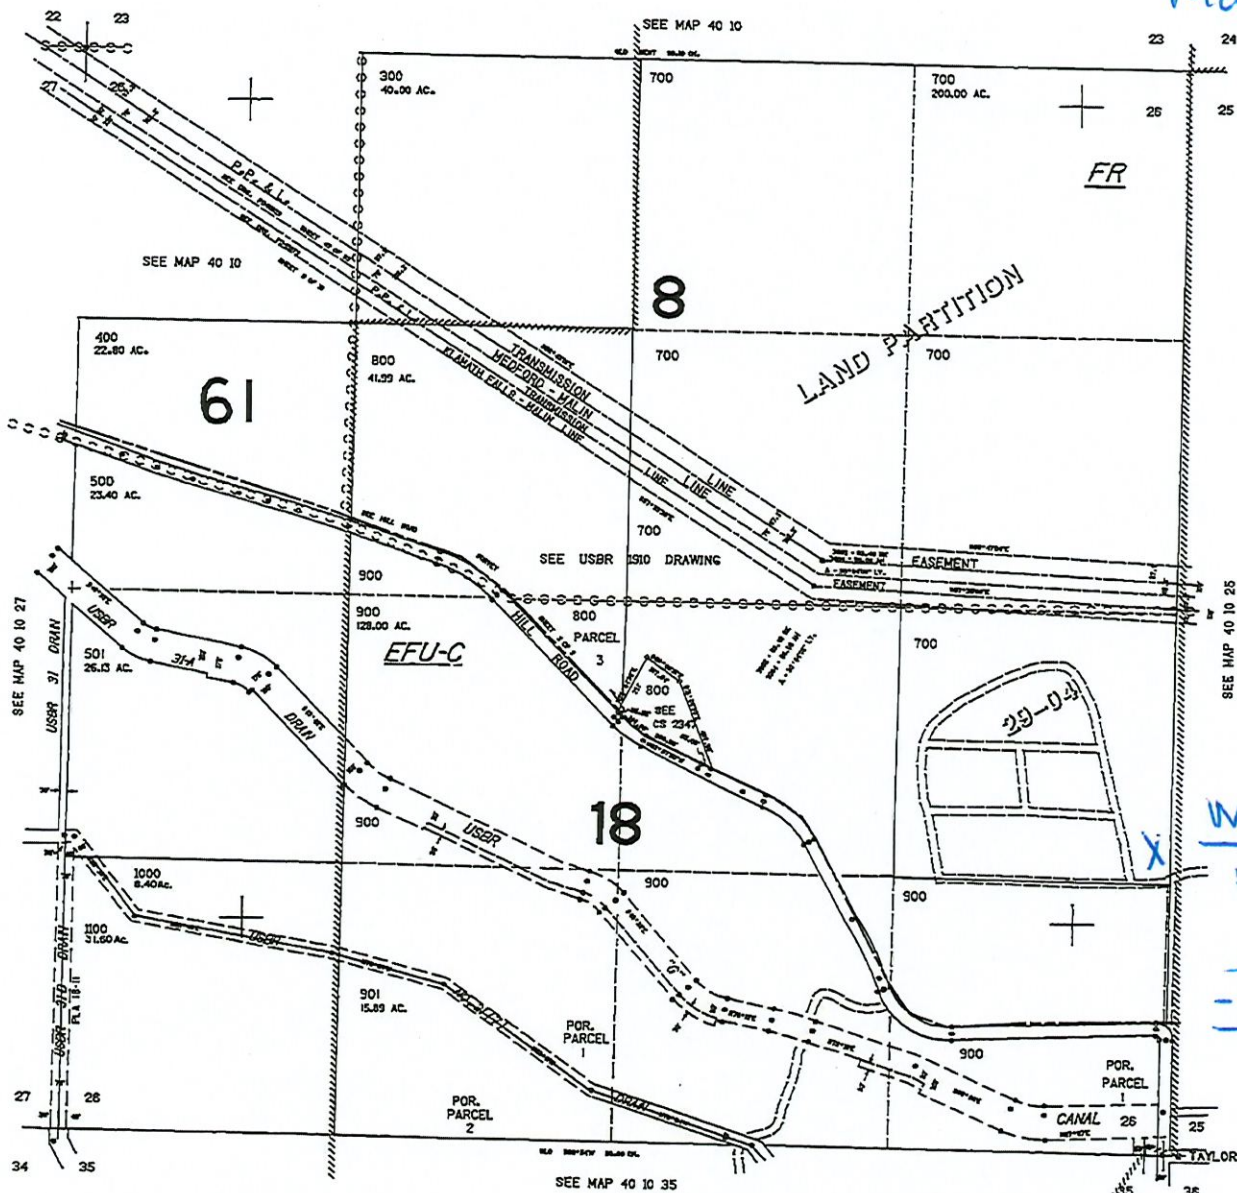

CANCELLED NO.
100
200
600

Well Location
KLAM 52932
144.000
42.0570
-121.6005

Scale
1" = 880'

RECEIVED
APR 01 2021

40 10 26 OWRD

1697000

REVISED 10-22-2019
THIS MAP WAS PREPARED FOR
ASSESSMENT PURPOSE ONLY

SECTION 08 T.40S. R.10E. W.M.
KLAMATH COUNTY
1" = 400'

Map of
40 10 08

Map created
02/23/2021

RECEIVED

APR 01 2021


OWRD

NORTH

T40 S R10E
SEC 8

Tax lot
1001-SESW 25.66
1101 SWSW 30.11

Scale
1" = 880'

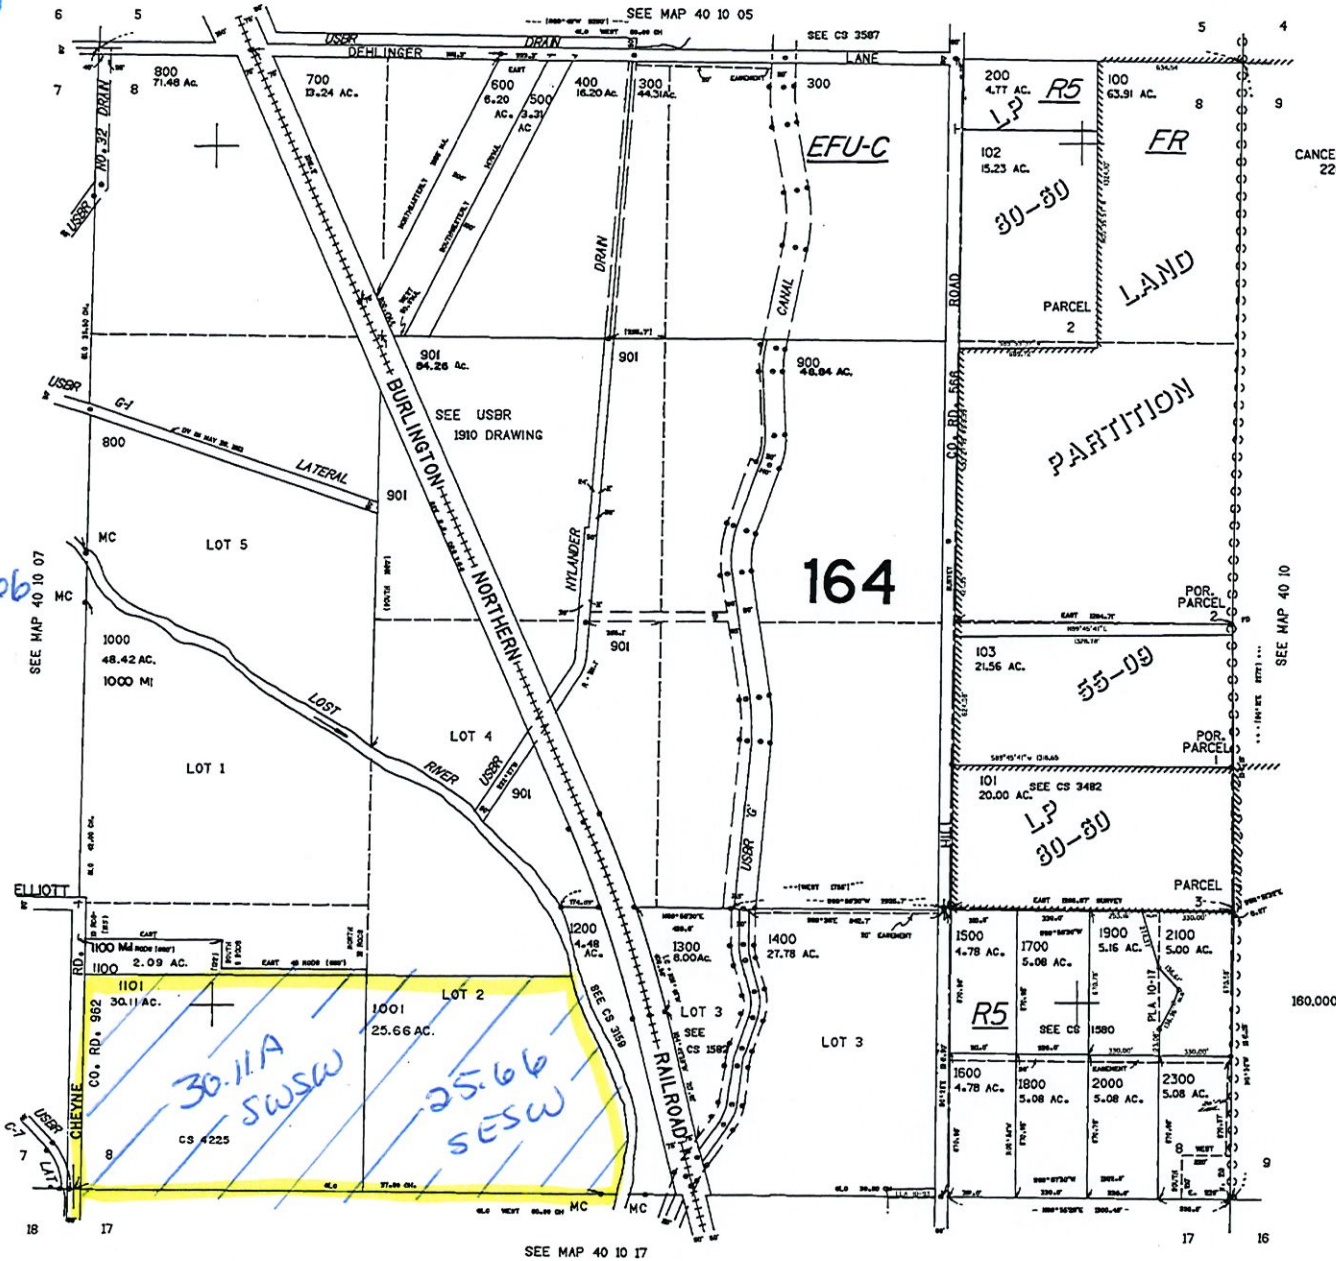

CANCELLED NO.
2200

164

SEE MAP 40 10

160.000

SEE MAP 40 10 17

40 10 08

Map of

40 10 26


Map created 02/23/2021

REVISED 04-14-15
THIS MAP WAS PREPARED FOR
ASSESSMENT PURPOSE ONLY

SECTION 26 T.40S. R.10E. W.M.
KLAMATH COUNTY

1"=400'

CANCELLED NO.
100
200
600

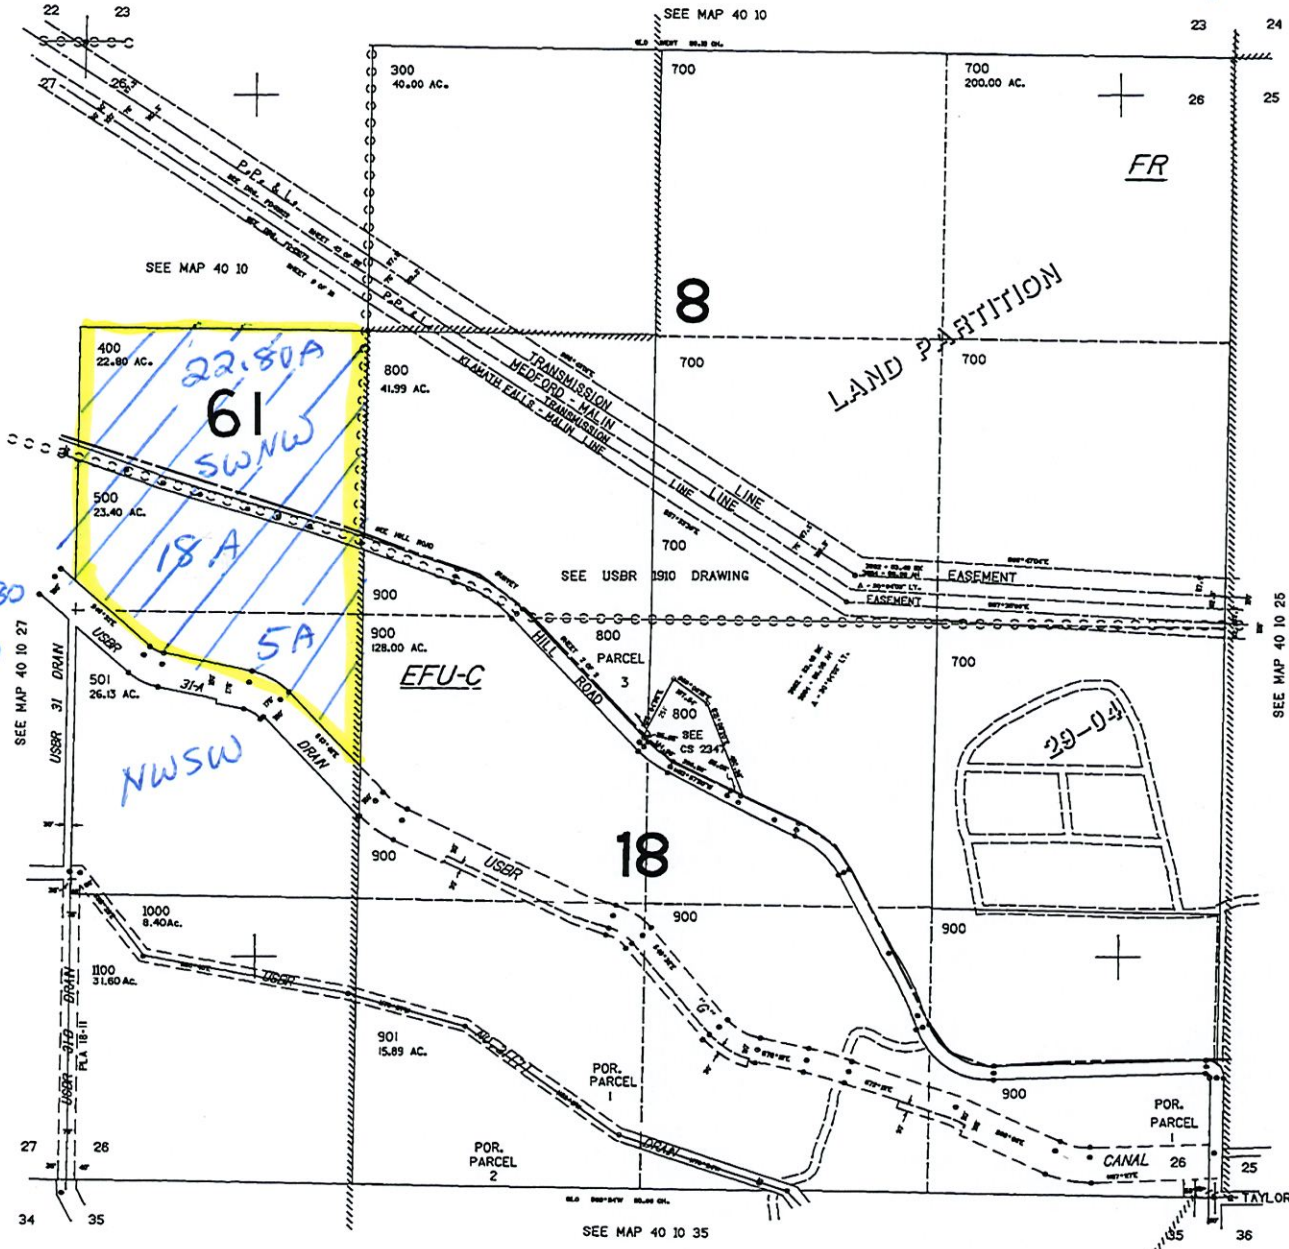

RECEIVED
APR 01 2021

OWRD

NORTH

T40S R10E
SEC 26

Tax
400 - SWNW 22.80
500 SWNW 18.0
NWSW 5.A

Scale
1" = 880'

1697.000

40 10 26


REVISED 02-12-15
THIS MAP WAS PREPARED FOR
ASSESSMENT PURPOSE ONLY

SECTION 34 T.40S. R.10E. W.M.
KLAMATH COUNTY

Map of
40 10 34
Map created
02/23/2021

RECEIVED
APR 01 2021
OWRD

NORTH
T40S R10E
SEC 34
Tax lot
700 - SENE 38.00
NESE 5.00

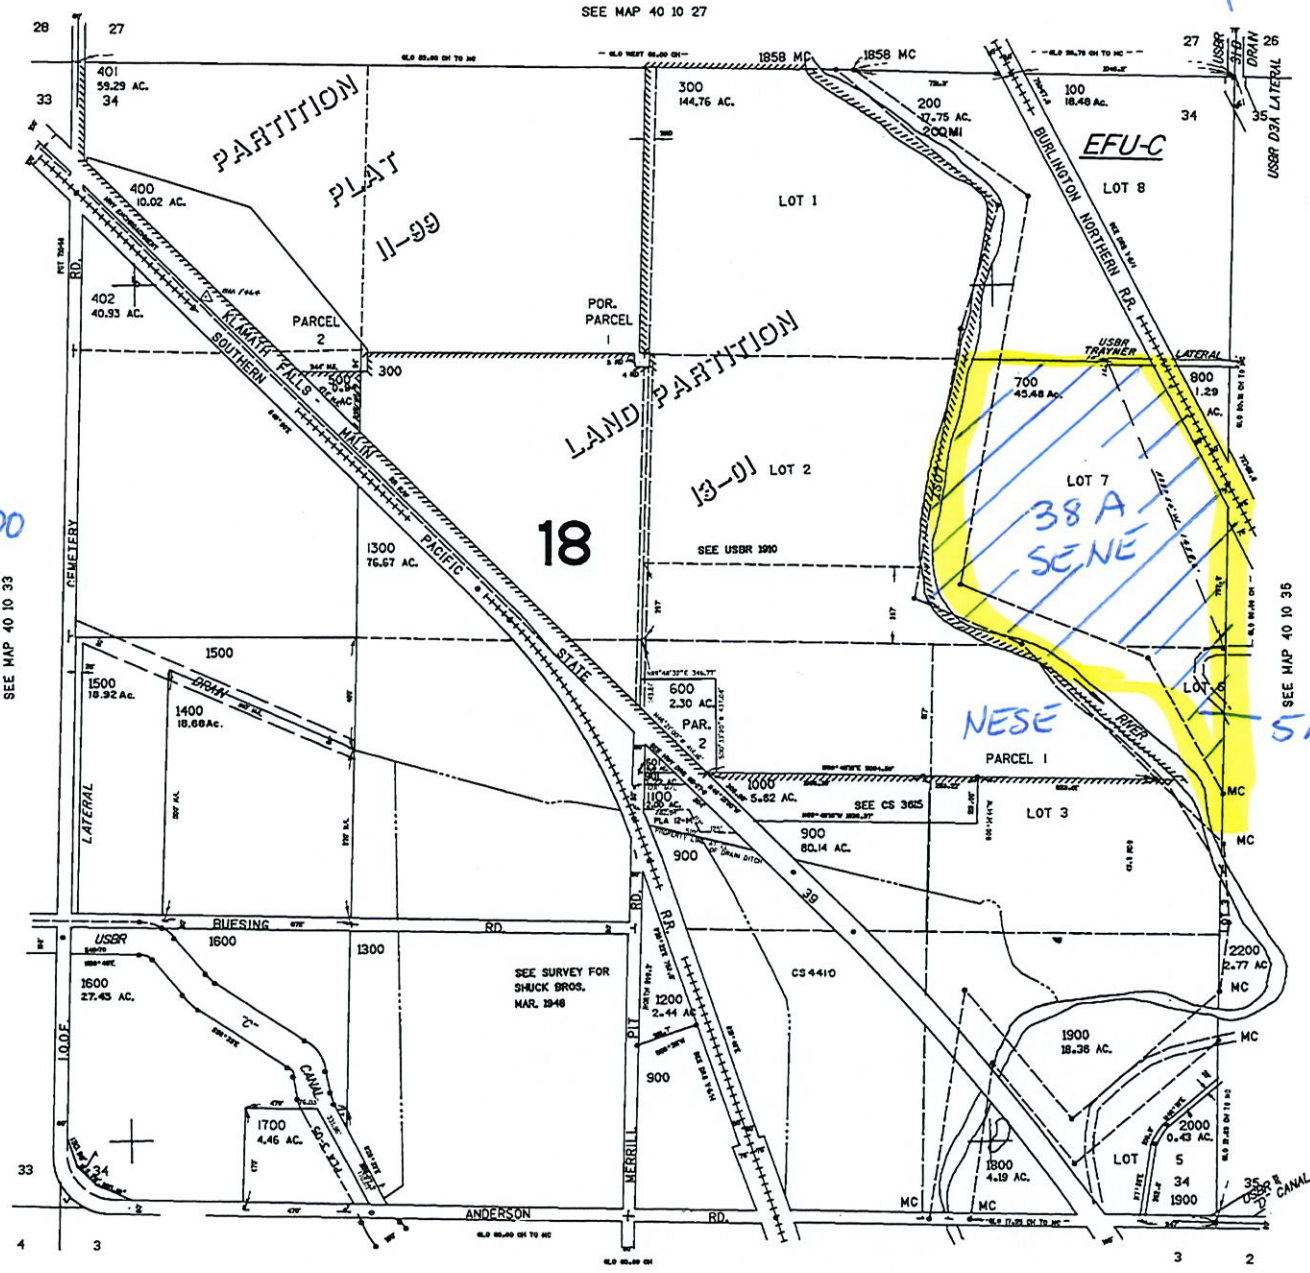

CANCELLED NO.
301
2100 A1
2300A1

Scale
1" = 880'

SEE MAP 41 10 03

40 10 34

Map of
40 10 35
Map created
02/23/2021


REVISED 9-15-08
THIS MAP WAS PREPARED FOR
ASSESSMENT PURPOSE ONLY

SECTION 35 T.40S. R.10E. W.M.
KLAMATH COUNTY
1"=400'

RECEIVED
APR 01 2021
OWRD
NORTH

T40 S R10E
SEC. 35
Tax lot

| | | |
|------|------|-------|
| 700 | SWNW | 2.00 |
| 800 | NWSW | 15.74 |
| 800 | NWSW | 5.14 |
| 1000 | SWSW | 35.57 |
| 1100 | SESW | 4.12 |
| 1200 | NESW | 0.79 |
| 1200 | SESW | 31.00 |
| 1300 | NESE | 38.0 |
| 1300 | NWSE | 12.00 |

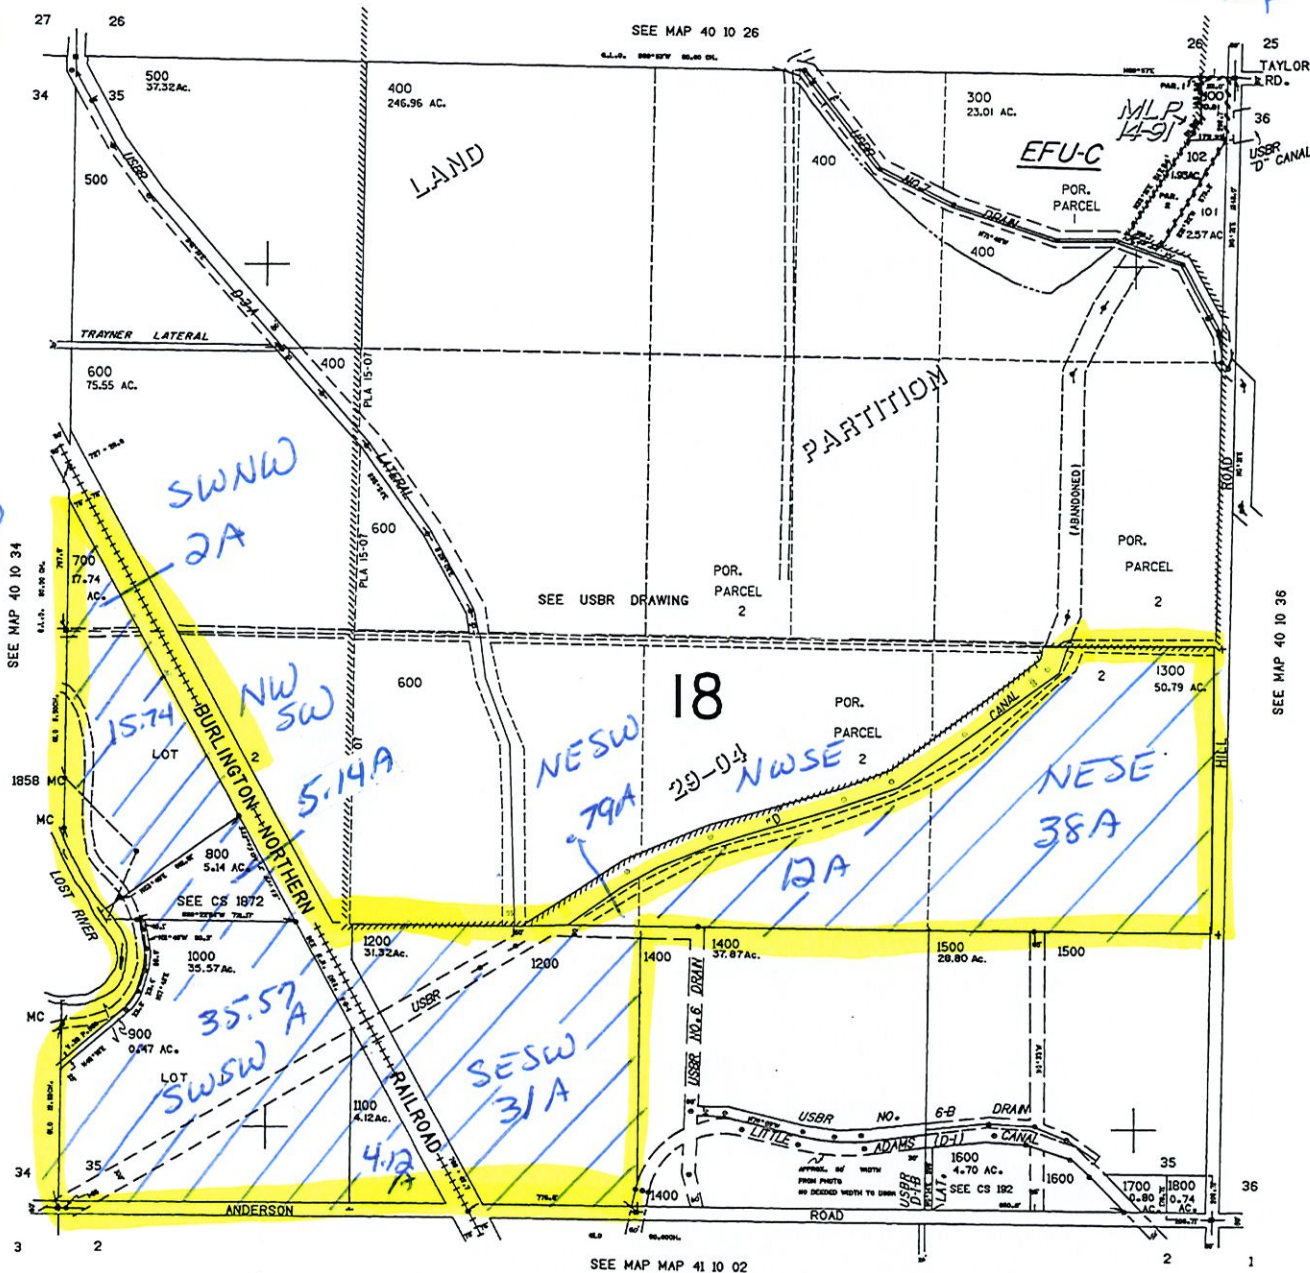

CANCELLED NO.
200
1301

138.000

1667,000

40 10 35

RECEIVED

APR 01 2021

OWRD

Map of

40 10 36


Map created
02/23/2021

SECTION 36 T.40S. R.10E. W.M.
KLAMATH COUNTY

1"=400'

SEE MAP 40 10 25

THIS MAP WAS PREPARED FOR
ASSESSMENT PURPOSE ONLY.

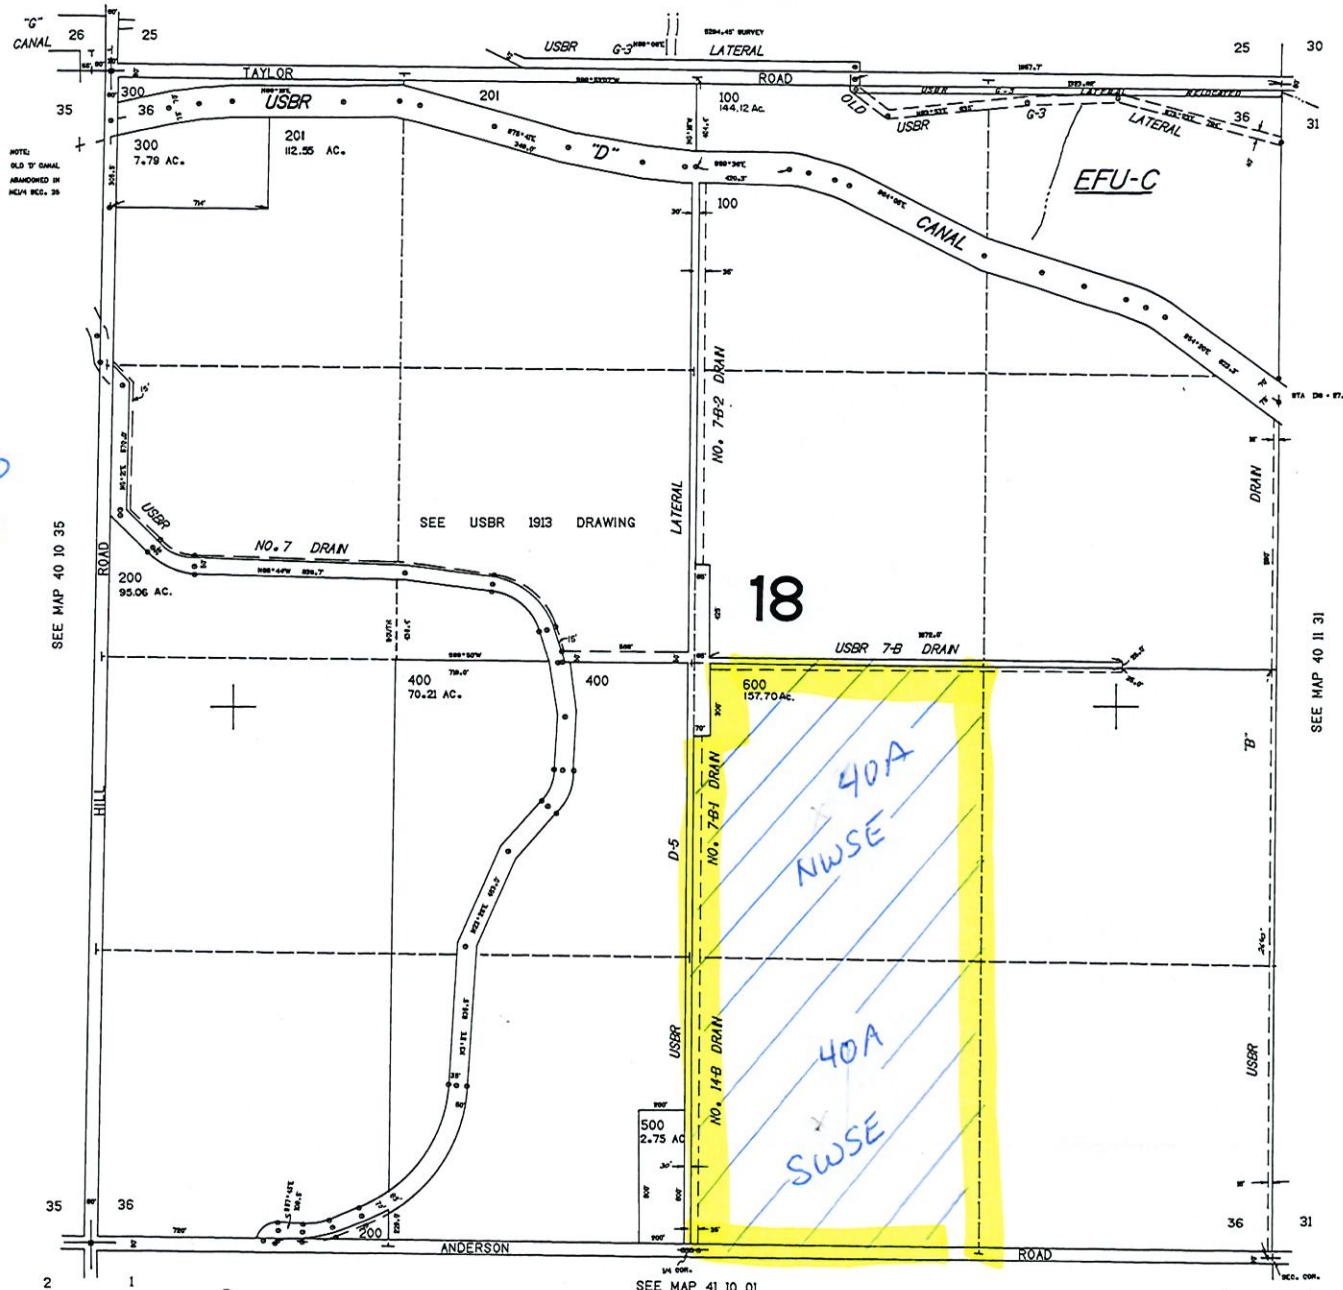

NORTH

T40S R10E
SEC. 36

Tax lot
600 NWSW 40.0
SWSE 40.0

Scale

1"=880'

SEE MAP 40 11 31

140,000

SEE MAP 41 10 01

40 10 36

RECEIVED

APR 01 2021

OWRD

NORTH

T40S R11E

SEC 31

Tax lot

100 NENE 40.0

NWNE 40.0

SWNE 35.0

SENE 38.0

NWSE 25.0

600 NESE 40.0

SESE 35.40

Scale

1" = 880'

Map of


40 11 31

Map created 02/23/2021

SECTION 31 T.40S. R.11E. W.M.
KLAMATH COUNTY

1"=400'

THIS MAP WAS PREPARED FOR
ASSESSMENT PURPOSE ONLY.

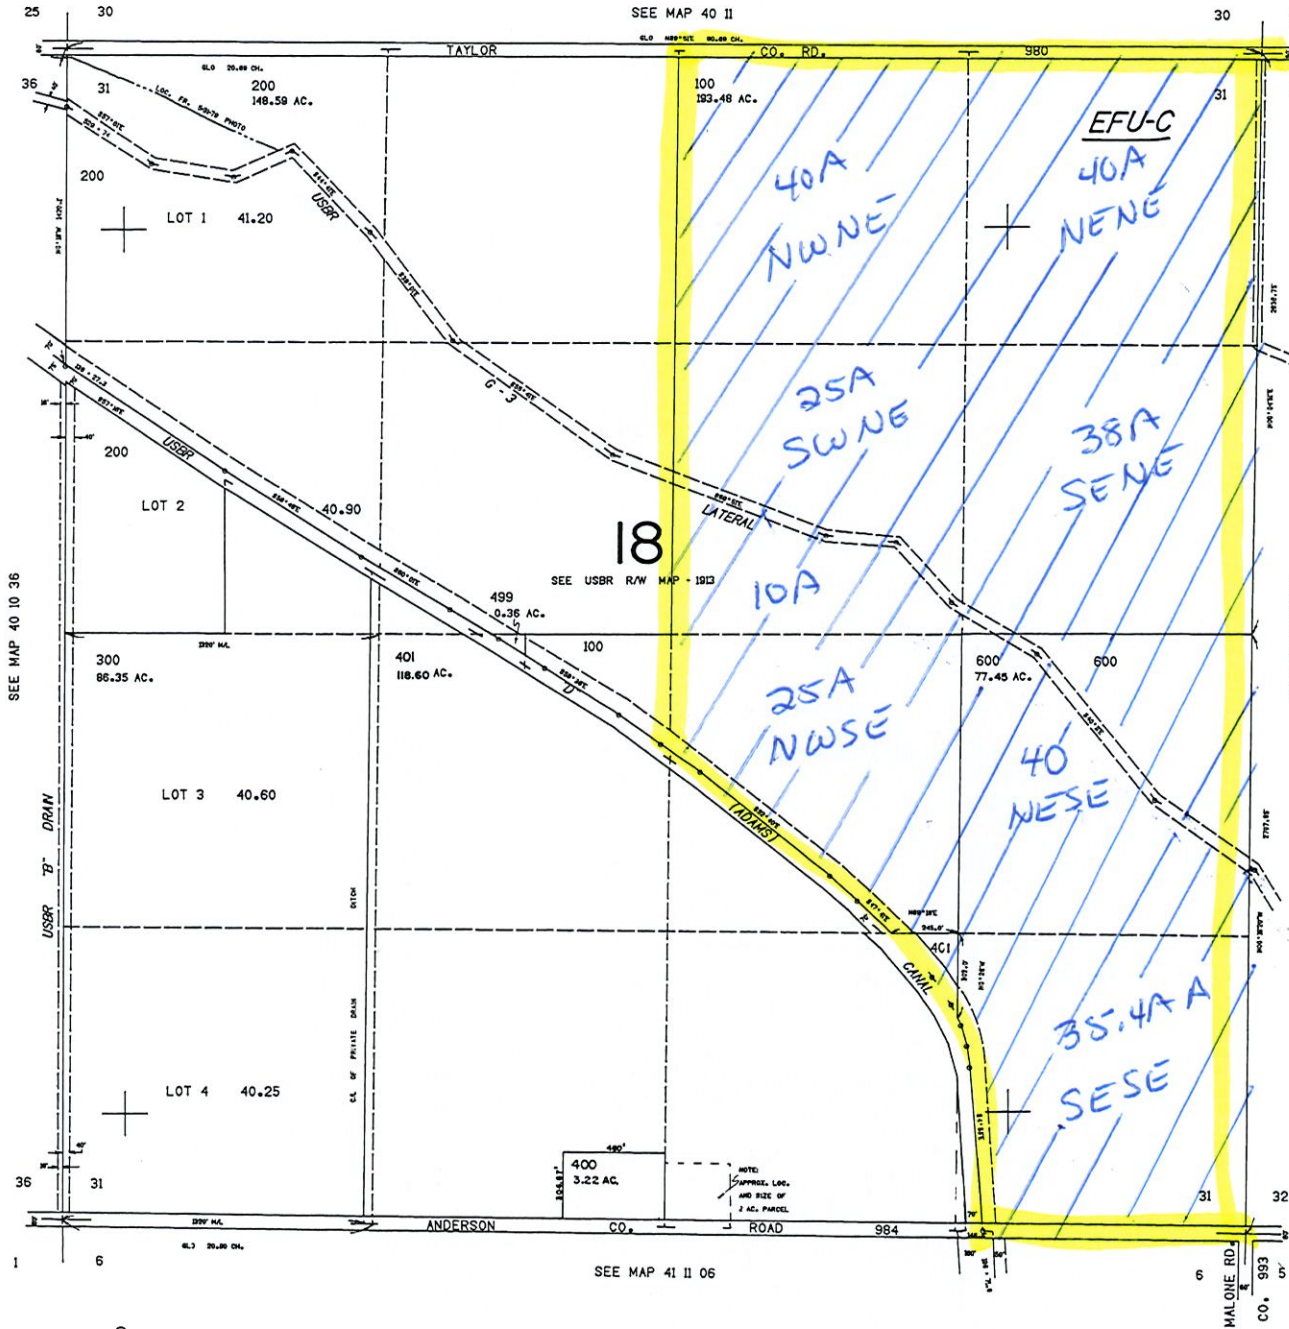

138,000

40 11 31

Map of
40 11 32
Map created
02/23/2021

REVISED 05-03-2017
THIS MAP WAS PREPARED FOR
ASSESSMENT PURPOSE ONLY


SECTION 32 T.40S. R.11E. W.M.
KLAMATH COUNTY
1" = 400'

RECEIVED
APR 01 2021
OWRD

NORTH

T40S R11E
SEC. 32
Tax lot
1300 NWSW
15.00

Scale
1" = 880'

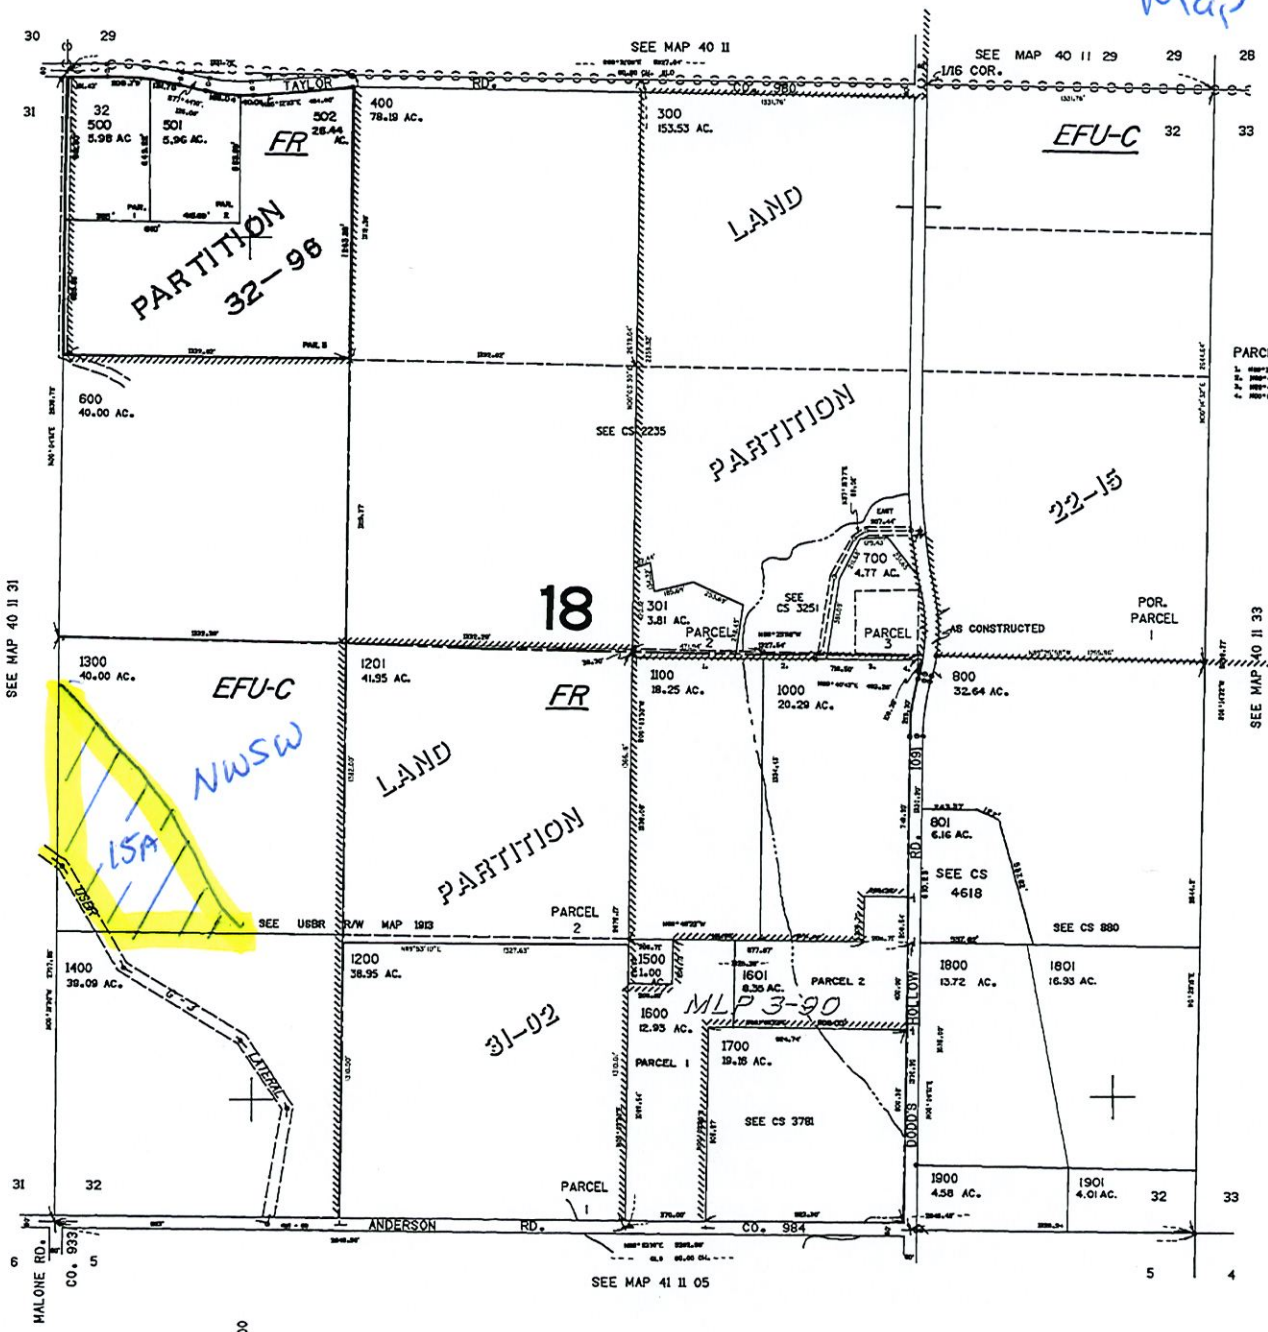

CANCELLED NO.
100
200

PARCEL 300

138,000

Map of

41 10 01
& INDEX
MERRILL

Map created
02/23/2021


REVISED 09-24-14
THIS MAP WAS PREPARED FOR
ASSESSMENT PURPOSE ONLY

SECTION 01 T.41S. R.10E. W.M.
KLAMATH COUNTY
1"=400'

RECEIVED
APR 01 2021
OWRD
NORTH

T41S R10E
SEC. 01
Tax lot
200 NENW 40.00
NWNW 34.00

Scale
1"=880'

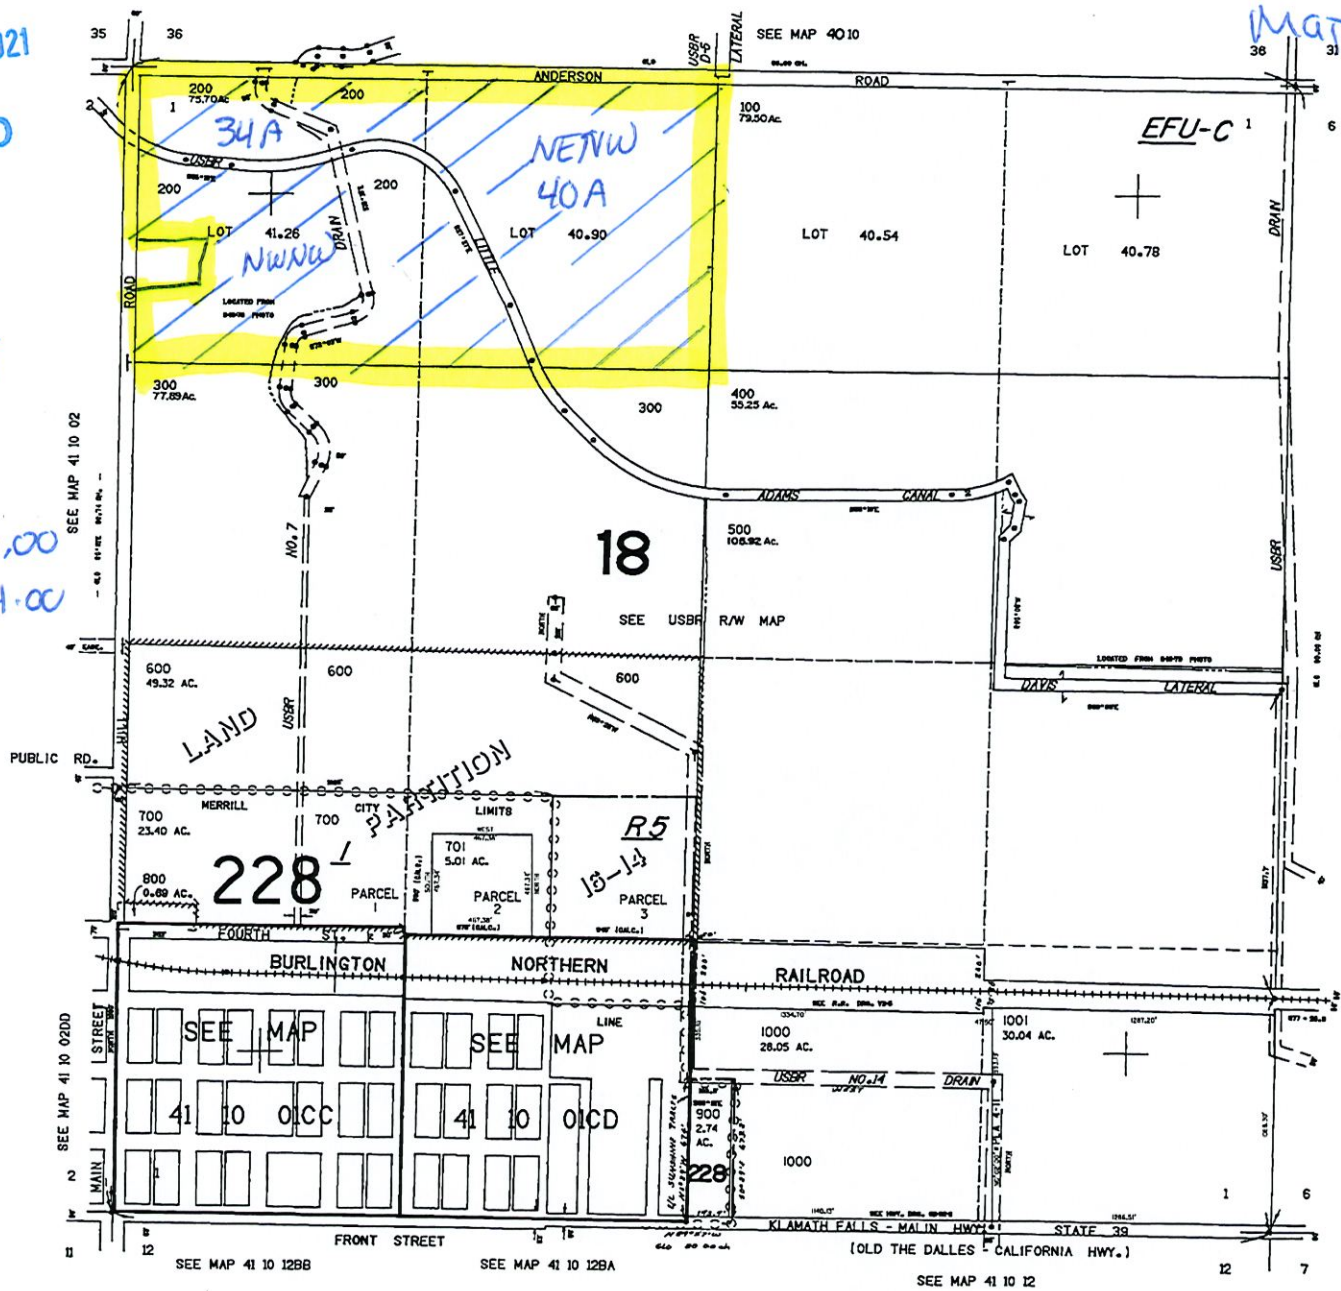

SEE MAP 41 11 06

133.000

41 10 01
& INDEX
MERRILL

02.000

Map of

41 11 01

Map created 02/23/2021

REVISED 05-17-2016
THIS MAP WAS PREPARED FOR
ASSESSMENT PURPOSE ONLY

SECTION 01 T.41S. R.11E. W.M.
KLAMATH COUNTY
1"=400'

RECEIVED
APR 01 2021
OWRD


NORTH

THIS R1E
SEC. 01

Tax lot

| | |
|----------|-------|
| 800 NENW | 30.00 |
| NWNW | 8.00 |
| SWNW | 10.00 |
| SESW | 36.00 |
| NESW | 38.00 |
| NWSW | 3.00 |

Scale
1" = 880'

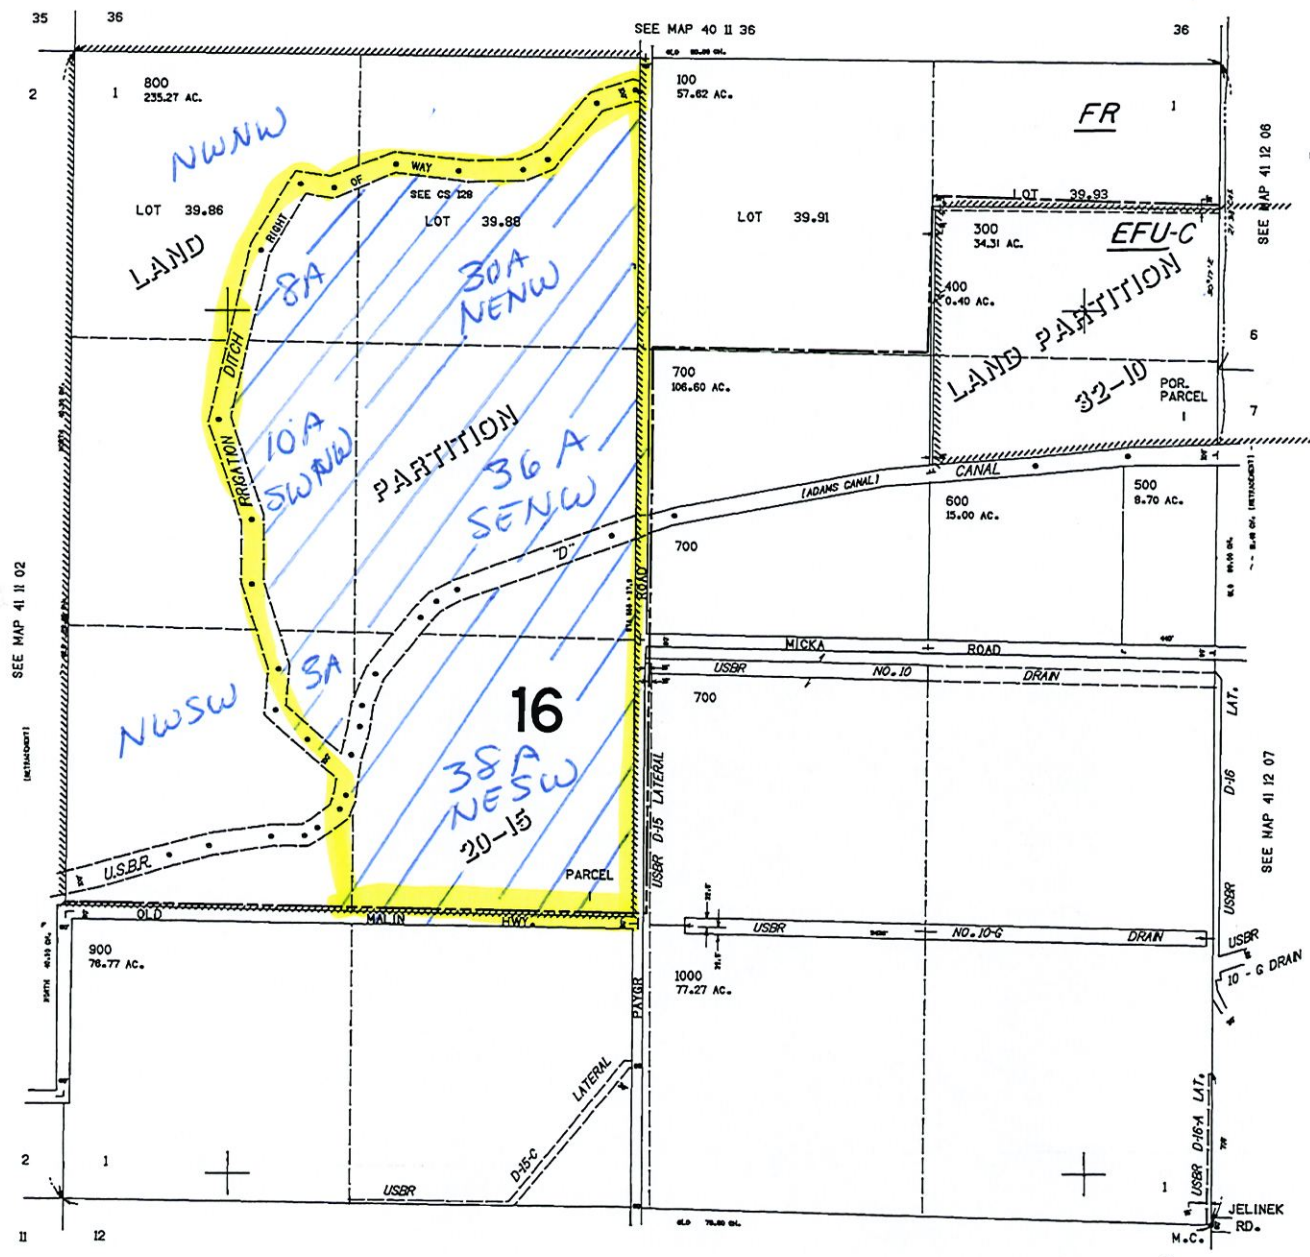

CANCELLED NO.
200

132,000

SEE MAP 41 11 12

41 11 01

SEE MAP 41 11 02

SEE MAP 41 12 06

SEE MAP 41 12 07

SEE MAP 41 12 07

.734,000

Map of.


41 II 10

Map created 02/23/2001

REVISED 06-06-14
THIS MAP WAS PREPARED FOR ASSESSMENT PURPOSE ONLY

SECTION 10 T.41S. R.11E. W.M.
KLAMATH COUNTY

1"=400'
SEE MAP 41 II 03

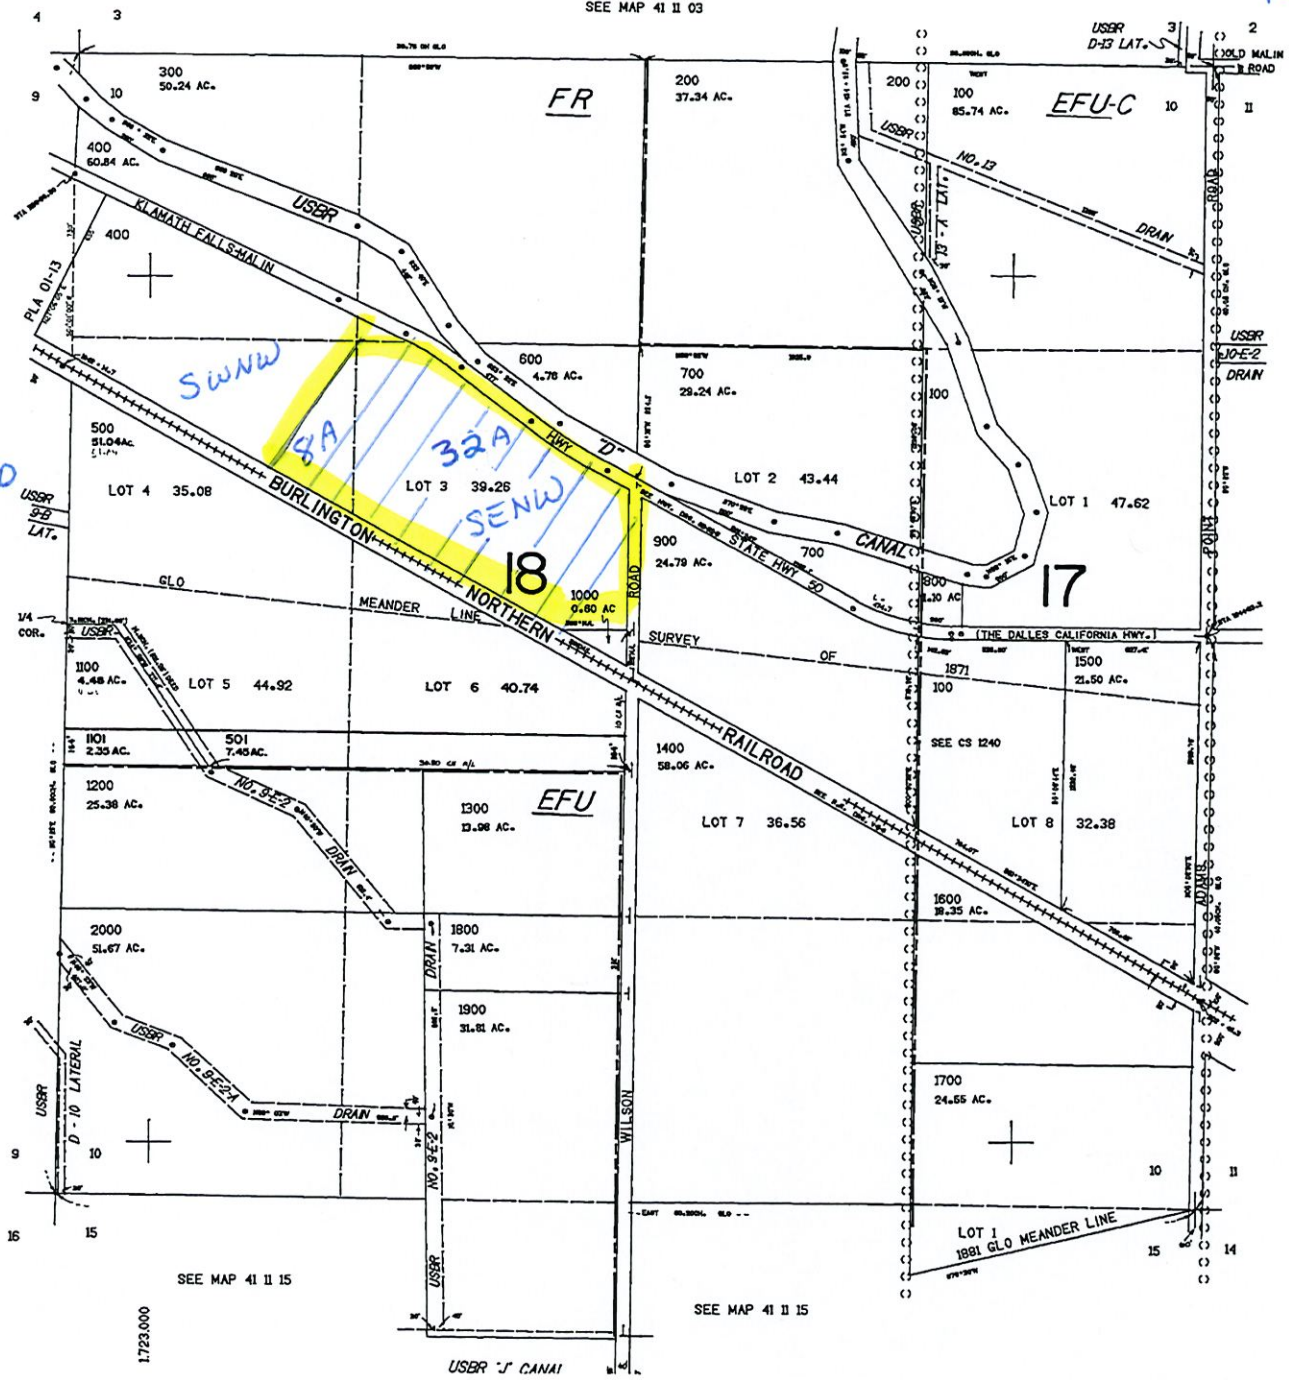

RECEIVED

APR 01 2021

OWRD

NORTH

THIS R11E
SEC. 10

Tax lot
400 SWNW 8.00
SEnw 32.00

Scale
1" = 880'

SEE MAP 41 II II

127,000

41 II 10

Map of

41 11 12

Map created 02/23/2021

SECTION 12 T.41S. R.11E. W.M.
KLAMATH COUNTY

1"=400'

THIS MAP WAS PREPARED FOR
ASSESSMENT PURPOSE ONLY.

RECEIVED

APR 01 2021

OWRD

NORTH

T41S R11E
SEC. 12


Tax lot

1100 NESW 8.09
NWSW 8.81

1500 SESW 39.95
SWSW 40.00

Scale

1" = 880'

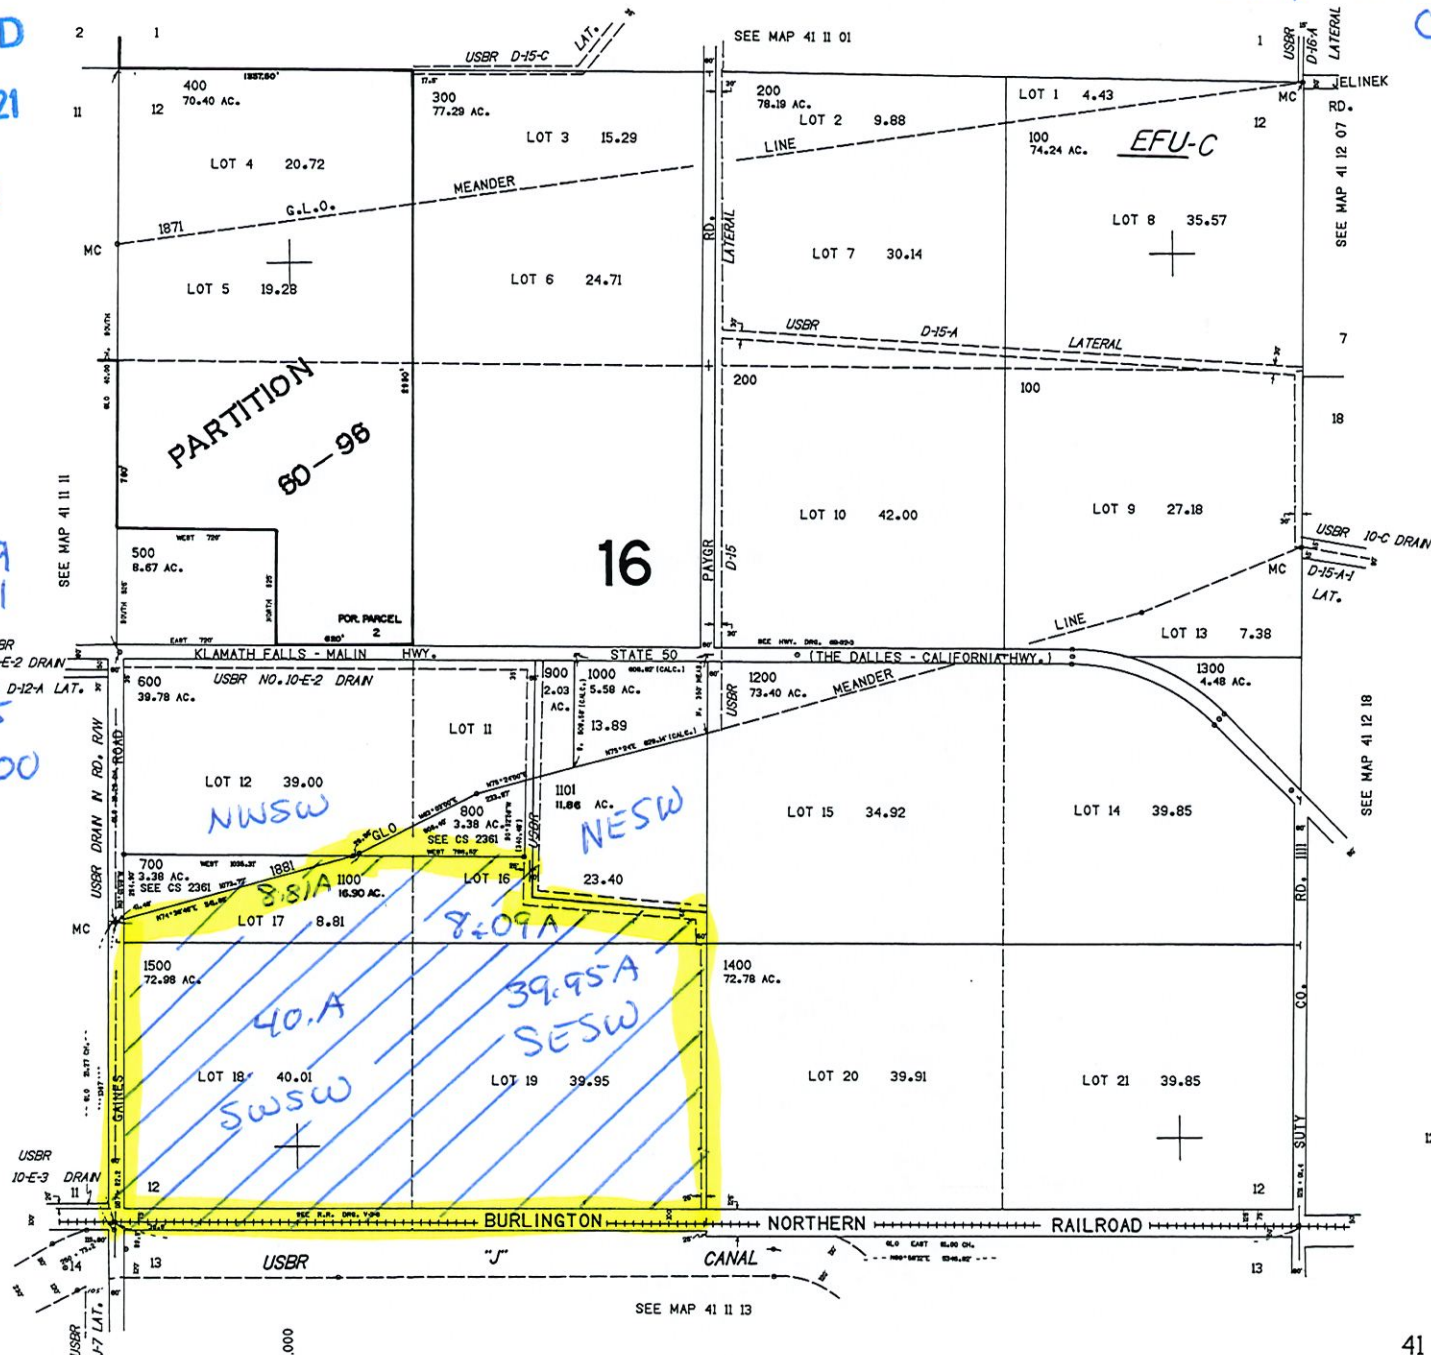

127,000

41 11 12