


RECEIVED

SEP 22 1989

WATER RESOURCES DEPT.
SALEM, OREGON

T.9 S. R.1 E., W.M.

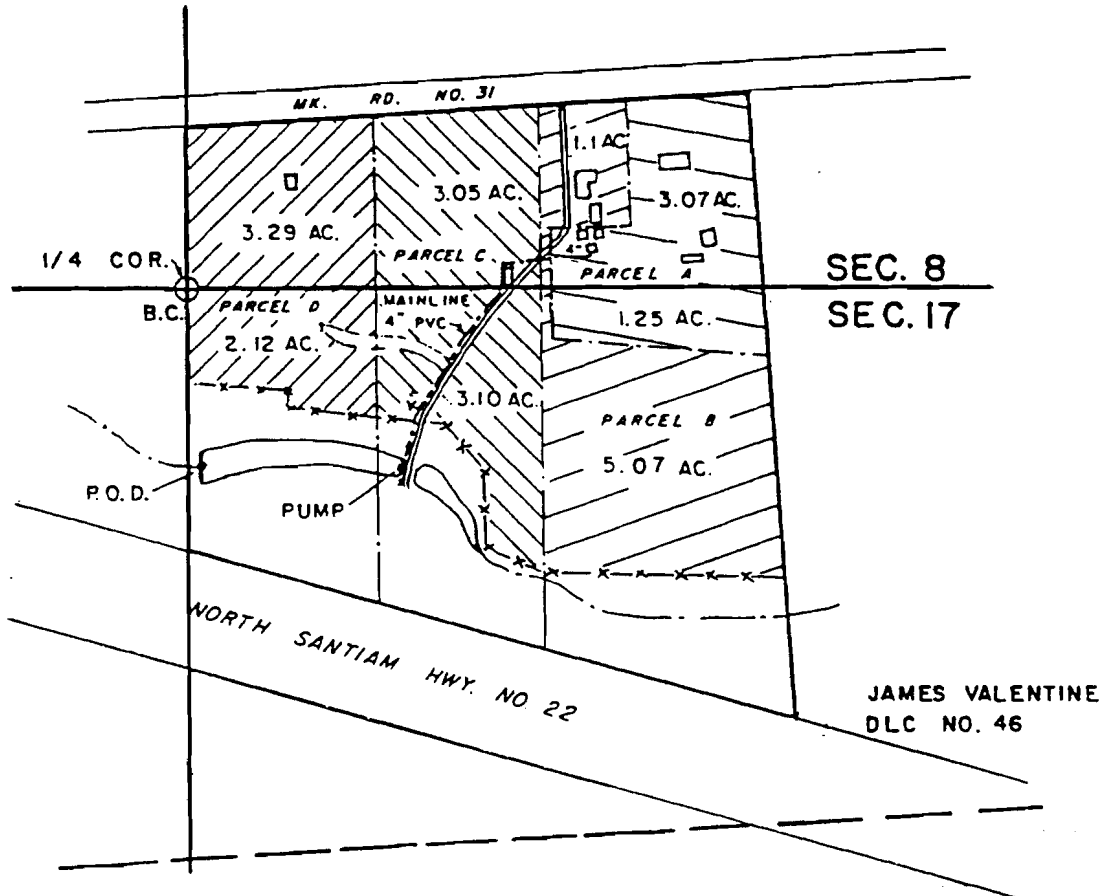

PUMP LOC. 380' S. & 450' E. FROM B.C. AT 1/4 COR.
 P.O.D. LOC. 370' S. & 30' E. FROM B.C. AT 1/4 COR.

FINAL PROOF SURVEY
 UNDER

R-72886


R-11600

Application No. 72887 Permit No. 51834

IN NAME OF

CECELIA R. FERY


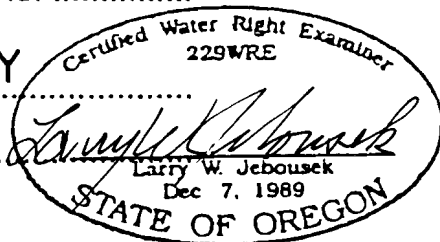

THIS MAP WAS PREPARED FOR THE PURPOSE OF IDENTIFYING THE LOCATION OF A WATER RIGHT ONLY AND IS NOT INTENDED TO PROVIDE LEGAL DIMENSIONS OR LOCATION OF PROPERTY OWNERSHIP LINES.