


T.7S.R.1E.W.M.

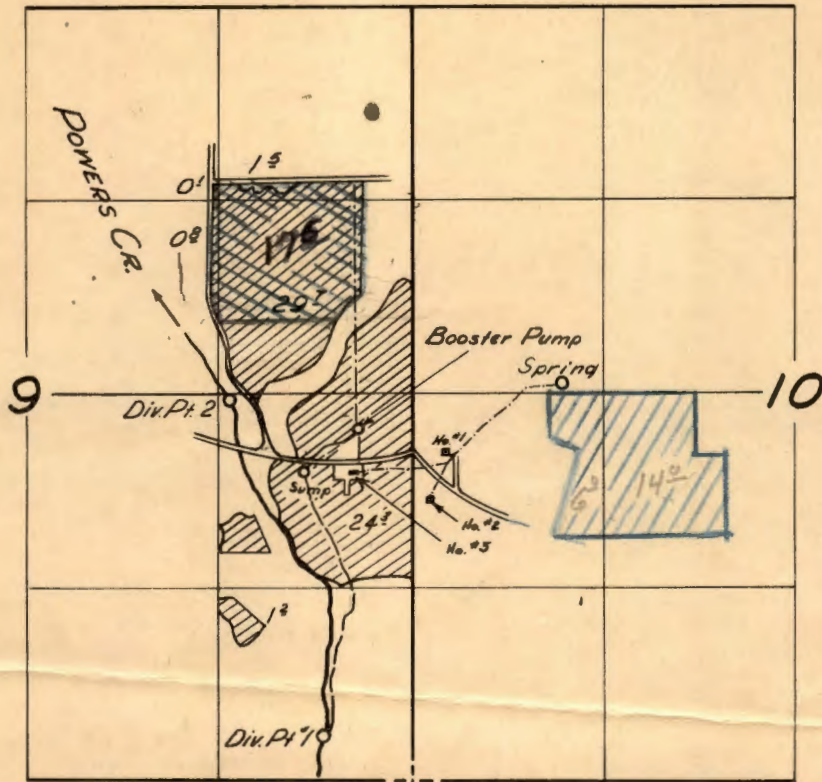

Water right Transferred from



Water right Transferred to

FINAL PROOF SURVEY

UNDER

Application No. 19206 Permit No. 14800

IN NAME OF

FRANK E. GILPATRICK

Surveyed 24 May 1956, by C. B. Kelly