Certificate Checklist for Qualifying Reservoirs

Under ORS 537.409(10)(11) (COBU by Permittee for "Alternative Reservoirs)
(Must be less than 9.2 acre feet)

File No. R 96958	File Marked		
Date Rec'd. 3/29/2021 (frees)	Claim Logged		
Reviewer	Peer Review		
Intake Cl	hecklist		
Does a secondary permit exist for use of water under UYES INO (If "Yes", this self certification cannot be the reservoir and the secondary use permit.)	r this permit at the time of this submittal? e accepted. The Claim must be prepared by a CWRE for both		
Are reservoir dimensions included? ØYES 🗆 I	NO		
Signed by all permittees? A YES - NO (Must be	e signed by all permittees. If not, Assignment may be needed).		
Was a map included? XIYES INO (Must Identify Location of the Reservoir)			
Processing Notes and Conclusions			
The <u>Claimed</u> maximum capacity of the reservoir in acre feet is:			
The <u>Permitted</u> capacity of the reservoir in acre feet i	s:		
Is this reservoir located within an "Area of Interest"? YES INO			
Identified Party			
Current Ownership Check: Does the County Assessor indicate that there is a ne (If new owners, indicate name and mailing address below)	w landowner?		
,			
Issue: PROPOSED (If fewer acre feet were develop	ed than were permitted)		
□ CERTIFICATE #			

CLAIM OF BENEFICIAL USE for Reservoirs storing less than 9.2 acre-feet permitted under ORS 537.409



Oregon Water Resources Department 725 Summer Street NE, Suite A Salem, Oregon 97301-1266 (503) 986-0900

www.oregon.gov/OWRD

RECEIVED

KAR 08 2021

A fee of \$200 must accompany this form. The Claim will be returned if the fee is not included. OWRD

This form may be completed by the permit holder of record if:

- 1) The permit was issued under the authority of ORS 537.409; and
- 2) No secondary permit exists for the use of water stored in the reservoir; and
- 3) The developed capacity of the reservoir is less than 9.2 acre-feet; and
- 4) The water was stored by the date required in the permit; and

A separate form shall be completed for each permit.

This form must be submitted to the Water Resources Department within one year of storage of water in the reservoir.

Please type or print in dark ink. If the data provided is found to contain errors or omissions, it may be returned. The Department may require the submittal of additional information.

If you have questions regarding the completion of this form, please call 503-986-0900 and ask for the Certificate Section.

SECTION 1

GENERAL INFORMATION

File Information:

APPLICATION # R-2-86959	PERMIT # R- 2 4513	
-------------------------	----------------------	--

Applicant Information:

APPLICANT NAME		PHONE NO.		ADDITIONAL CONTACT NO.	
Anne V UN Ceret		641621	15692	541 899 7467	
ADDRESS 1247 Panther Gu	Ich Rel				
CHY	STATE	ZIP 97544	E-MAIL PIXIE	NOTES ZODAmai	L. Com
'				رب)	

SECTION 2

RESERVOIR INFORMATION

Reservoir Dimensions and Capacity:

AGE MAXIMUM CAPACITY	AVERAGE	Average	Average
TH' IN ACRE-FEET	DEPTH"	Width	LENGTH
1.03	8 Pt	7014	80 Pt
	8 CA	1204	80 /7

To determine capacity in acre-feet use for the above table, use the following calculation:

Acre-feet = (Average Length)(Average Width)(Average Depth)
43,560

SECTION 3

MAP .

Attach a map identifying the reservoir location. If the water right application map accurately reflects the location of the reservoir, you may attach a copy of it. Otherwise, you must submit a map meeting the standards of OAR 690-310-0050, which are attached.

Preparation of the map by a Certified Water Rights Examiner is **not** required for this type of permit, but may be submitted.


SECTION 4

SIGNATURE

This Claim of Beneficial Use must be signed by each permit holder of record.

By my signature, I certify that the information contained herein is true and correct to the best of my knowledge.

SIGNATURE	PRINT OR TYPE NAME	TITLE	DATE
Atto	AnneVincent	Dwner	2/12/21

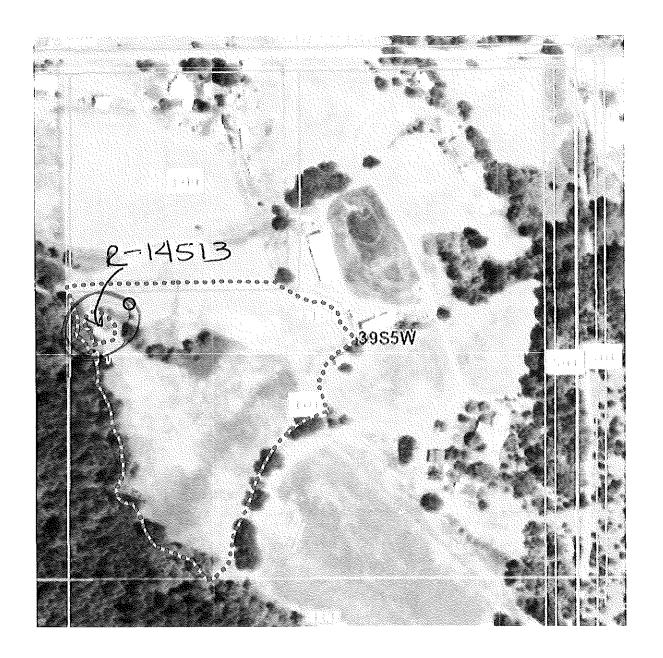

Volpod

RECEIVED

MAR 08 2021

OWRD