

T39S R09E

SEC 29

RECEIVED

APR 12 2021

OWRD


MAP 1 OF 3

MAP CREATED 04/07/2021

THIS MAP WAS PREPARED FOR ASSESSMENT PURPOSE ONLY.

SECTION 29 T.39S. R.09E. W.M. KLAMATH COUNTY

1"=400'

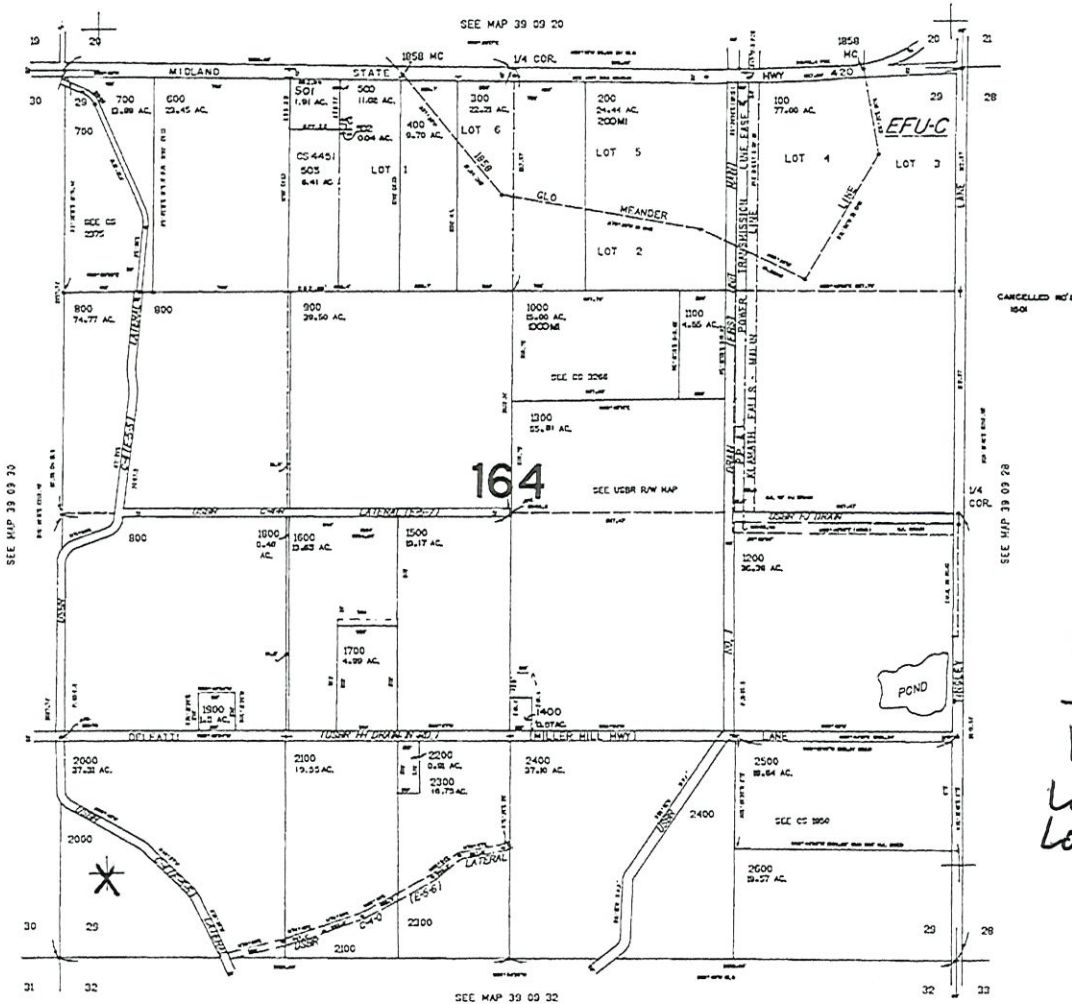

Well location

Klam 60765
Lat. 42.1418
Long -121.7961

39 09 29


THIS MAP WAS PREPARED FOR ASSESSMENT PURPOSE ONLY

SECTION 31 T.39S. R.09E. W.M.
KLAMATH COUNTY

1"=400'

MAP 2 OF 3

MAP CREATED 04/07/2021

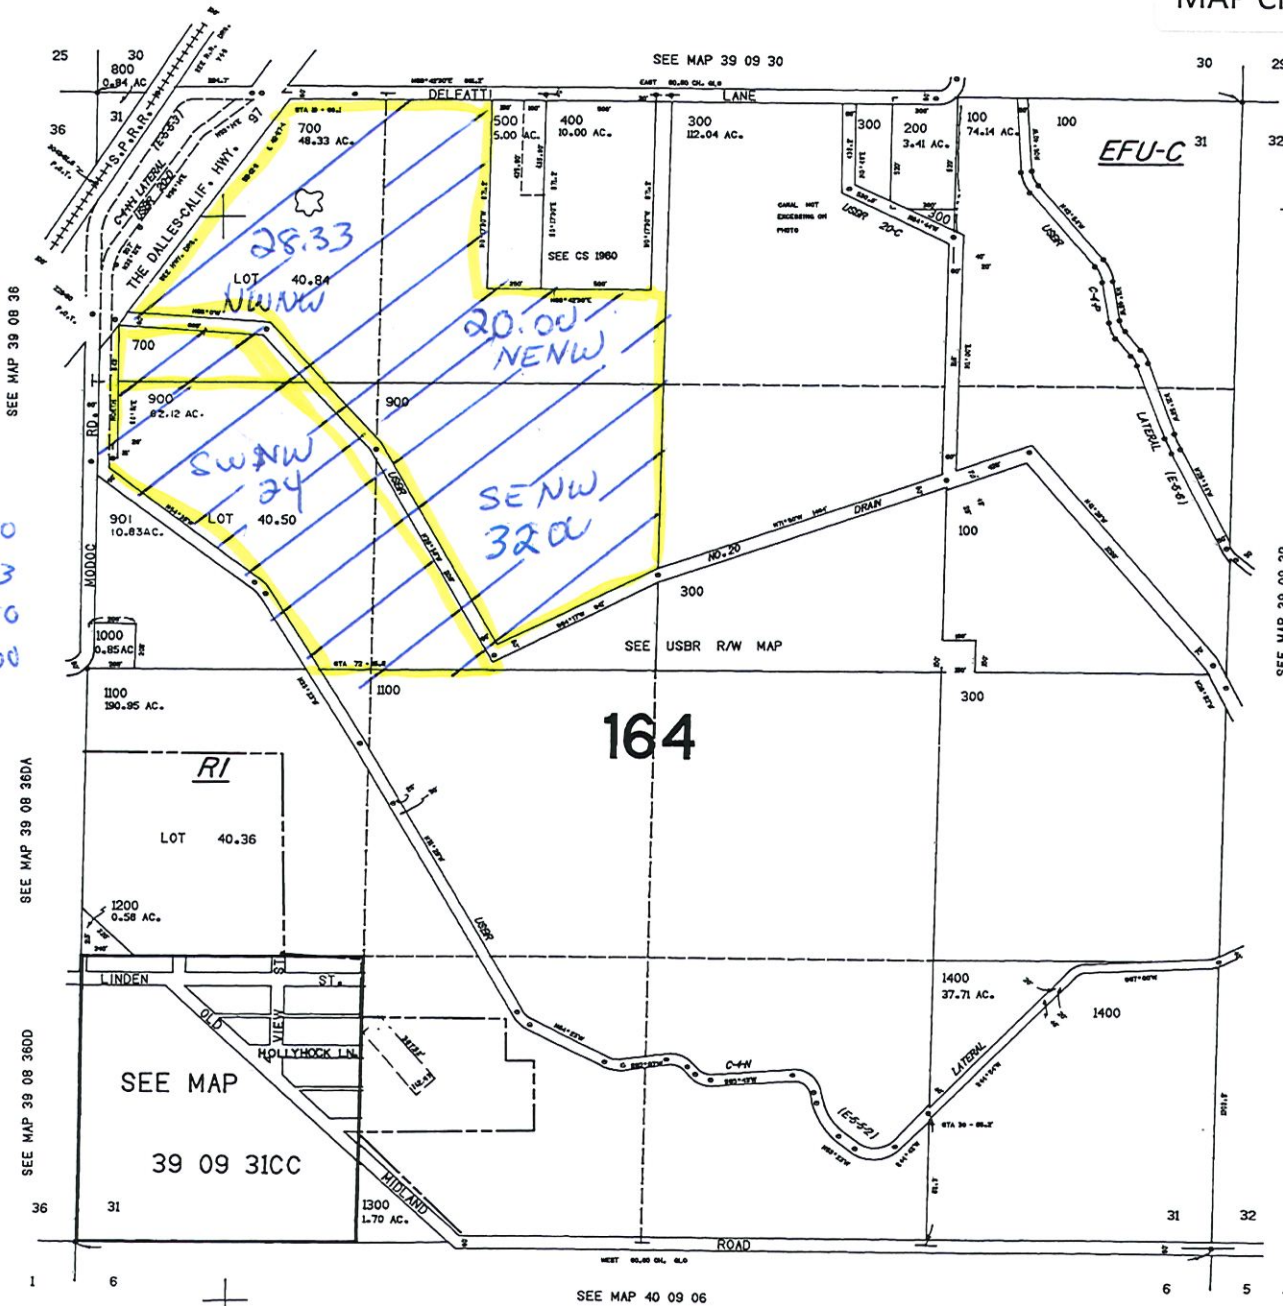

NORTH
T39S R09E
SEC.

Tax lot

700	NENW	20.00
	NWNW	28.33
900	SWNW	24.00
	SEnw	32.00

RECEIVED
APR 12 2021
OWRD

Scale
1"=880'

175,000
CANCELLED NO.
600

39 09 31
& INDEX


THIS MAP WAS PREPARED FOR ASSESSMENT PURPOSE ONLY

SECTION 31 T.39S. R.09E. W.M. KLAMATH COUNTY

1"=400'

MAP 2 OF 3

MAP CREATED 04/07/2021

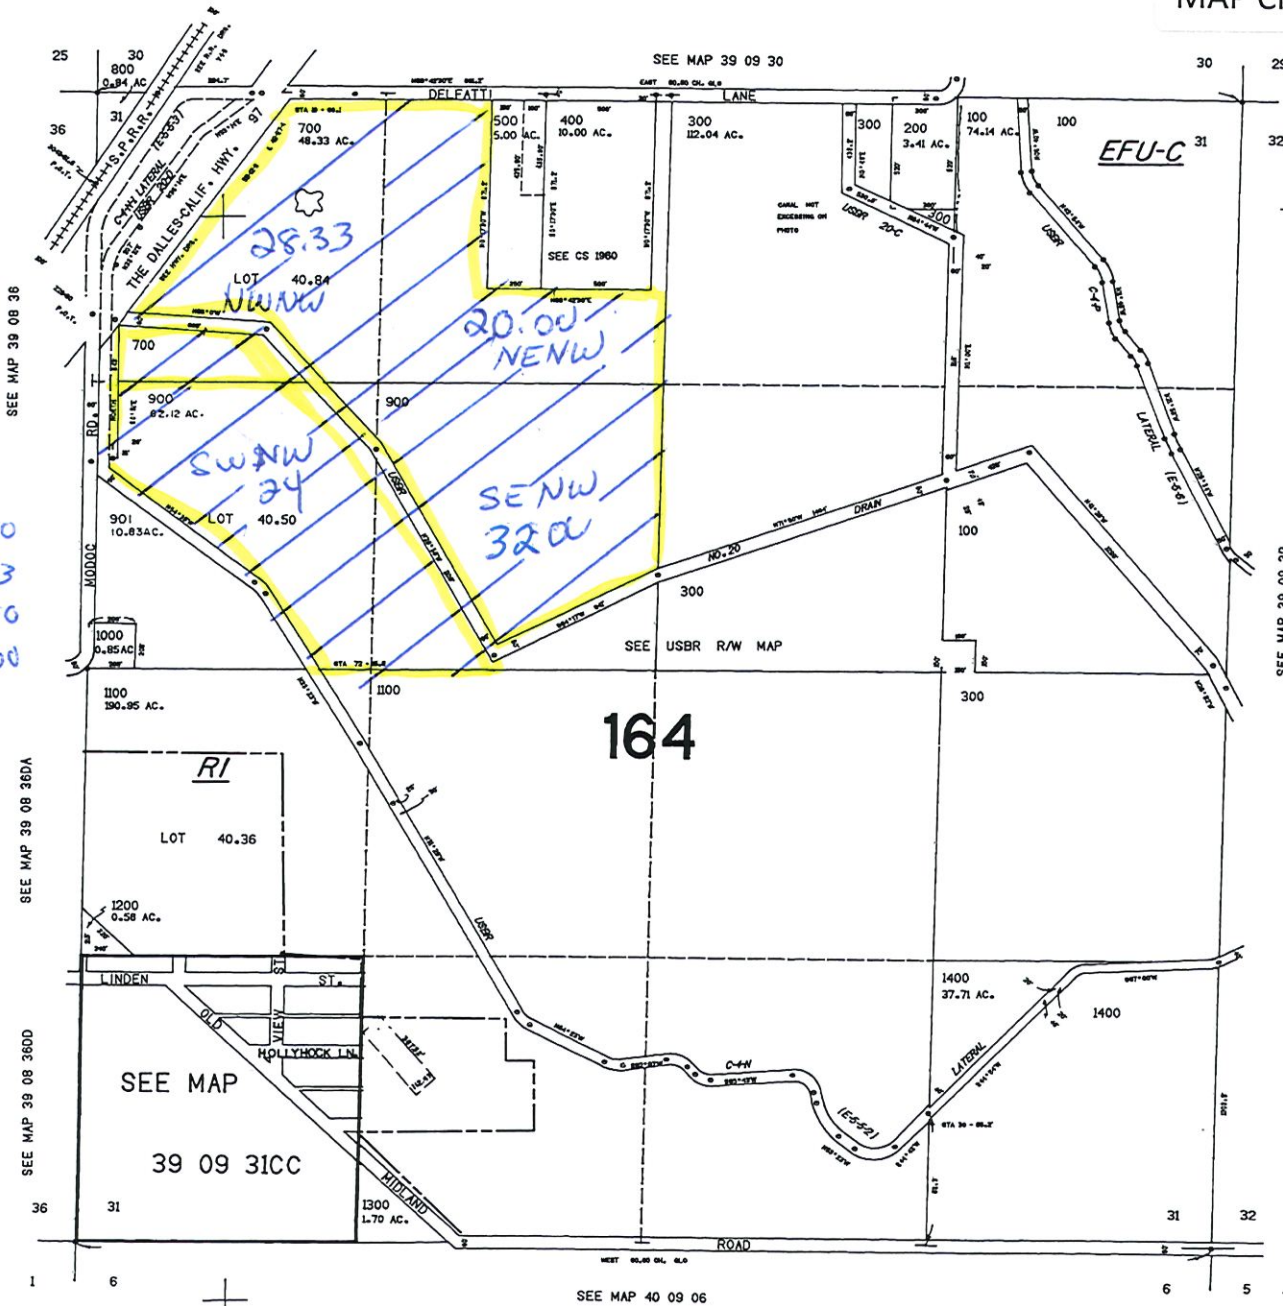

NORTH
T39S R09E
SEC.

Tax lot

700	NENW	20.00
	NWNW	28.33
900	SWNW	24.00
	SEnw	32.00

RECEIVED
APR 12 2021
OWRD

Scale
1"=880'

175,000
CANCELED NO.
600

39 09 31
& INDEX

THIS MAP WAS PREPARED FOR ASSESSMENT PURPOSE ONLY.

SECTION 36 T.39S. R.08E. W.M. KLAMATH COUNTY

1"=400'


MAP 3 OF 3

MAP CREATED 04/07/2021

NORTH
T39S R08E
SEC 36
Tax lot
500-SENE 16.80

RECEIVED
APR 12 2021
OWRD

Scale
1"=880'

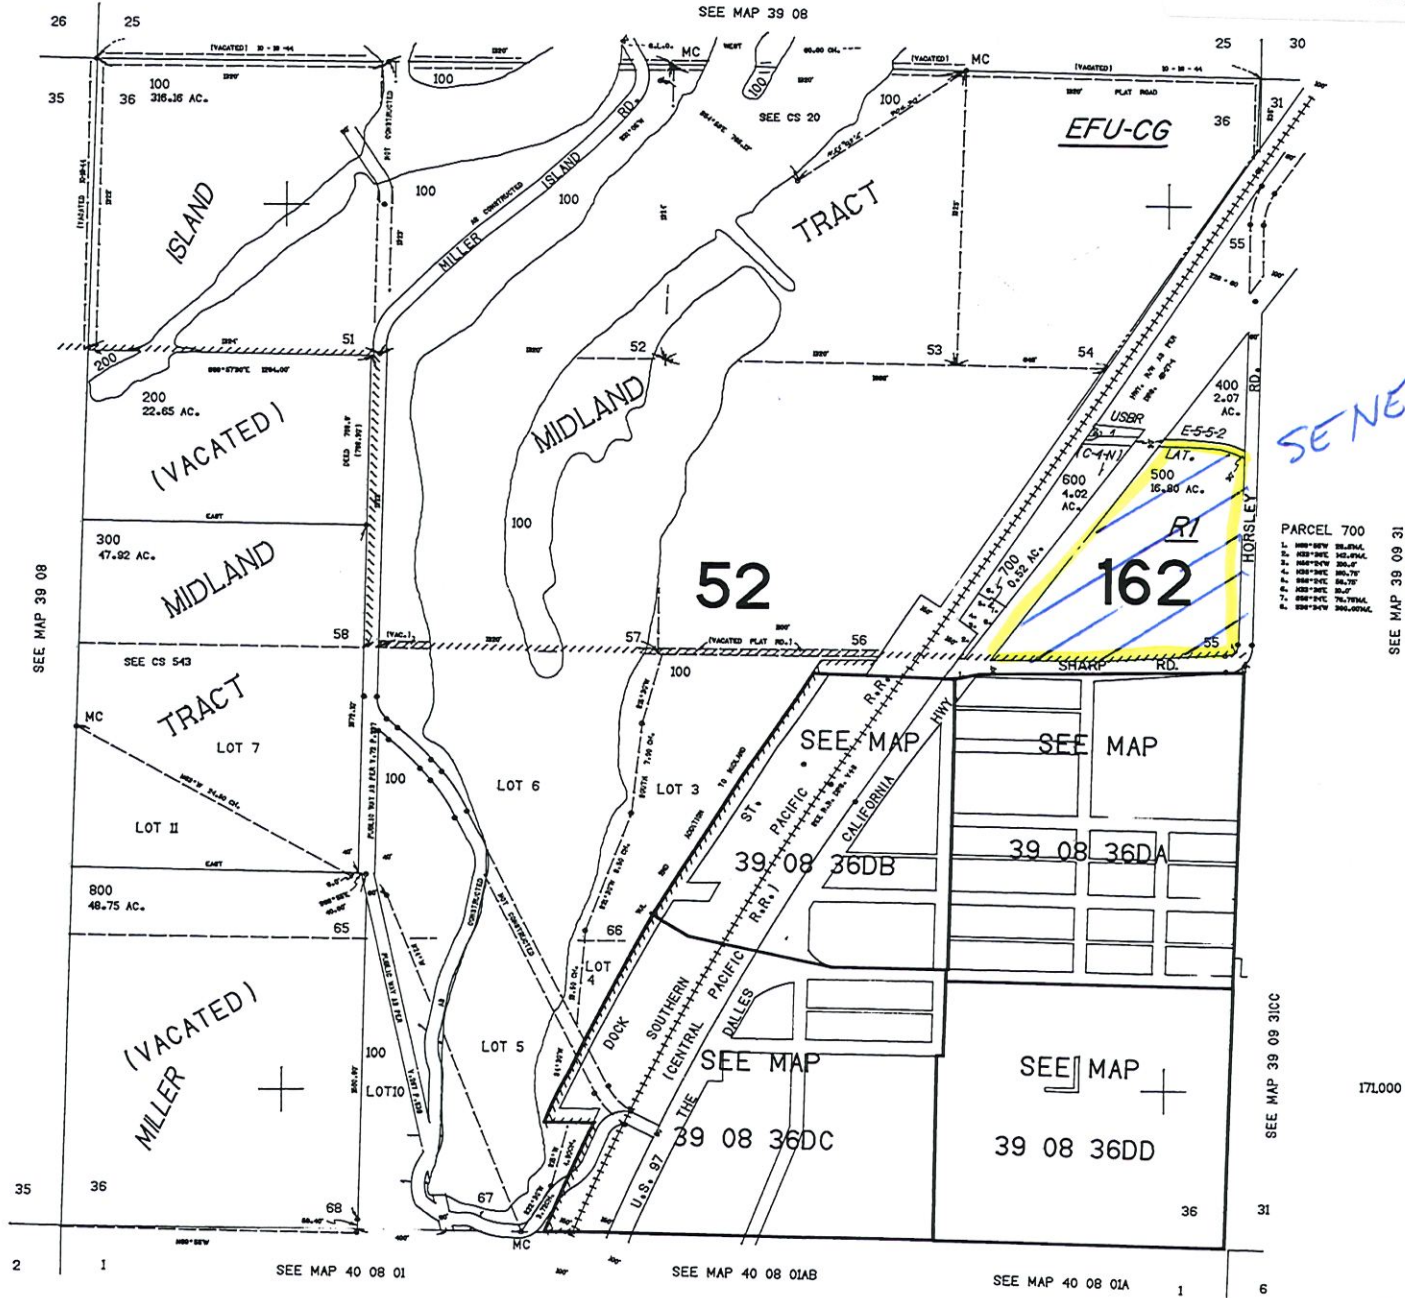

SENE

PARCEL 700


39 08 36 & INDEX