


Surface Water Application Ryder
T.33S R.15W Section 10 SW-NE
Curry County

RECEIVED

APR 12 2021

OWRD

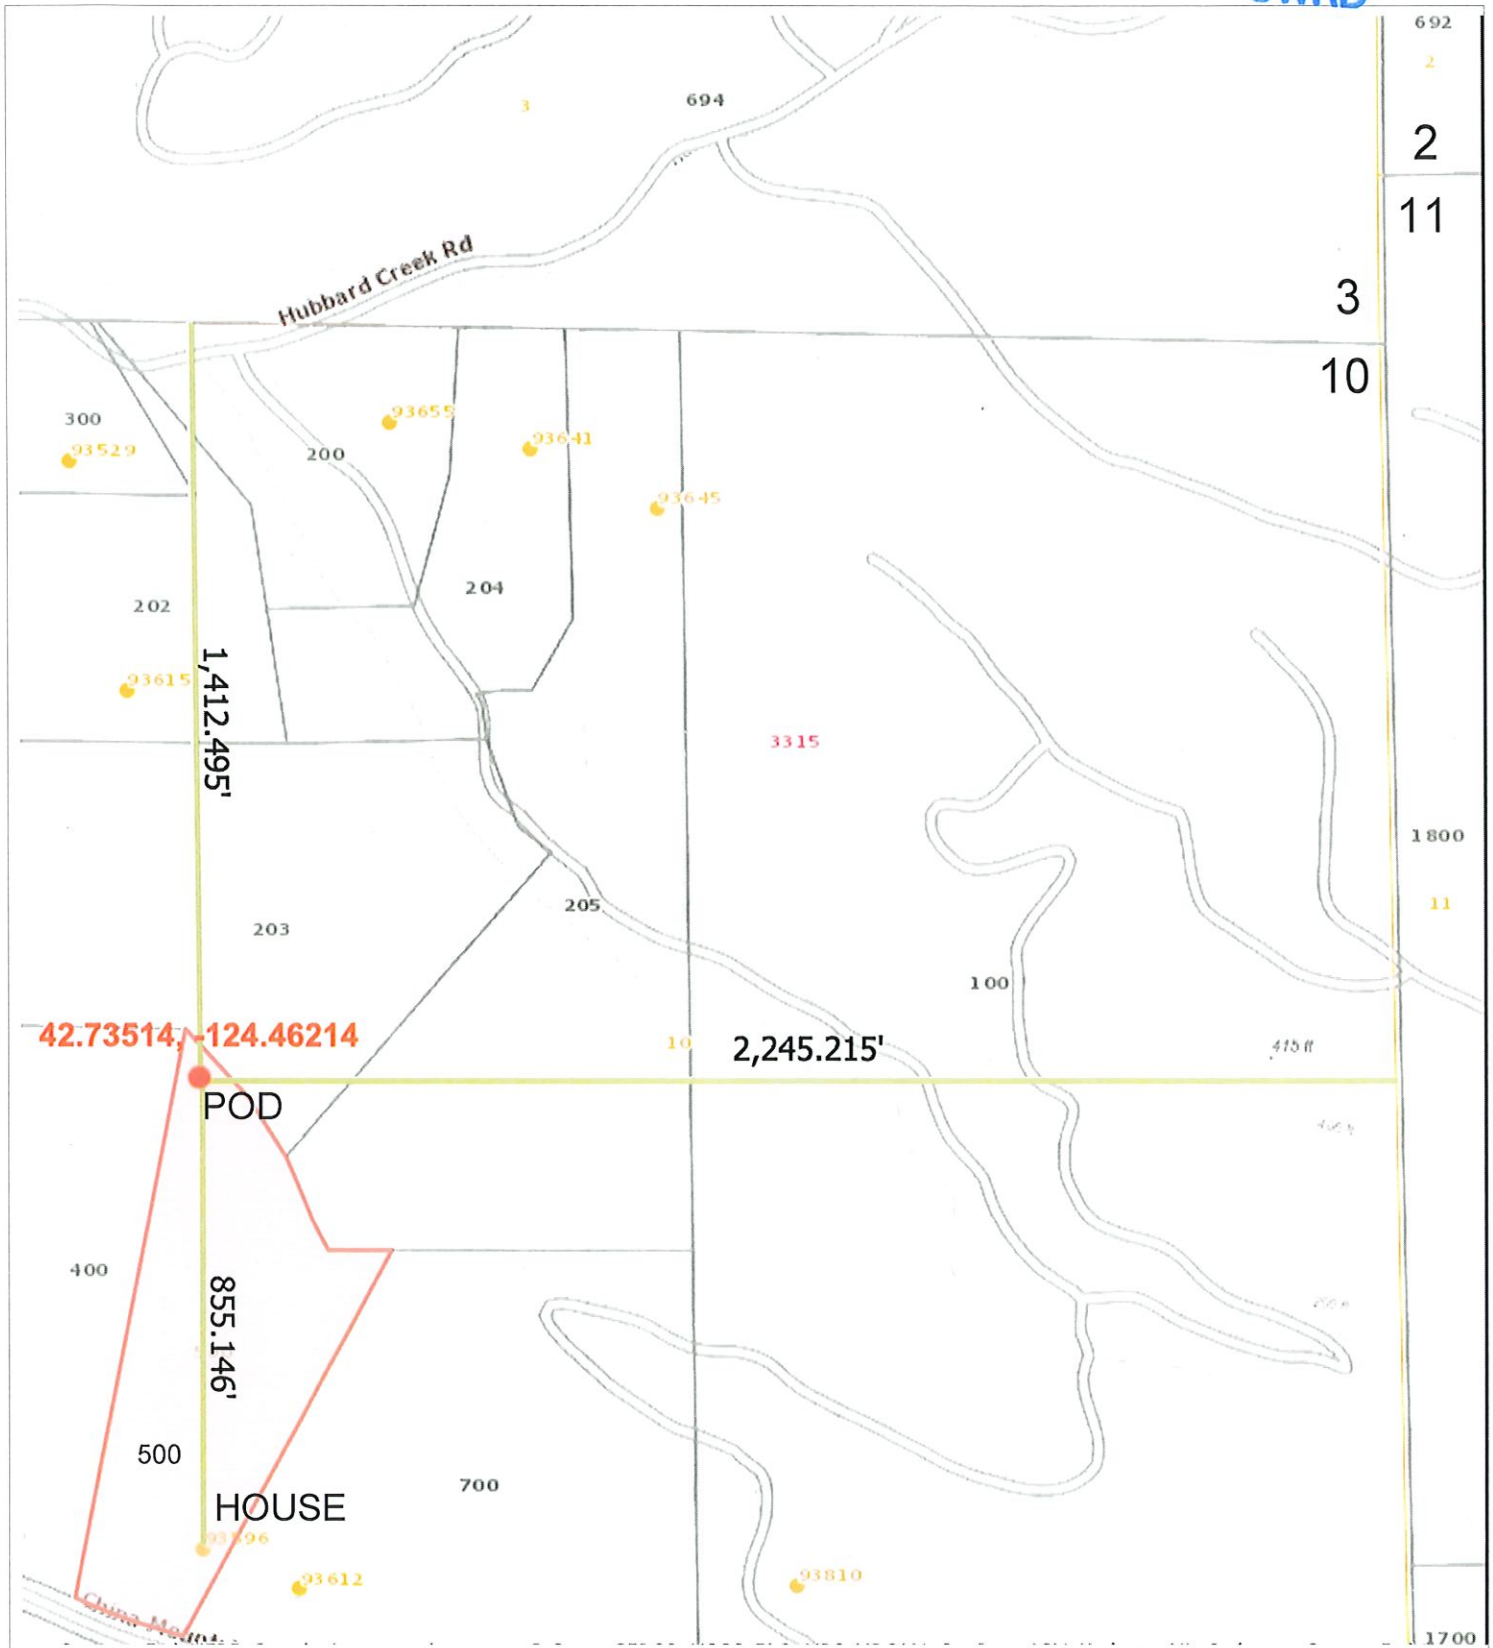

Point of Diversion is 1,412 ft South and 2,245 ft West of the North East corner of section 10.