


REVISED 07-12-2018
THIS MAP WAS PREPARED FOR
ASSESSMENT PURPOSE ONLY

SECTION 23 T.41S. R.12E. W.M.
KLAMATH COUNTY
1" = 400'

MAP 1 - OF 3

MAP CREATED 03/19/2021

NORTH

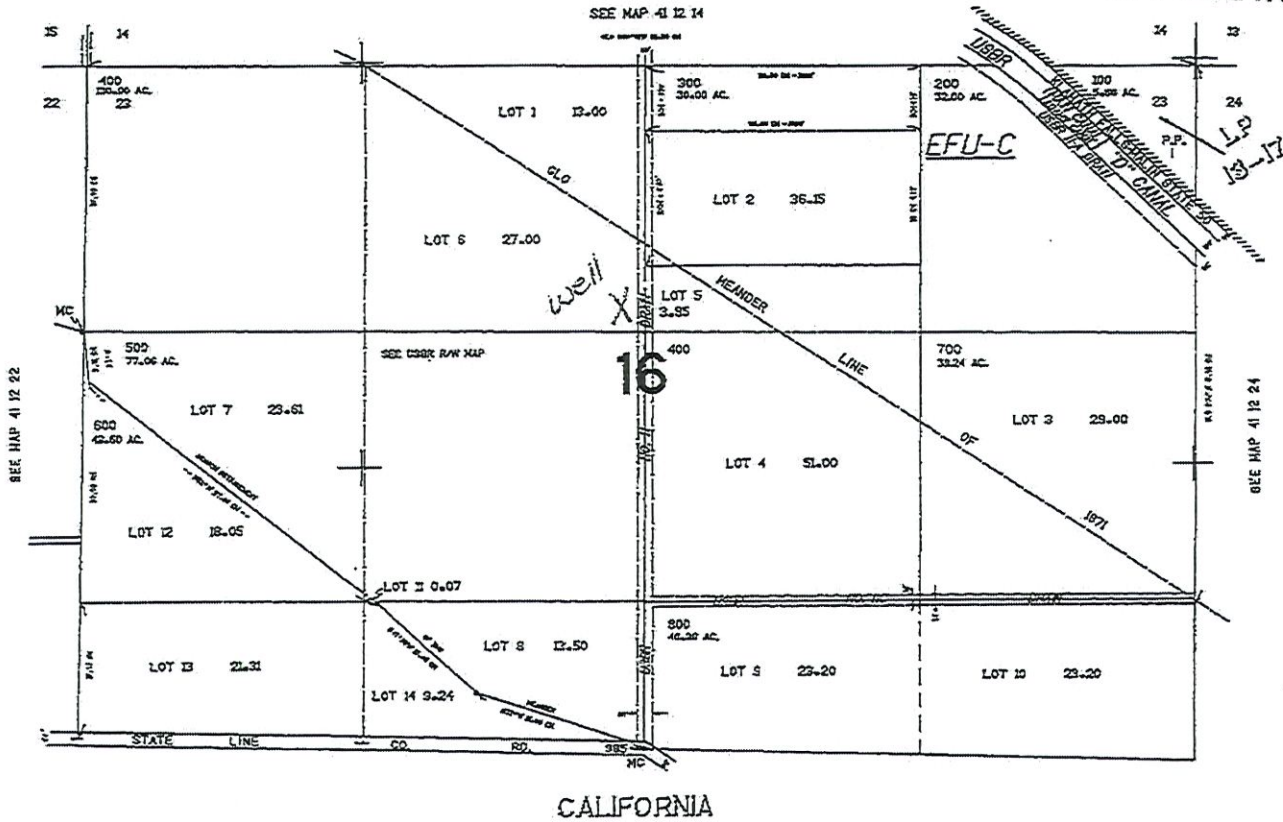

RECEIVED
APR 14 2021
OWRD

Well # 1
Well location
KLAM 10445
42.0029
-121.3796

Scale
1" = 880'

REVISED 07-12-2018


THIS MAP WAS PREPARED FOR ASSESSMENT PURPOSE ONLY

SECTION 14 T.41S. R.12E. W.M. KLAMATH COUNTY

1"=400'

MAP 2 OF 3

MAP CREATED 04/07/2021

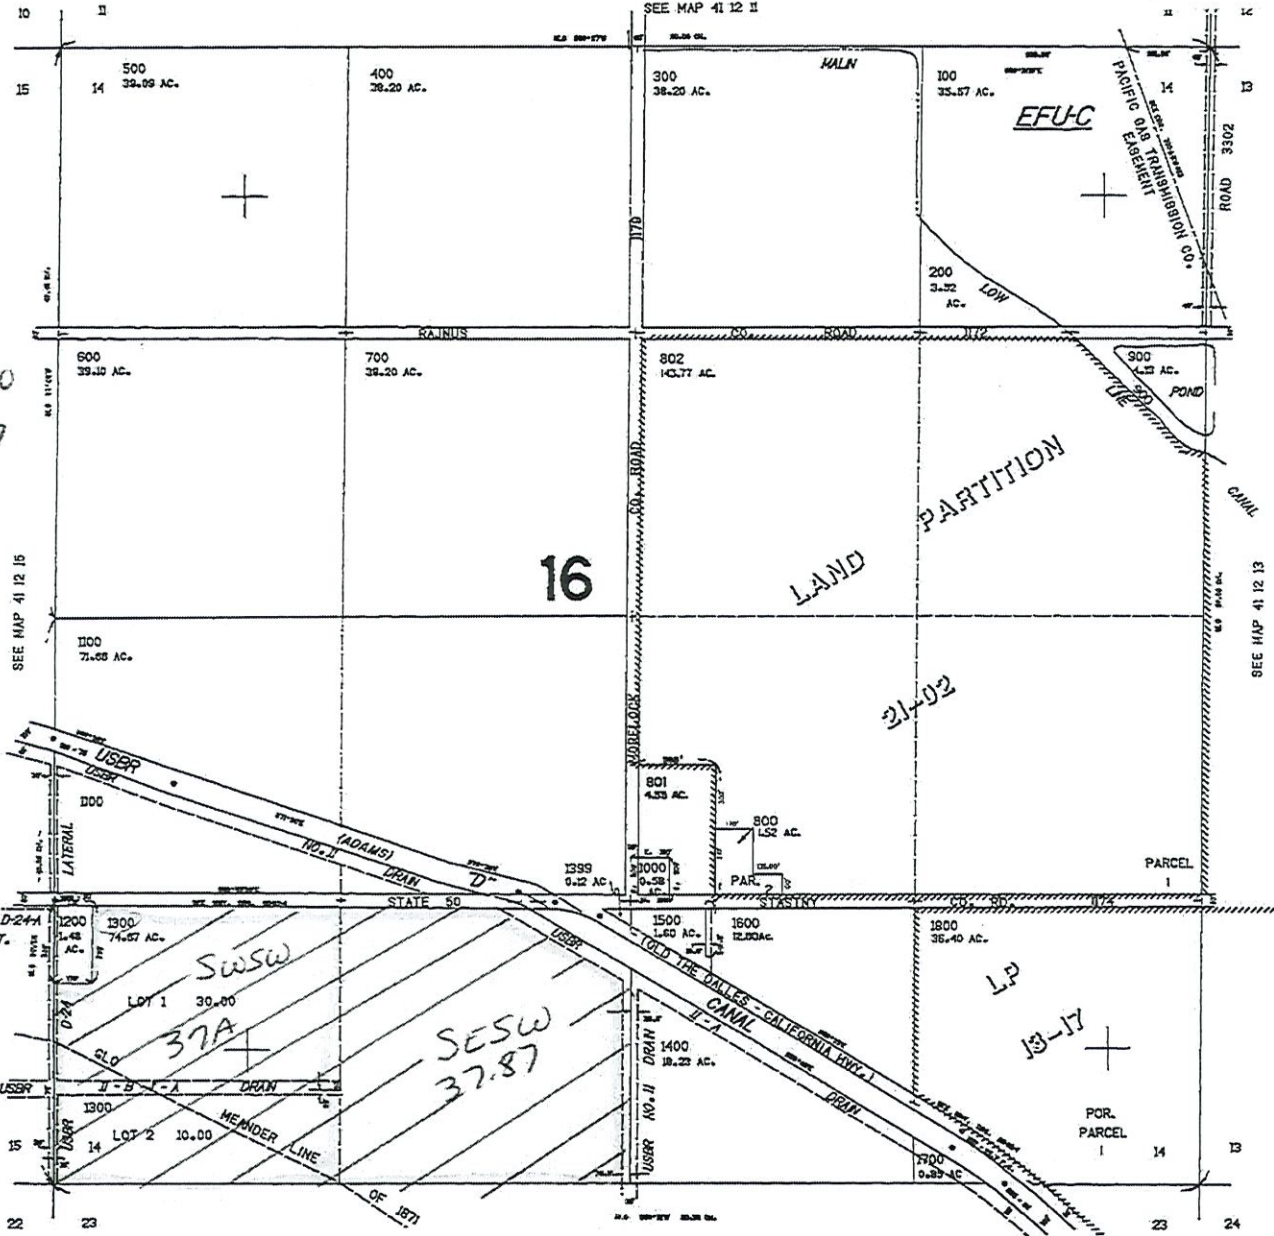

↑
NORTH
THIS RIDE
SEC. 14

Tax lot
1300 SWSW 37.00
SESW 37.87

RECEIVED
APR 14 2021
OWRD

RECEIVED
APR 14 2021
OWRD

Scale
1" = 800'

1750.000

SEE MAP 41 12 23

41 12 14


REVISED 07-12-2018

THIS MAP WAS PREPARED FOR ASSESSMENT PURPOSE ONLY

SECTION 23 T.41S. R.12E. W.M.
KLAMATH COUNTY
1" = 400'

MAP 3 OF 3

MAP CREATED 04/07/2021

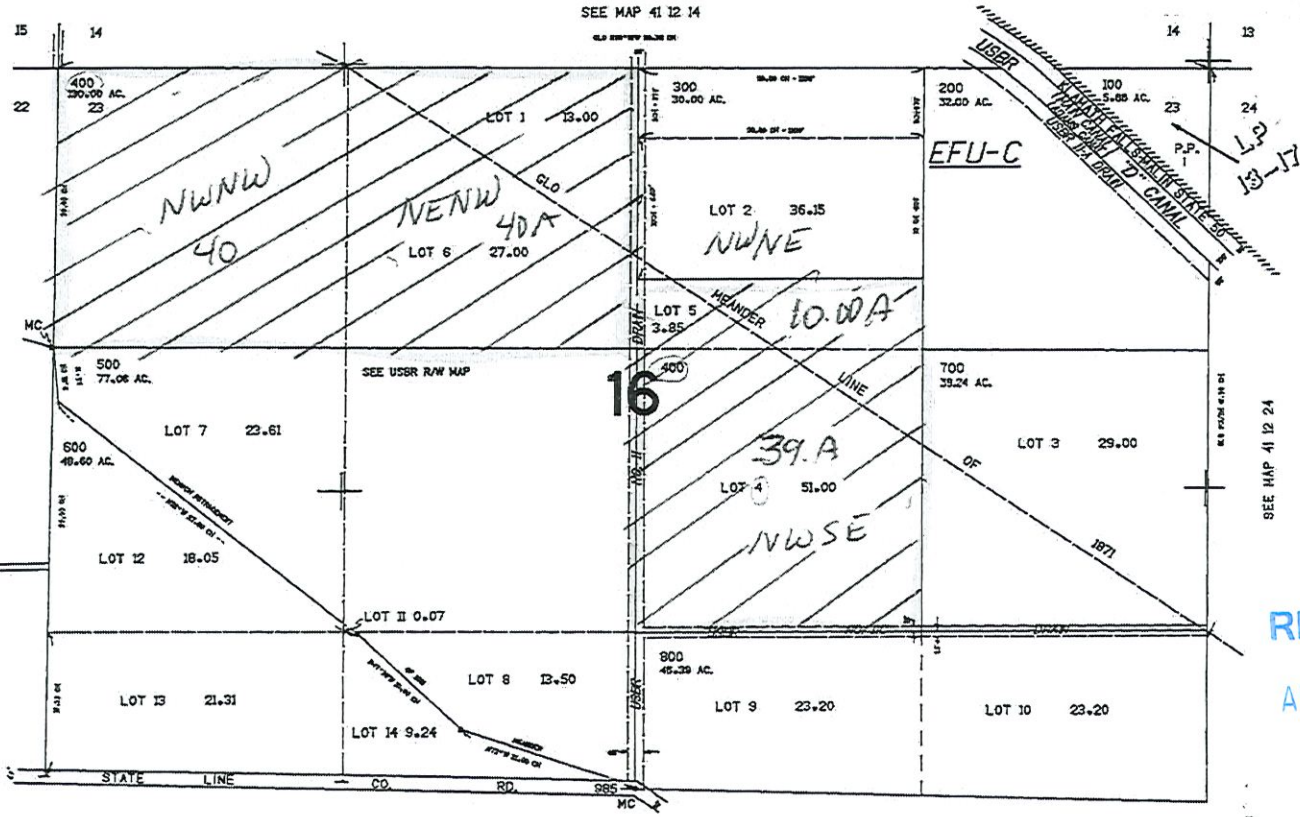

NORTH

THIS R12E
SEC 23

Tax lot

- 4.00 NENW 40.00
- NWNW 40.00
- NWNE 10.00
- NWSE 39.00

RECEIVED

APR 14 2021

OWRD

Scale

1" = 880'