



CLAIM OF BENEFICIAL USE AND FINAL PROOF

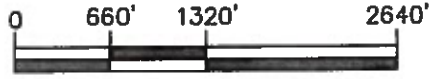


RECEIVED

MAY 13 2020

OWRD

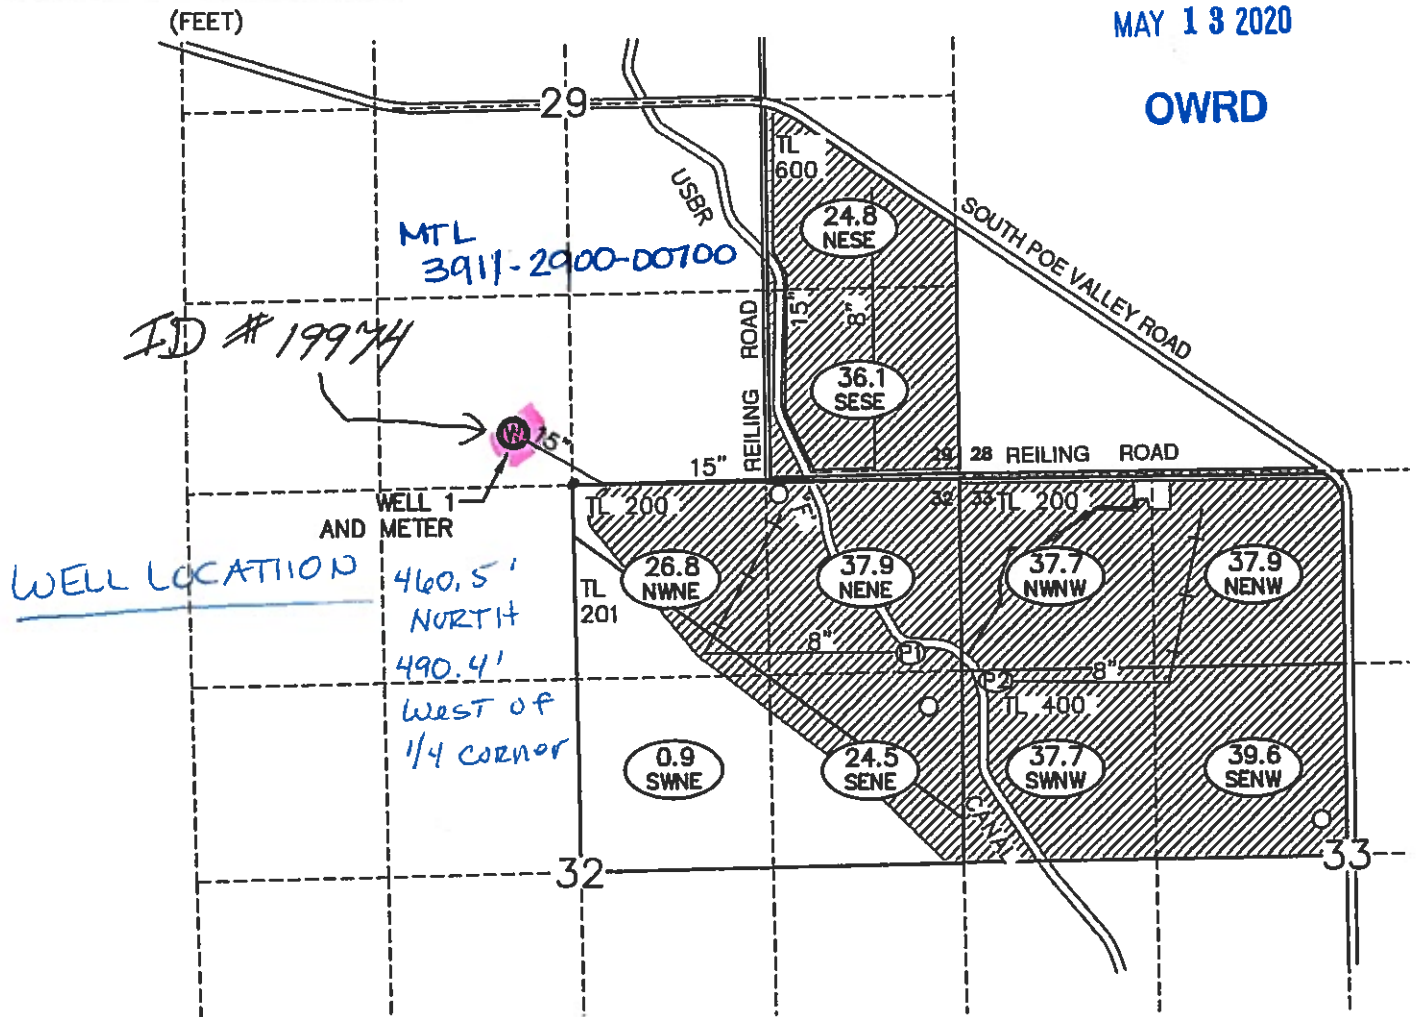

LEGEND

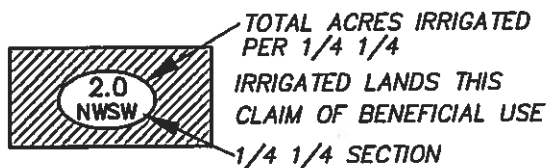

32 SECTION DESIGNATION

TL TAX LOT NUMBER

--- SECTION LINES
- - - 1/4 1/4 LINES

==== ROADS

_____ TAX LOT BOUNDARY

10" MAIN LINE SIZE

---+---+---+--- PIVOT LINE

○ BIG GUN

⊙ EXISTING P.O.A. (WELL)

⊙ PUMPING STATION AND NUMBER