

1  
NORTH

THIS R11E  
SEC 2

RECEIVED  
APR 05 2021  
OWRD

Well Location  
KLAM 56425

42.0292  
-121.5016

17


THIS MAP WAS PREPARED FOR  
ASSESSMENT PURPOSE ONLY.

SECTION 02 T.41S. R.11E. W.M.  
KLAMATH COUNTY

1"=400'

MAP 1 OF 2

MAP CREATED 03/31/20

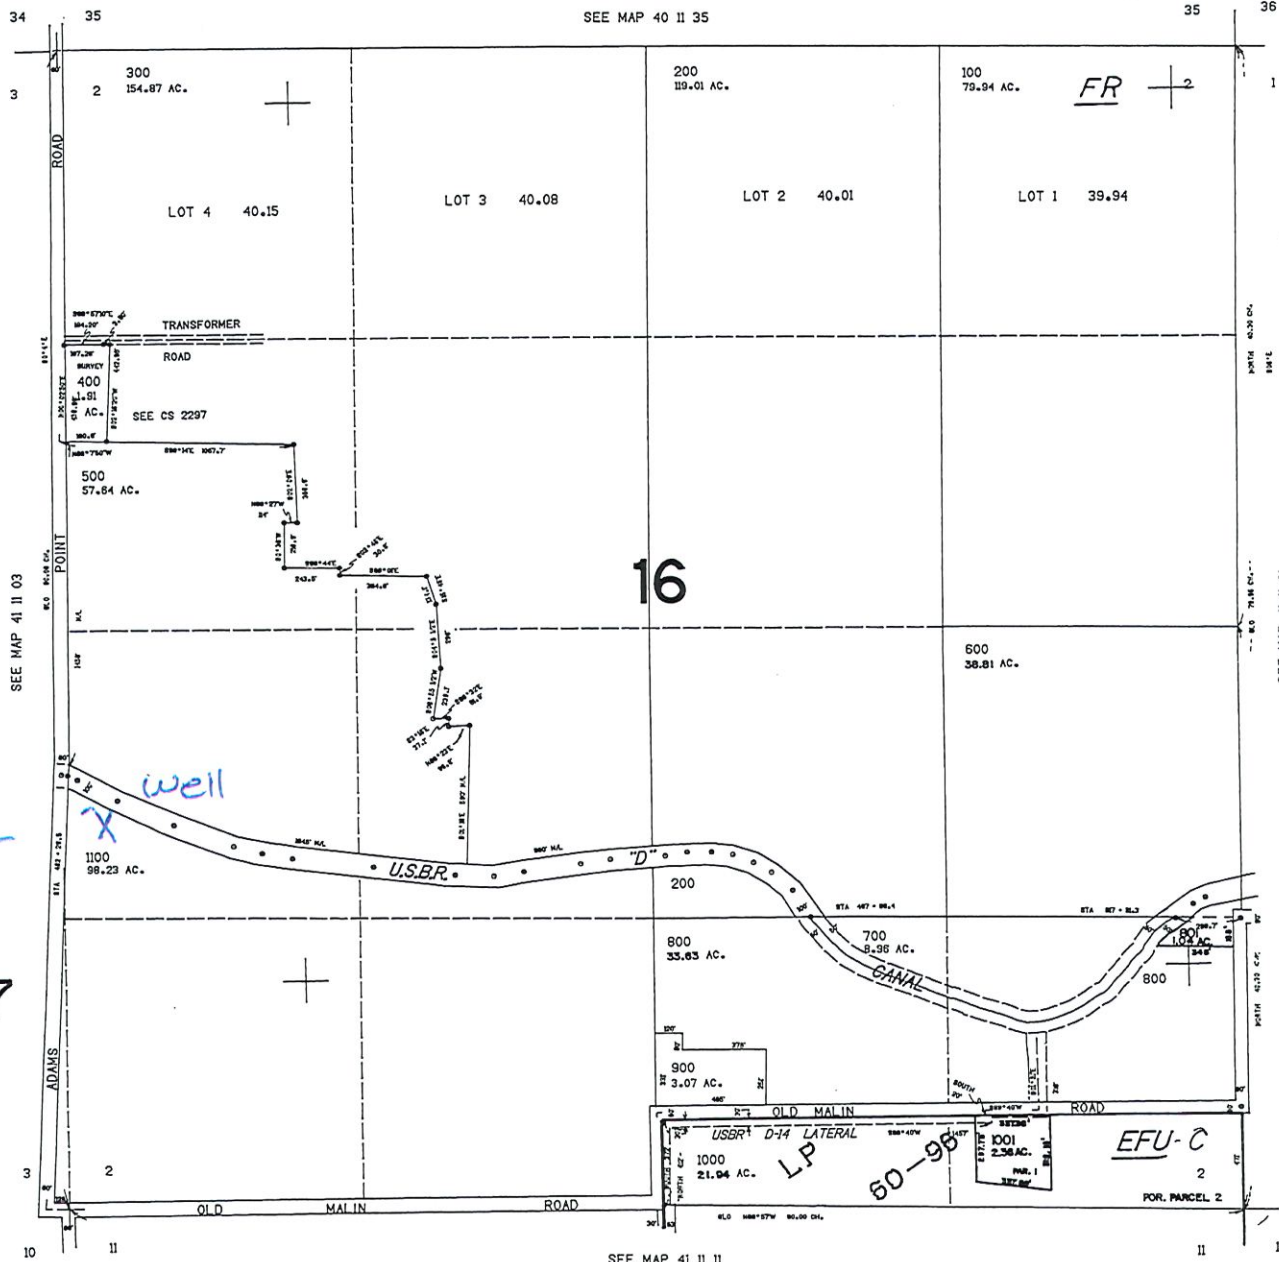

CANCELLED NOS  
601

133.000

1729.000

41 11 02

THIS MAP WAS PREPARED FOR ASSESSMENT PURPOSE ONLY


SECTION 11 T.41S. R.11E. W.M.  
KLAMATH COUNTY

1"=400'

MAP 2 OF 2

MAP CREATED 03/31/2021

NORTH  
T41S R11E  
SEC 11  
Tax lot  
300 - SWNE 39.00  
SENE 39.00  
RECEIVED  
APR 05 2021  
OWRD

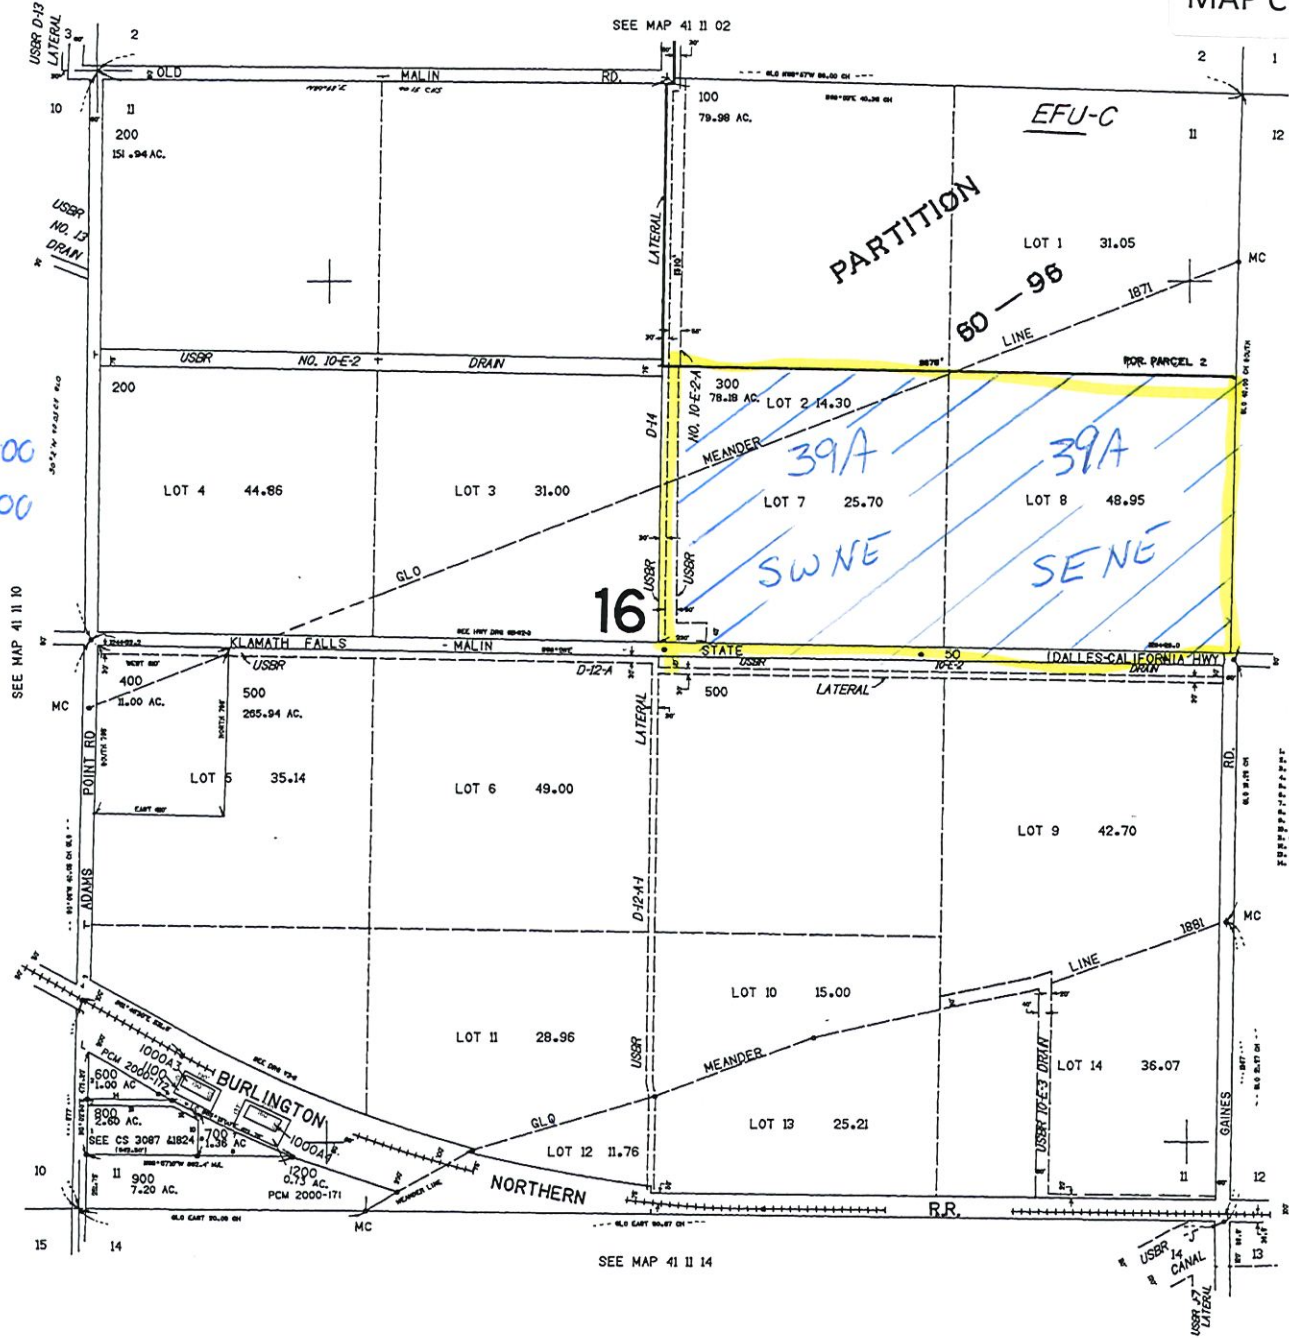

- 1. 10'-0\"/>

Scale  
1" = 880'