

JOHN FRANK


REVISED 5-28-10

THIS MAP WAS PREPARED FOR ASSESSMENT PURPOSE ONLY

SECTION 08 T.40S. R.10E. W.M. KLAMATH COUNTY

40 10 08

1-4007

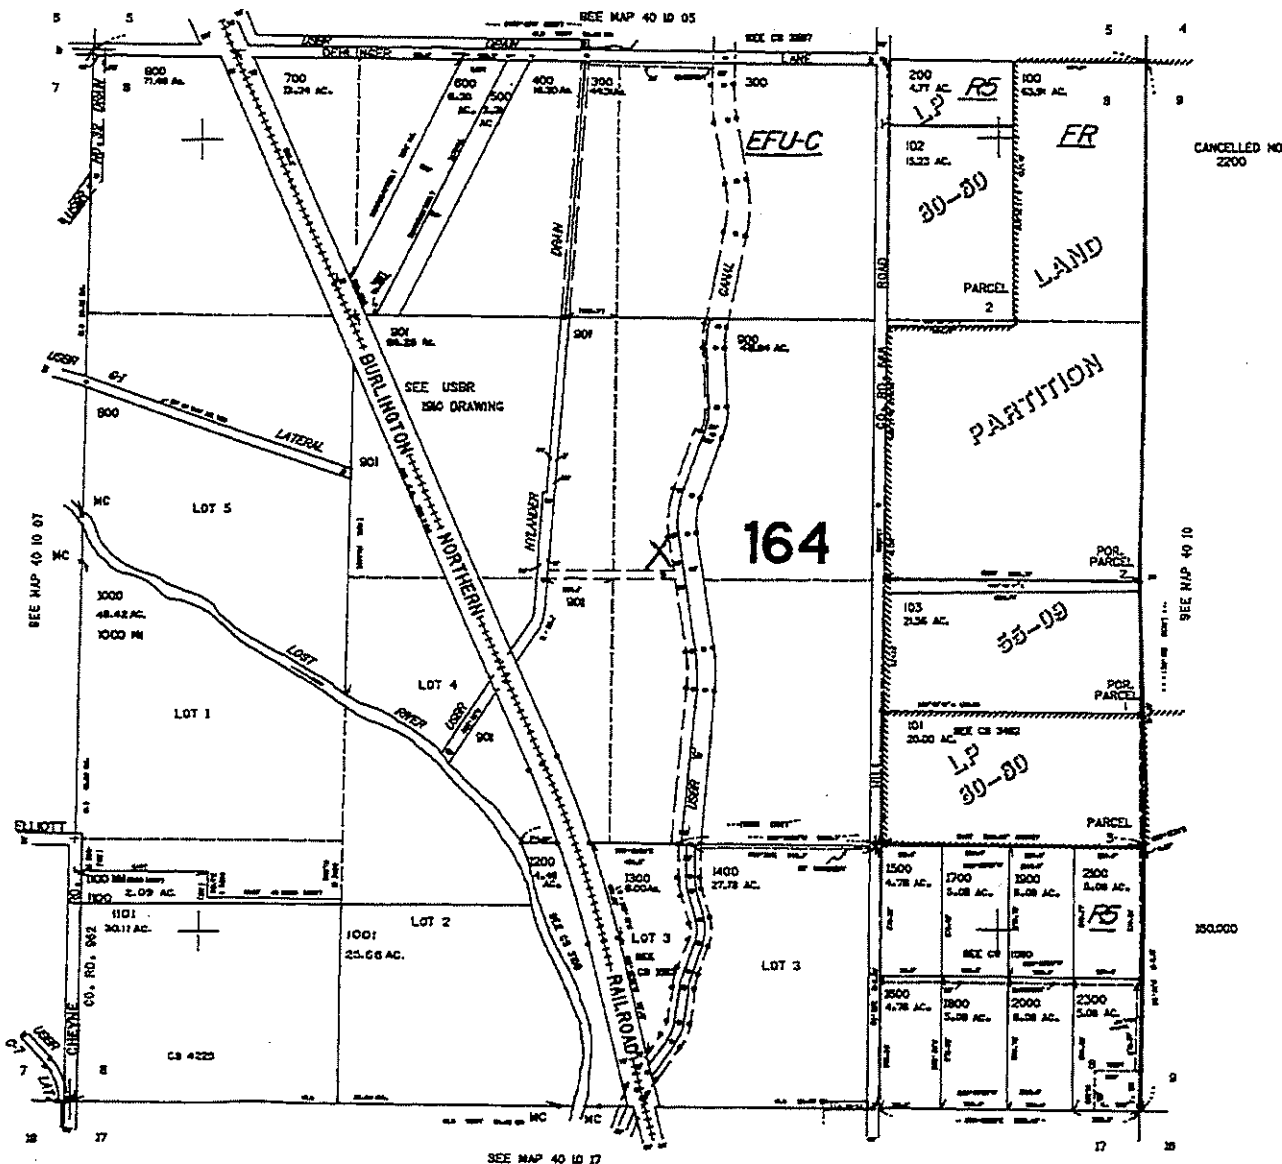

KLAMAM 52973

X - WELL SITE

RECEIVED BY OWRD

MAY 18 2015

SALEM, OR

40 10 08

Frank


SECTION 08 T.40S. R.10E. W.M.
KLAMATH COUNTY
1" = 400'

Map 1 of

40 10 08

Map created
02/05/2021

REVISED 10-22-2019
THIS MAP WAS PREPARED FOR
ASSESSMENT PURPOSE ONLY

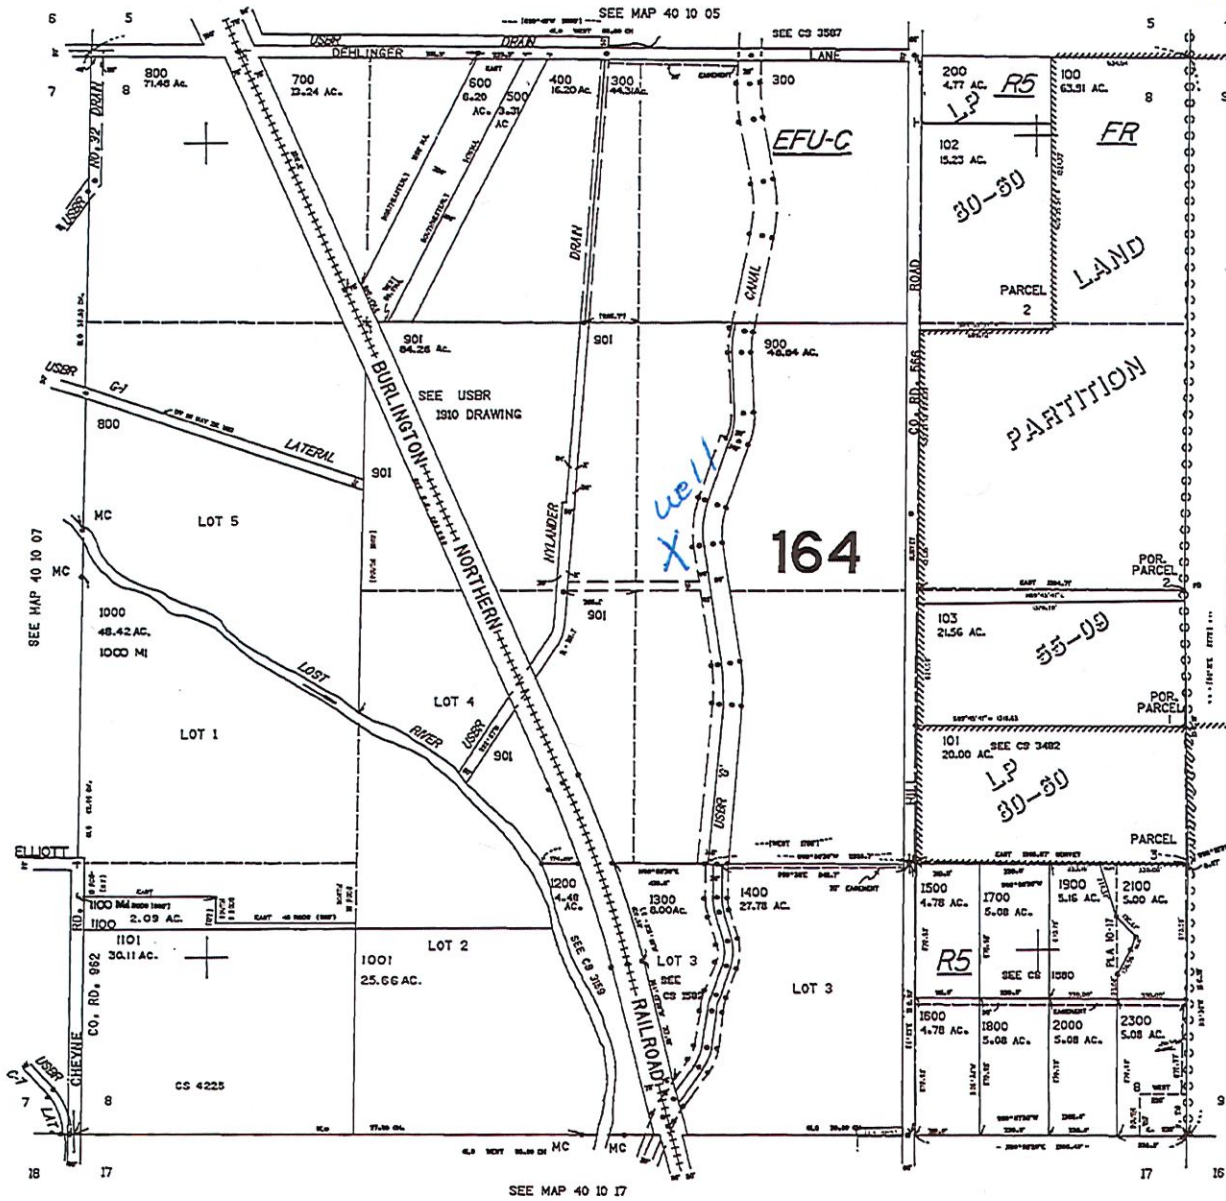

1
NORTH
T40S RIDE
SEC. 8

Well location
Klam 52973
42.1045
-121.6677

Scale
1" = 880'

40 10 08

THIS MAP WAS PREPARED FOR ASSESSMENT PURPOSE ONLY

SECTION 24. T.39S. R.09E. W.M.
KLAMATH COUNTY

1"=400'

RECEIVED

APR 05 2021

OWRD

NORTH


T39S R9E

SEC.24

Tax lot

300	NESE	35.00
	NWSE	30.00
	SWSE	1.00
	SESE	2.00

Scale
1"=880'

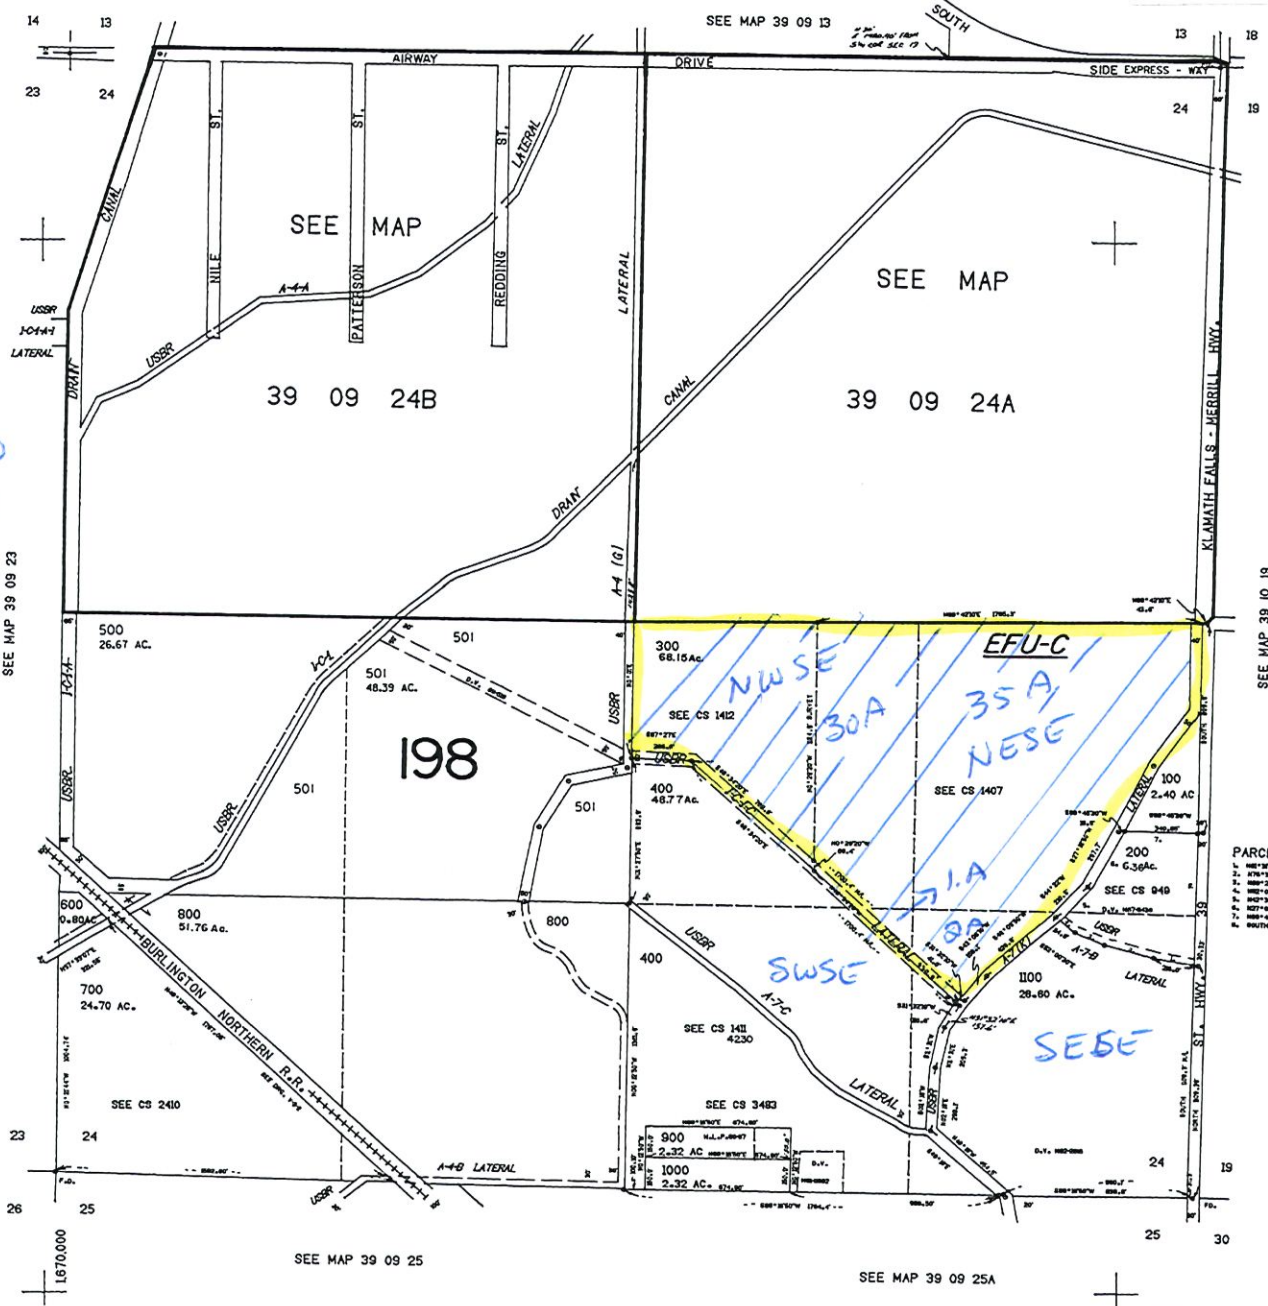

39 09 24
& INDEX

THIS MAP WAS PREPARED FOR ASSESSMENT PURPOSE ONLY.

SECTION 33 T.39S. R.09E. W.M.
KLAMATH COUNTY

1"=400'

MAP 3 OF 9

MAP CREATED 03/05/2021

RECEIVED

APR 05 2021

OWRD


NORTH

T39S R09E
SEC. 33

Tax lot

500	NWNE	18.00
	NENW	10.00
	SWNW	17.00
	SE NW	40.00
	SW NE	40.00
	NESW	18.00
	NWSE	37.00
600	SENE	18.00

Scale
1" = 880'

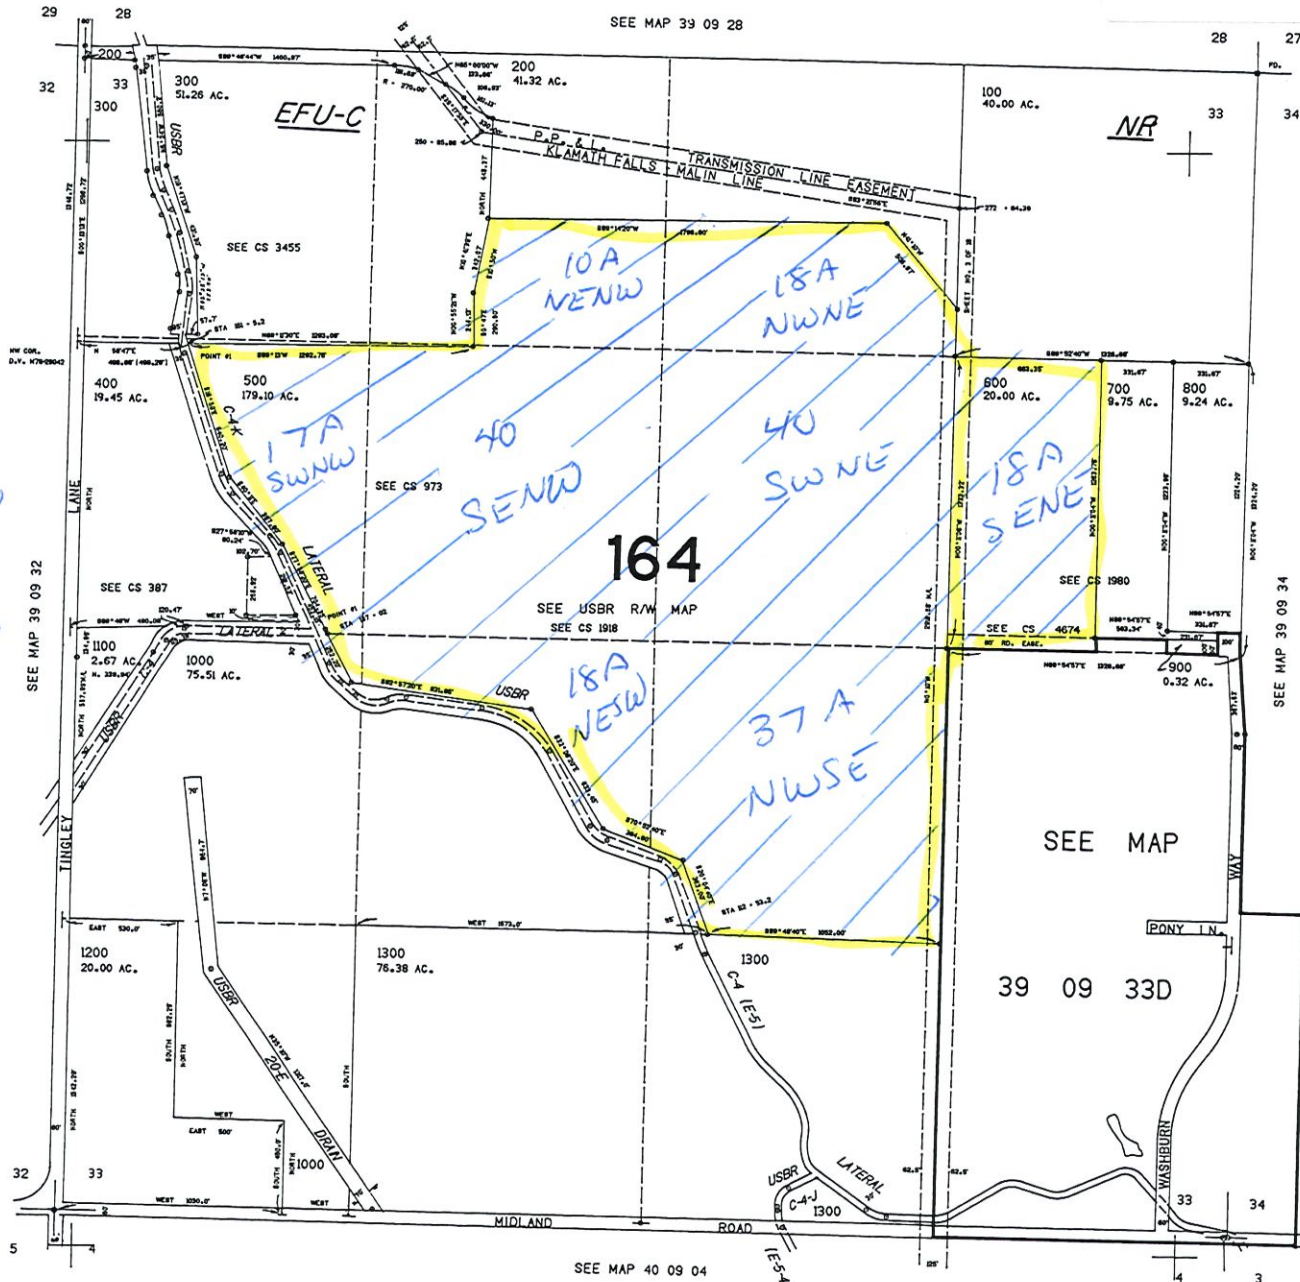

39 09 33
& INDEX

REVISED 09-15-14
THIS MAP WAS PREPARED FOR
ASSESSMENT PURPOSE ONLY


SECTION 28 T.39S. R.10E. W.M.
KLAMATH COUNTY

1"=400'

MAP 4 OF 9

MAP CREATED 03/05/2021

RECEIVED
APR 05 2021
OWRD
NORTH
T39S R10E
SEC. 28
Tax lot
1002 NESW 13.7
SWSW 30.00
SESW 40.00

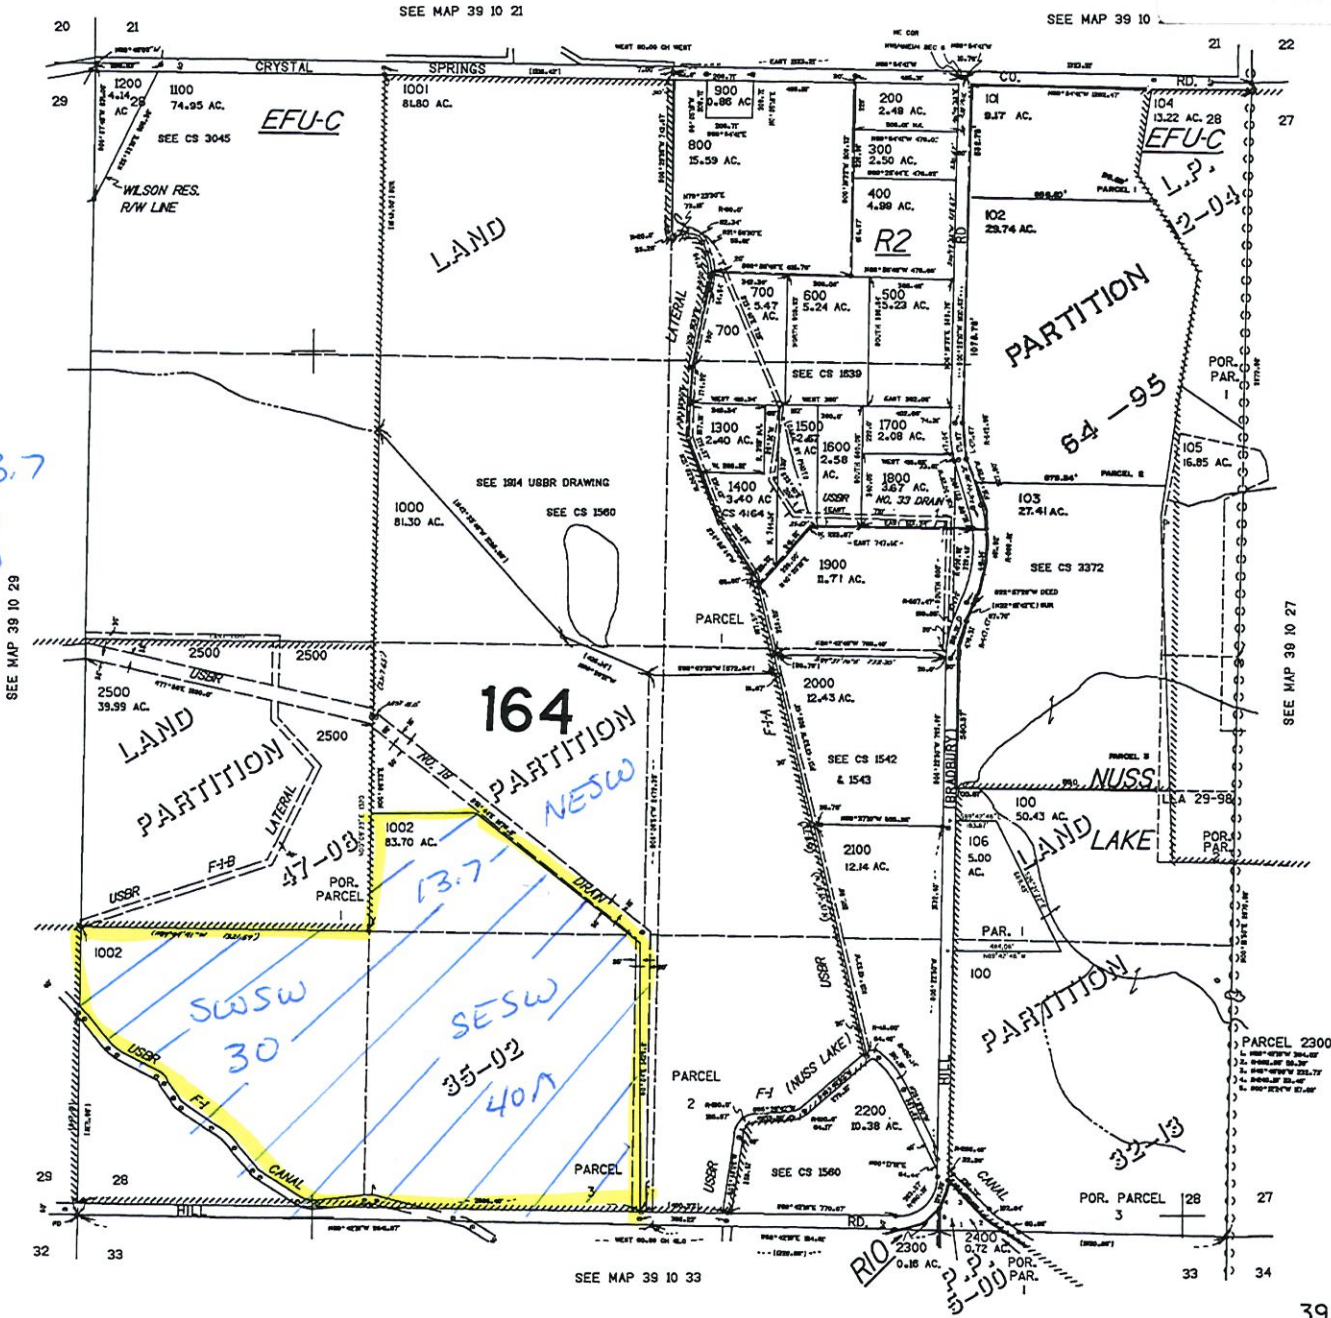

Scale
1" = 880'

175.000

39 10 28

00010000

REVISED 02-11-2019

THIS MAP WAS PREPARED FOR ASSESSMENT PURPOSE ONLY

SECTION 31 T.39S. R.10E. W.M. KLAMATH COUNTY

1" = 400'

MAP 5 OF 9

MAP CREATED 03/05/2021

RECEIVED

APR 05 2021


OWRD

NORTH

T 39S R 10E
SEC. 31

Tax lot

500 NENE	20.00
NWNE	5.00
SWNE	32.00
SENE	37.00

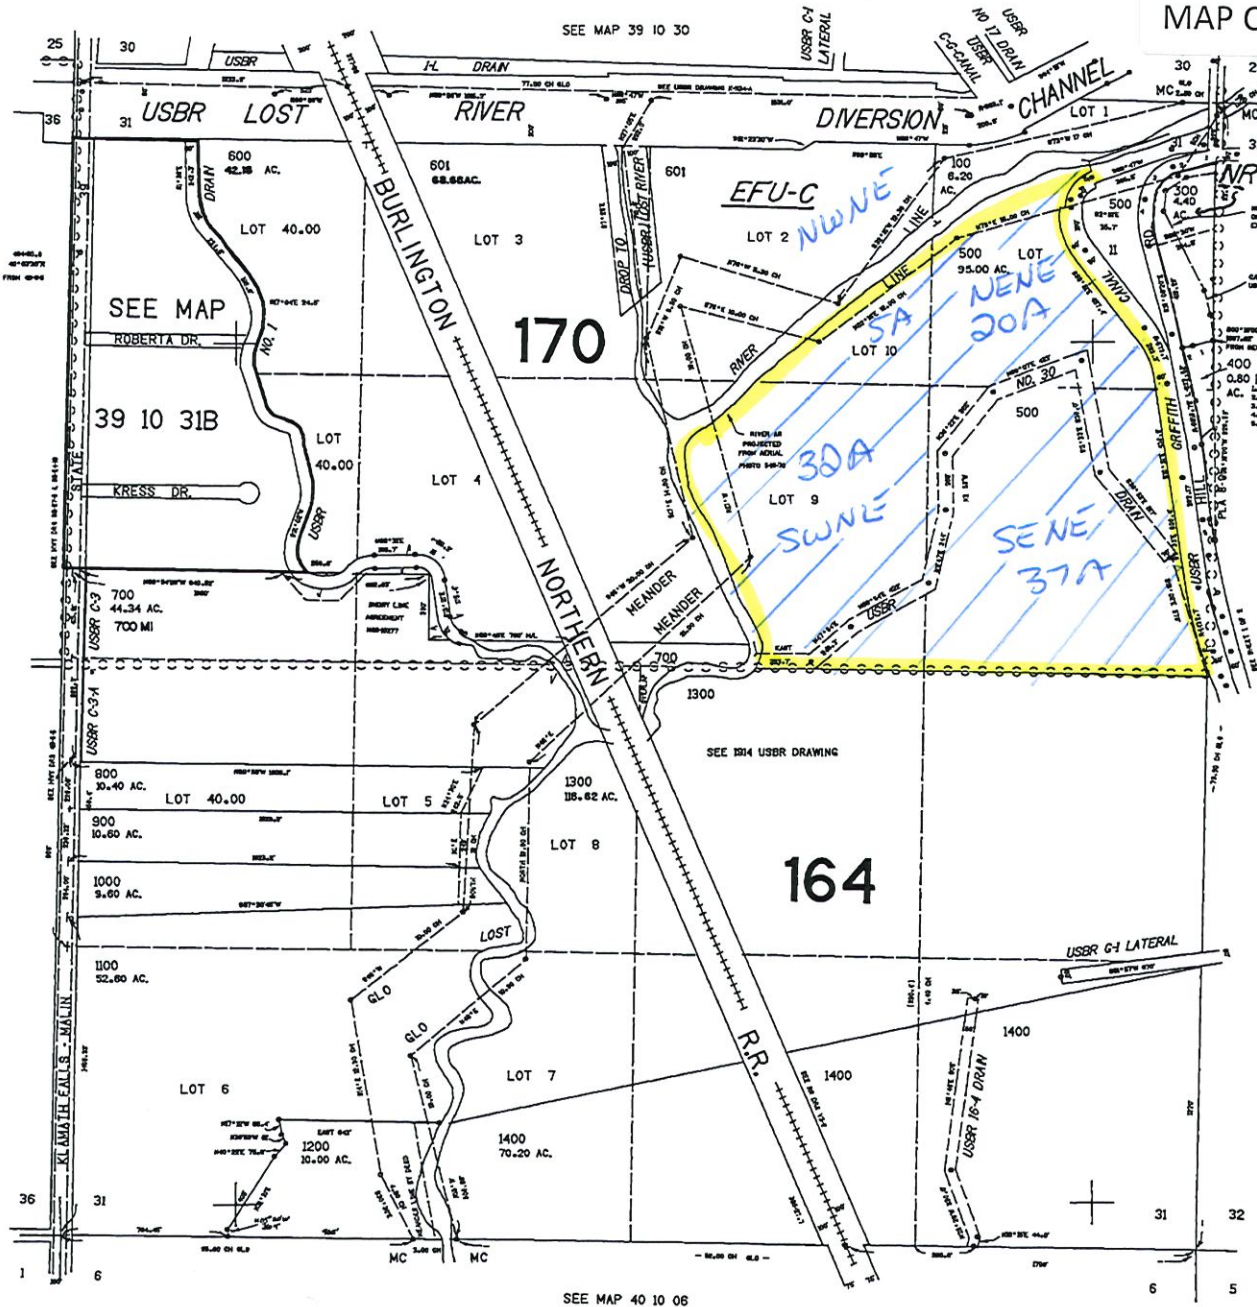


CANCELLED NO. 200

SEE MAP 39 10 32

164

170

170.00

SEE MAP 40 10 06

39 10 31

& INDEX

Scale
1" = 880'

1000

RECEIVED

APR 05 2021

OWRD

NORTH
T40S R10E
SEC. 7

Tax lot

100	NENE	38.00
	NWNE	25.00
	SWNE	8.00
	SENE	30.7
	NESE	18.0
	NWSE	15.00

Scale
1" = 880'

12-21-07 REVISED


THIS MAP WAS PREPARED FOR
ASSESSMENT PURPOSE ONLY

SECTION 07 T.40S. R.10E. W.M.
KLAMATH COUNTY

1"=400'

MAP 6 OF 9

MAP CREATED 03/05/2021

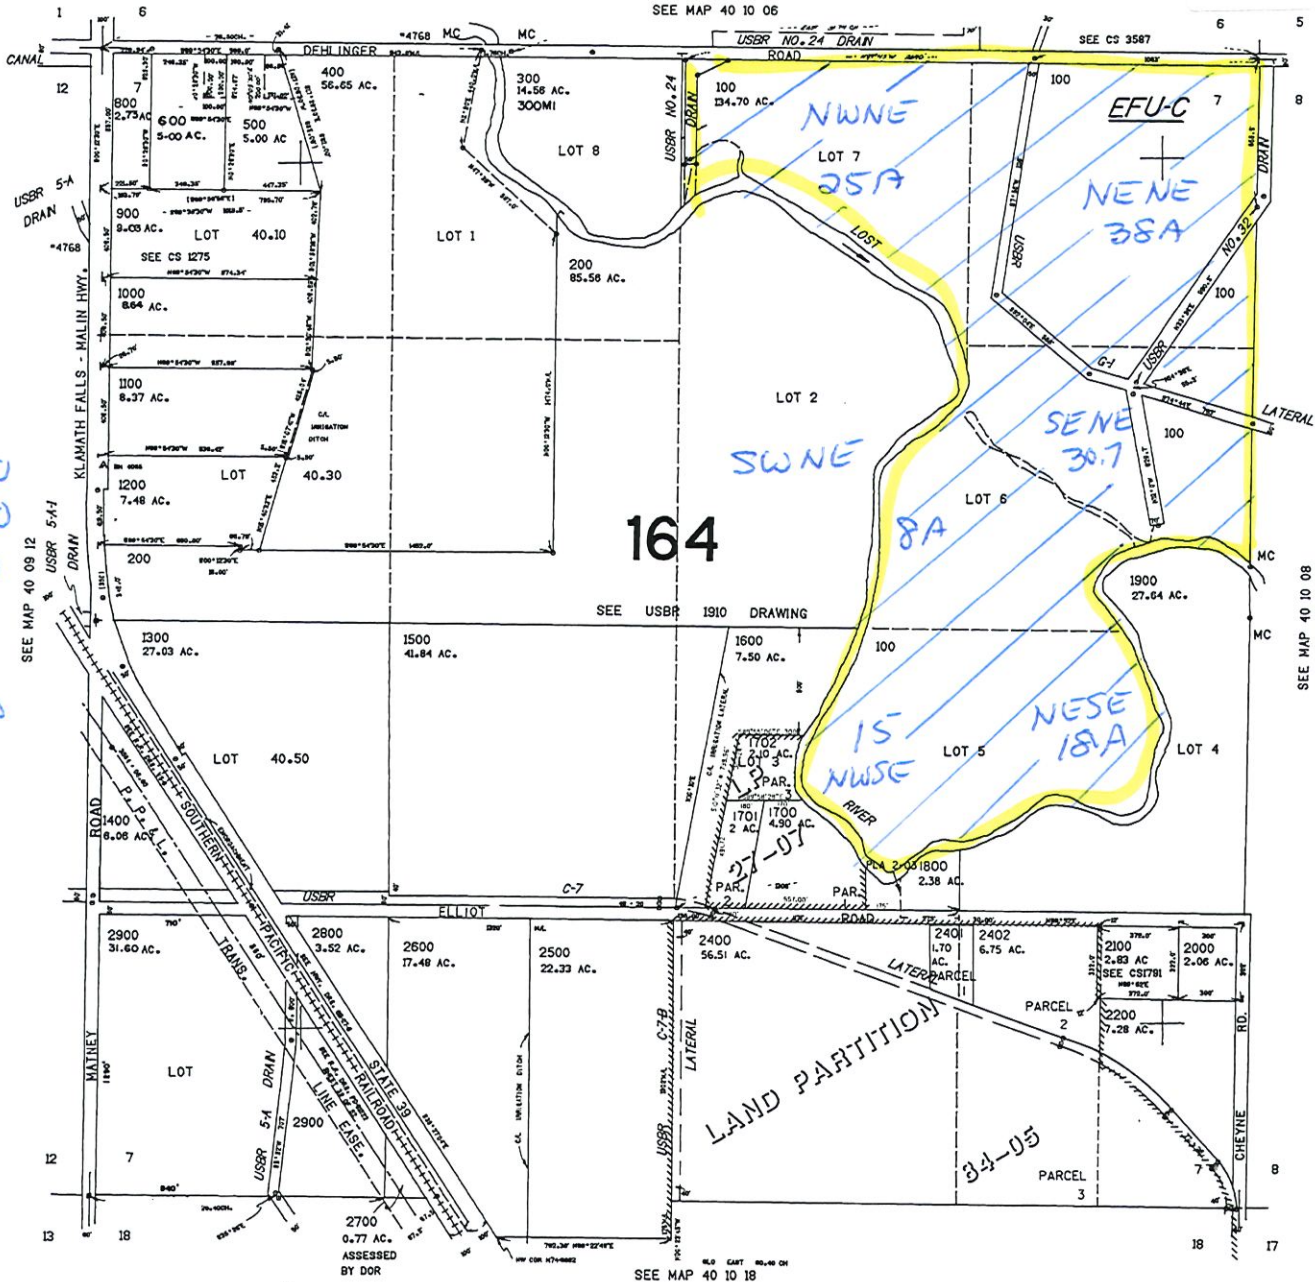

CANCELLED NO.
700
2300

SEE MAP 40 10 08

1676.000

40 10 07

REVISED 10-22-2019

THIS MAP WAS PREPARED FOR ASSESSMENT PURPOSE ONLY

SECTION 08 T.40S. R.10E. W.M.
KLAMATH COUNTY
1" = 400'

MAP 7 OF 9

MAP CREATED 03/08/2021

RECEIVED

APR 05 2021

OWRD


NORTH
T40S R10E
SEC 8

Tax lot

400	NENW	16.20
700	NENW	7.00
	NWNW	6.24
800	NWNW	25.00
	SWNW	40.00
901	SENW	36.00
	SWNE	20.00
	NESW	34.26
	NWSE	10.00

Scale

1" = 880'

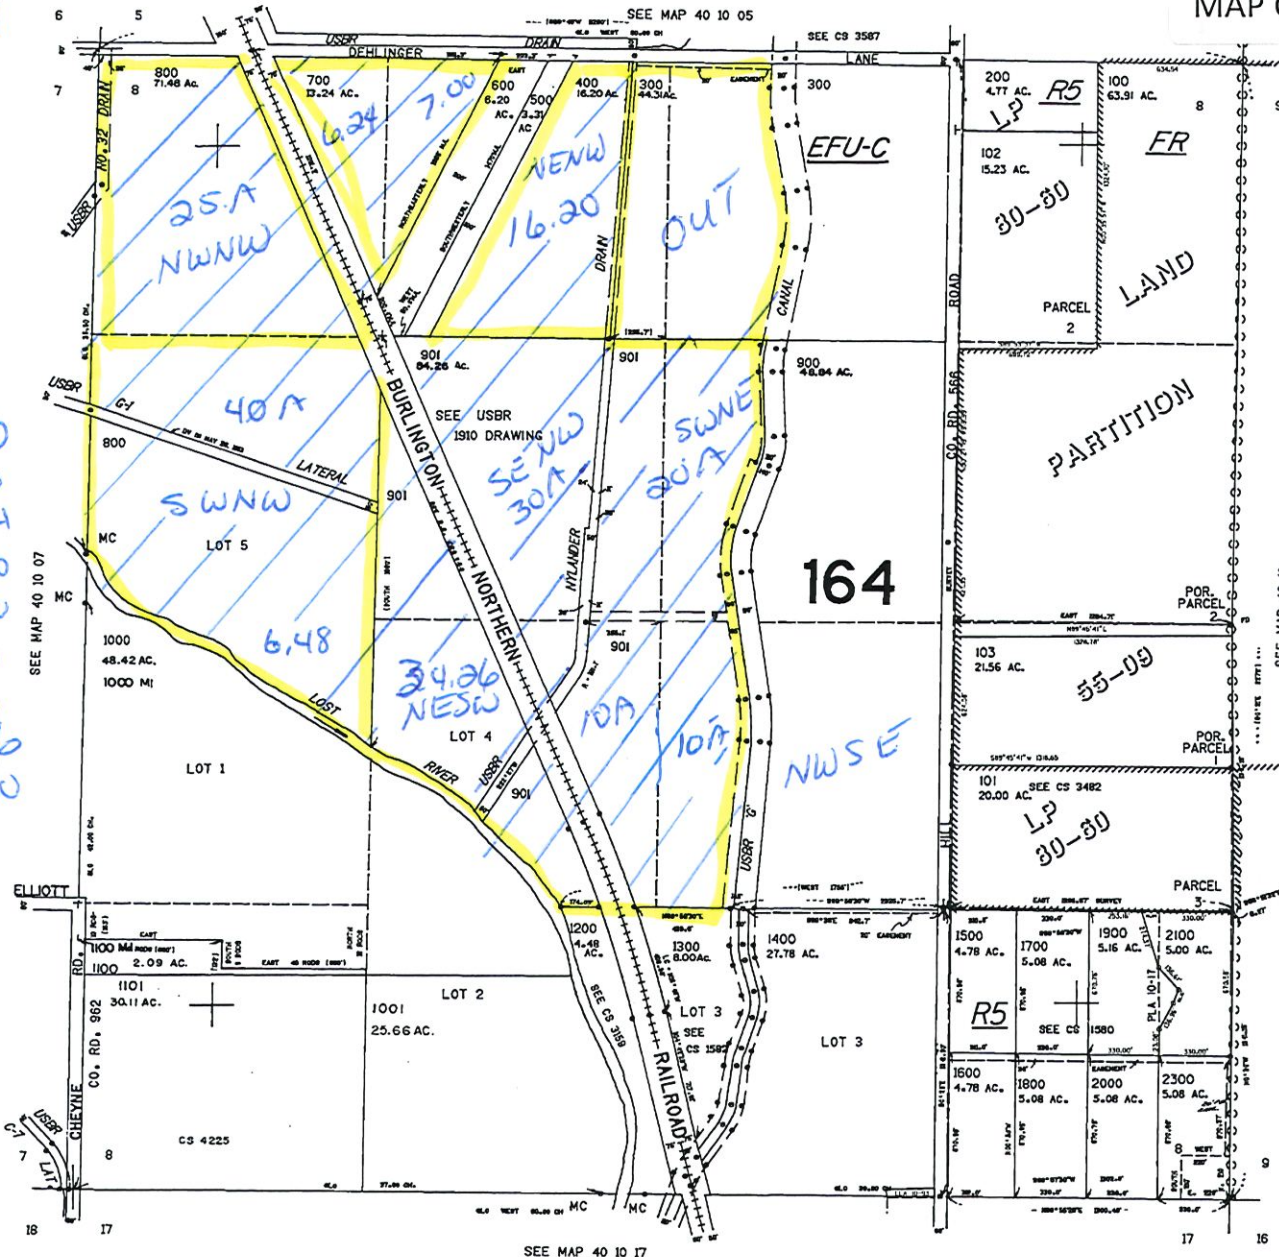

CANCELLED NO. 2200

164

SEE MAP 40 10 10

160.000

SEE MAP 40 10 17

RECEIVED

APR 05 2021

MAP 8 OF 9

MAP CREATED 03/05/2021

THIS MAP WAS PREPARED FOR ASSESSMENT PURPOSE ONLY.

SECTION 20 T.40S. R.10E. W.M. KLAMATH COUNTY


1"=400'

OWRD

NORTH T40S R10E SEC. 20

Tax lot
200 SENE 26.98
1000 NESE 40.0
SESE 7.00

Scale
1"=880'

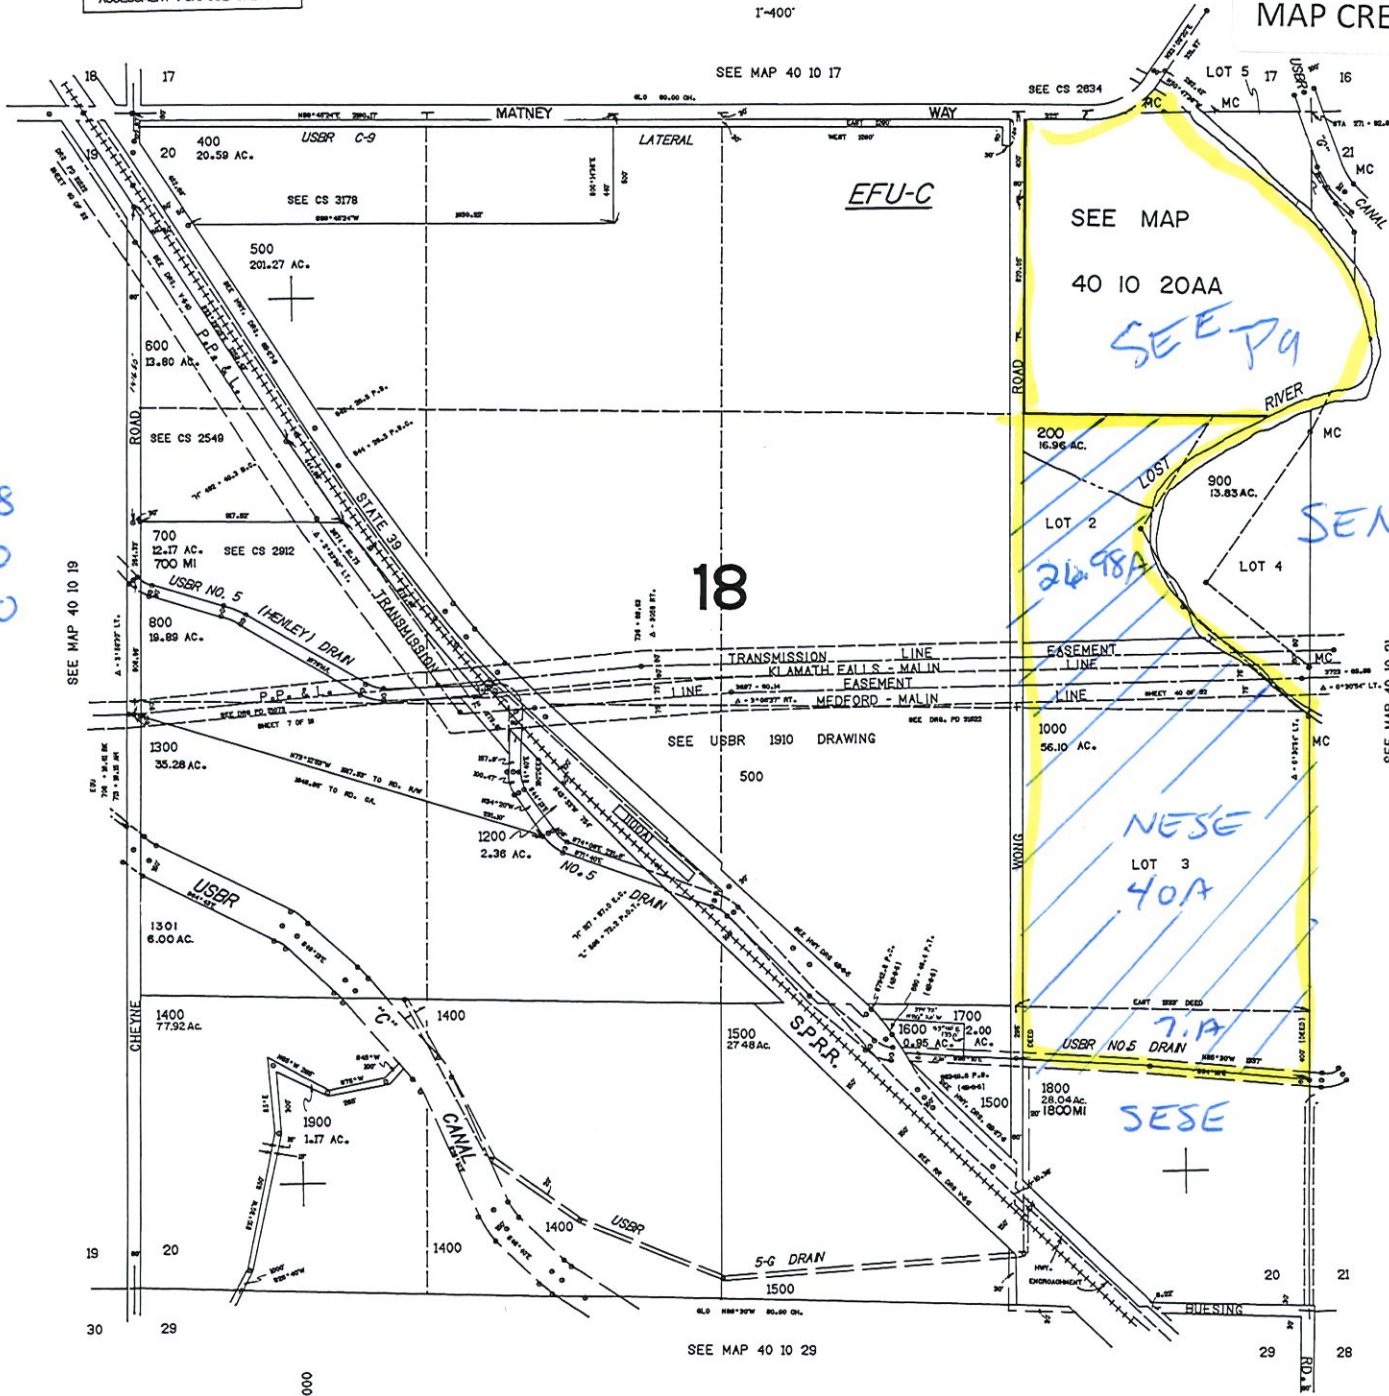

40 10 20

REVISED 7-09-07

THIS MAP WAS PREPARED FOR
ASSESSMENT PURPOSE ONLY


NE1/4 NE1/4 SEC. 20 T.40S. R.10E. W.M.
KLAMATH COUNTY
1" = 100'

MAP 9 OF 9

MAP CREATED 03/05/2021

↑
NORTH
T40S R10E
SEC. 20AA
Tax lot
300 NENE 4.91
400 NENE 1.96
500 NENE 36.65

Scale
1" = 228'

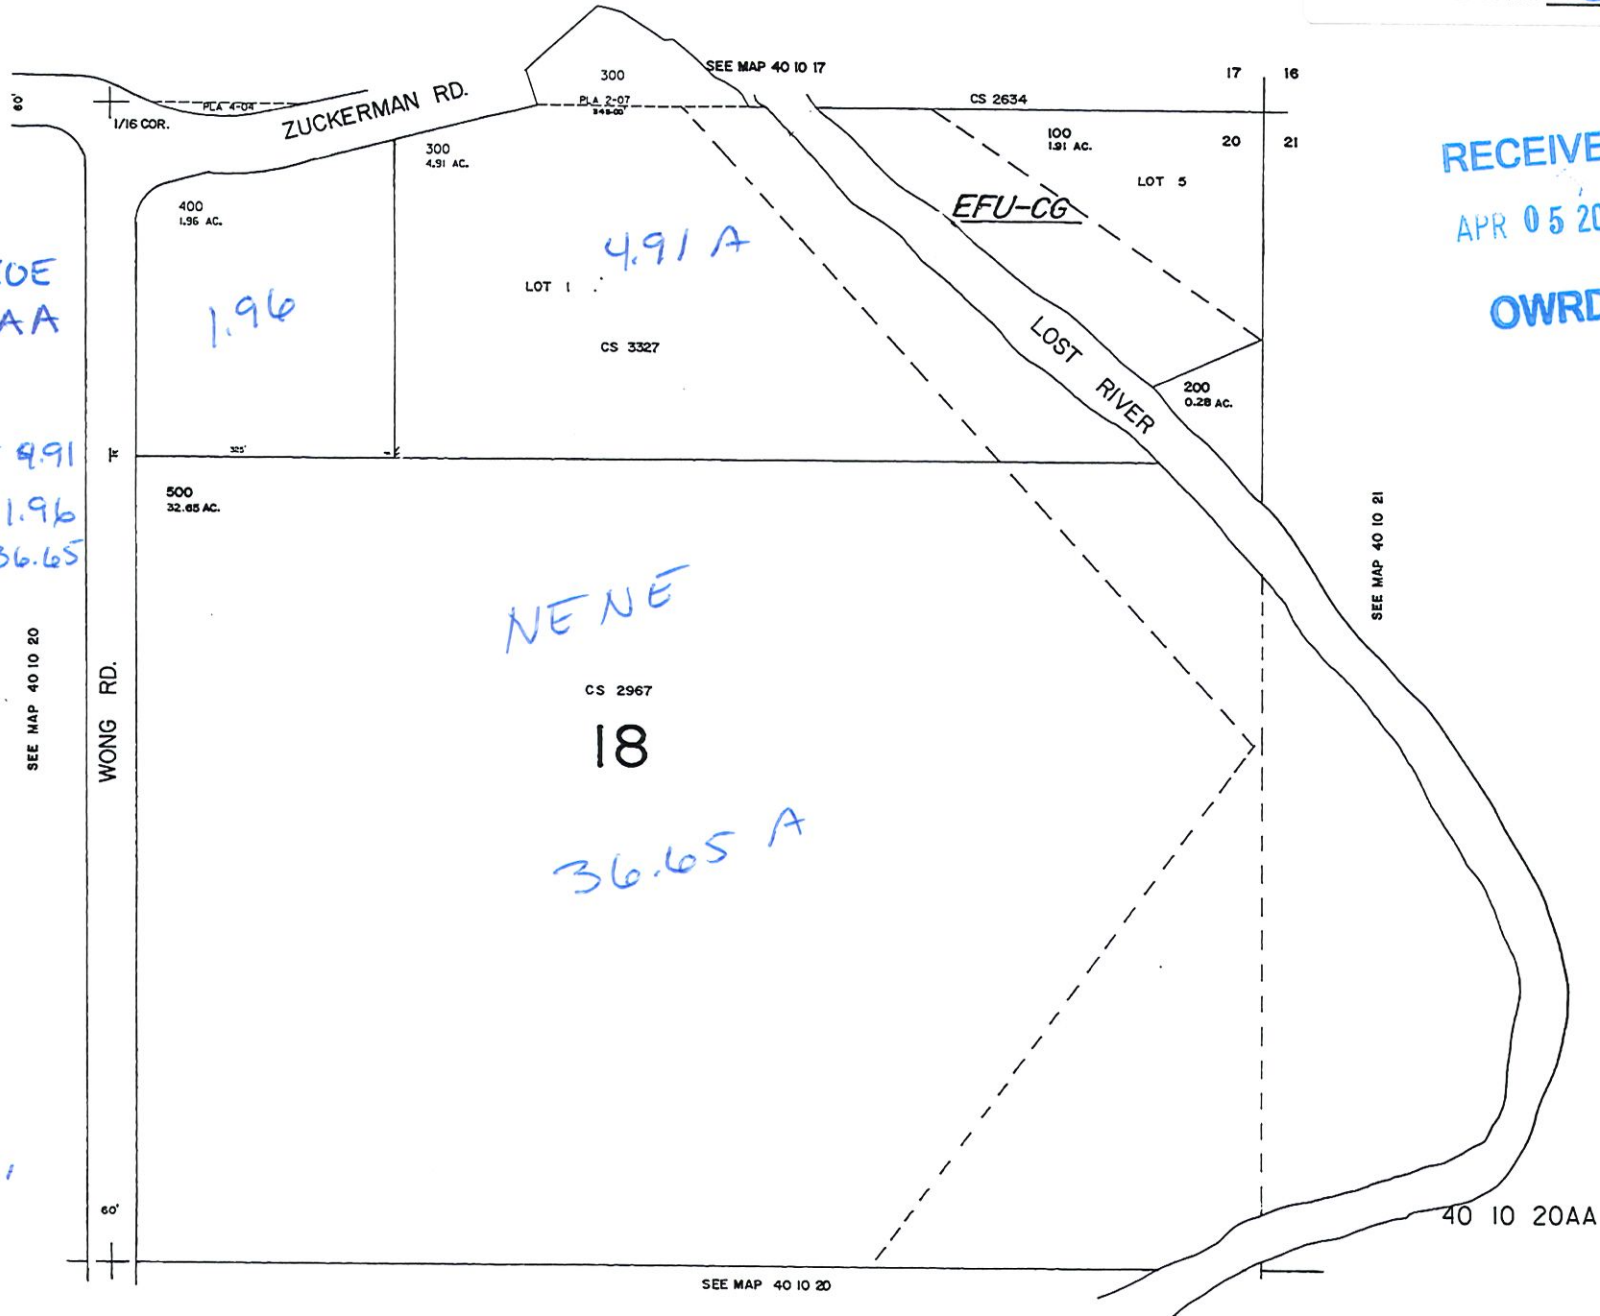

RECEIVED
APR 05 2021
OWRD