


T.7 S. R. 1E. W.M.

7L 900

DEC 1 1994

WATER RES. DIV.
SALEM, OR

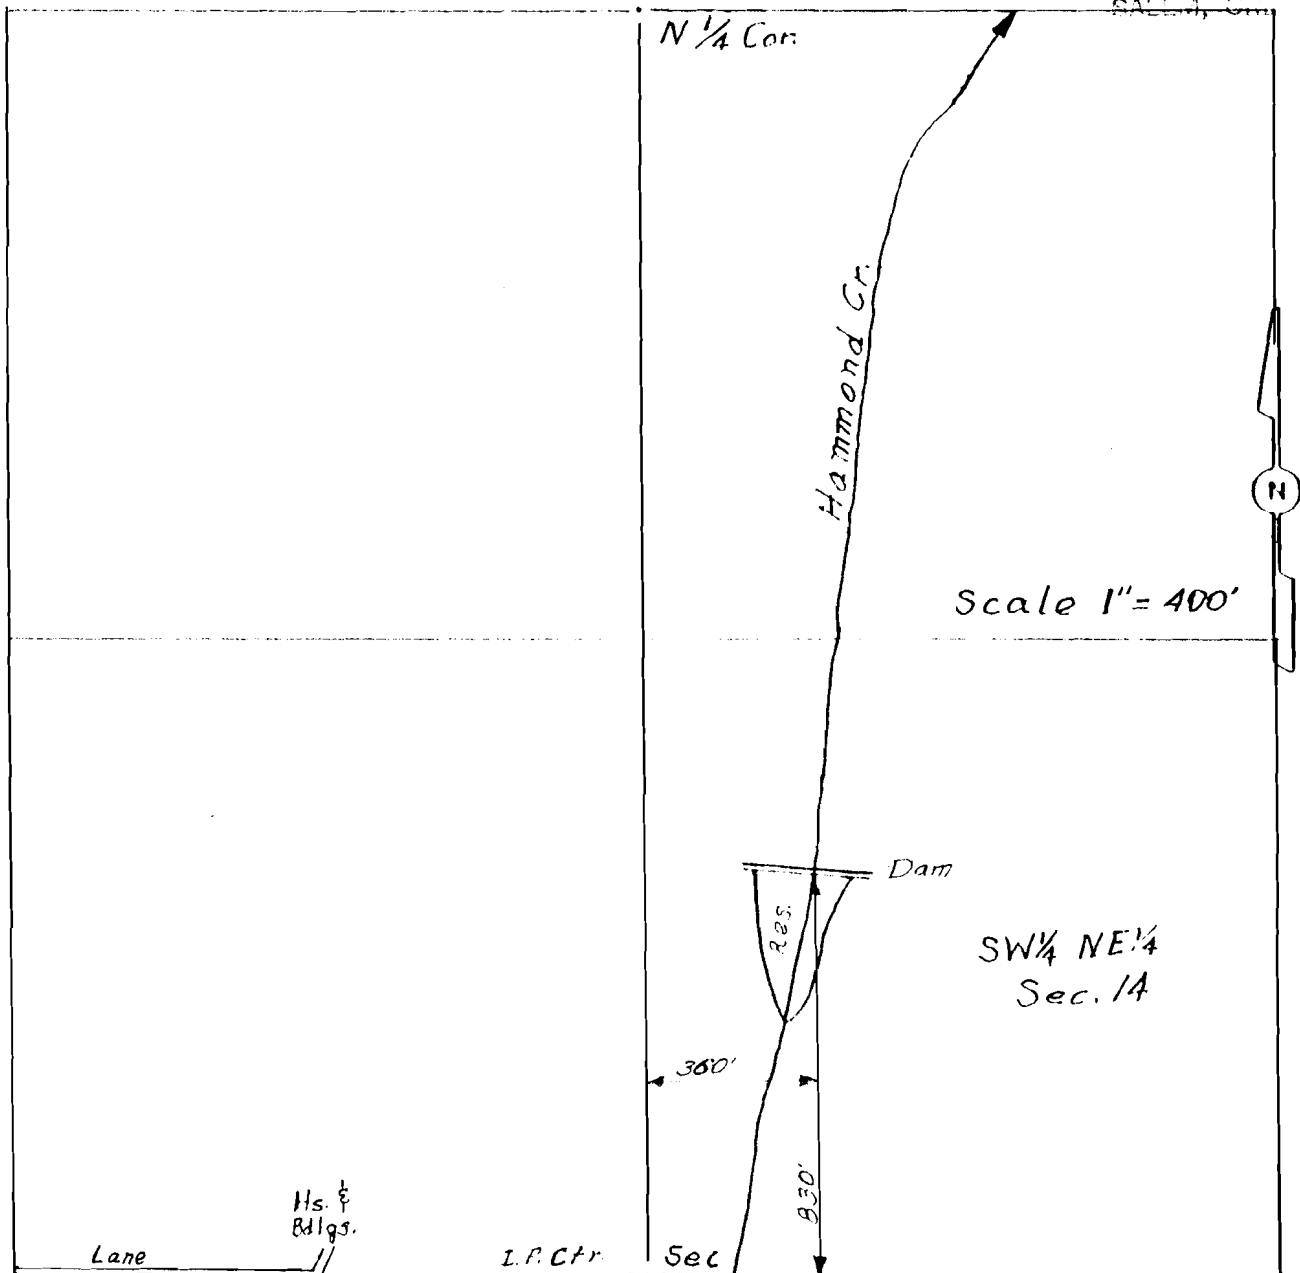

WATER RIGHT MAP FOR
CHUCK GOODE

THIS MAP WAS PREPARED FOR THE
PURPOSE OF IDENTIFYING THE LOCA-
TION OF A WATER RIGHT ONLY AND IS
NOT INTENDED TO PROVIDE LEGAL
DIMENSIONS OR LOCATION OF PROPER-
TY OWNERSHIP LINES.

Permit #

R11693

App # R75111

