


RECEIVED

FEB 25 1997

Section 14 T.6S, R.2E, W.M.

WATER RESOURCES DEPT
SALEM, OREGON

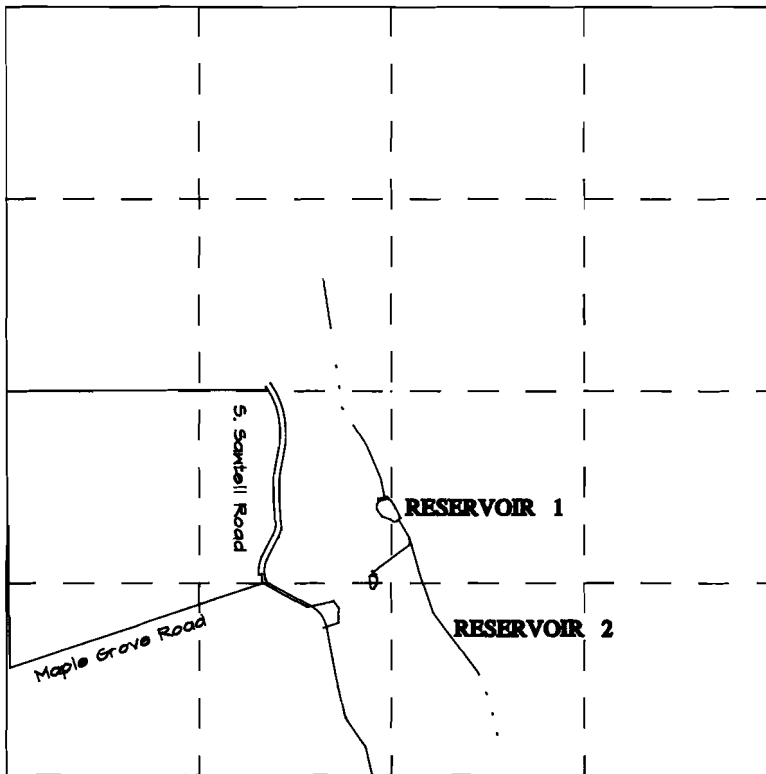

Scale 1" = 1320'

Reservoir 1 is 3,387 feet south and 2,583 feet east of the N.W. corner of Section 14.

Reservoir 2 is 3,917 feet south and 2,525 feet east of the N.W. corner of Section 14.

BENEFICIAL USE MAP
FOR
ROBERT SCHWARTZ

APPLIC. NO. R 72866 PERMIT NO. R 11674

THE PREPARATION OF THIS MAP IS FOR THE PURPOSE OF IDENTIFYING THE LOCATION OF THE WATER RIGHT ONLY AND HAS NO INTENT TO PROVIDE DIMENSIONS OR LOCATION OF PROPERTY OWNERSHIP LINES.

