

Hamel
Enman

THIS MAP WAS PREPARED FOR
ASSESSMENT PURPOSE ONLY.


SECTION 20 T.40S. R.10E. W.M.
KLAMATH COUNTY

1"=400'

MAP 1 OF 3

MAP CREATED 2/05/2021

NORTH

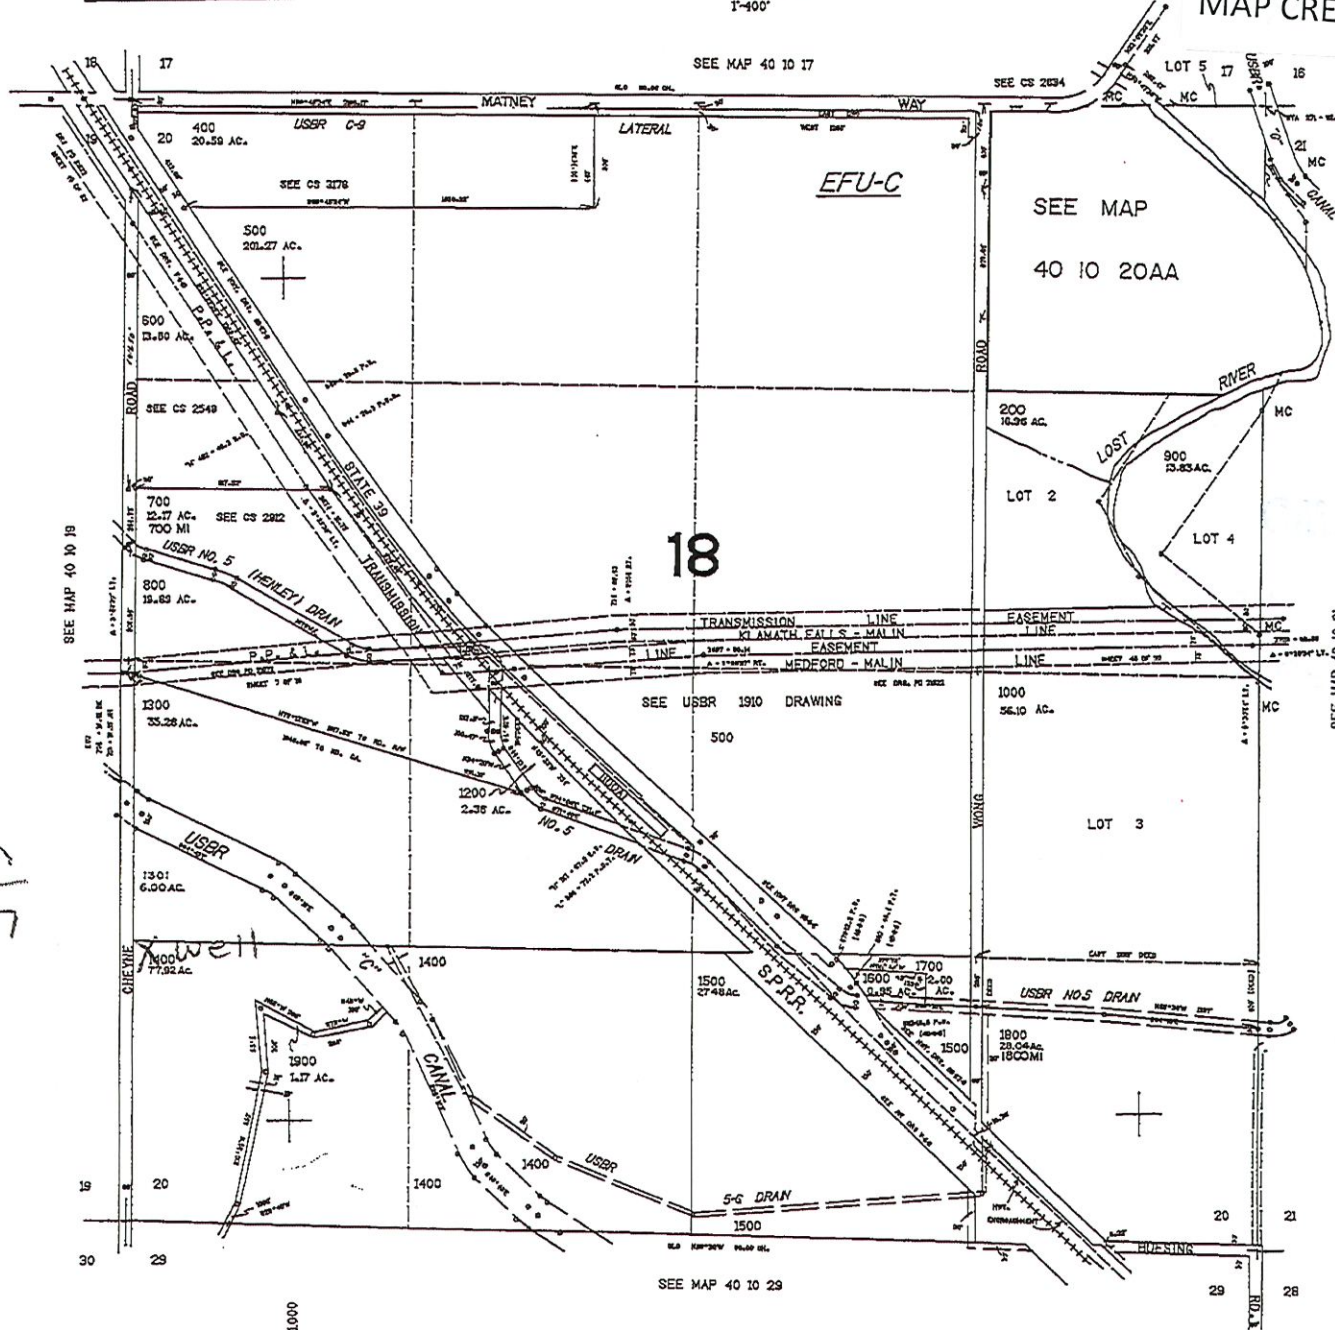

Well location
KLAM 52647
42.0714
-121.6785

Scale
1" = 880'

RECEIVED
APR 19 2021
OWRD

REVISED 07-01-14
THIS MAP WAS PREPARED FOR
ASSESSMENT PURPOSE ONLY

SECTION 17 T.40S. R.10E. W.M.
KLAMATH COUNTY


1"=400'

MAP 2 OF 3

MAP CREATED 04/14/2021

NORTH ↑
T40S R10E
SEC 17
Tax lot
1500 SWSW 34.87
SESW 34.84

RECEIVED
APR 19 2021
OWRD

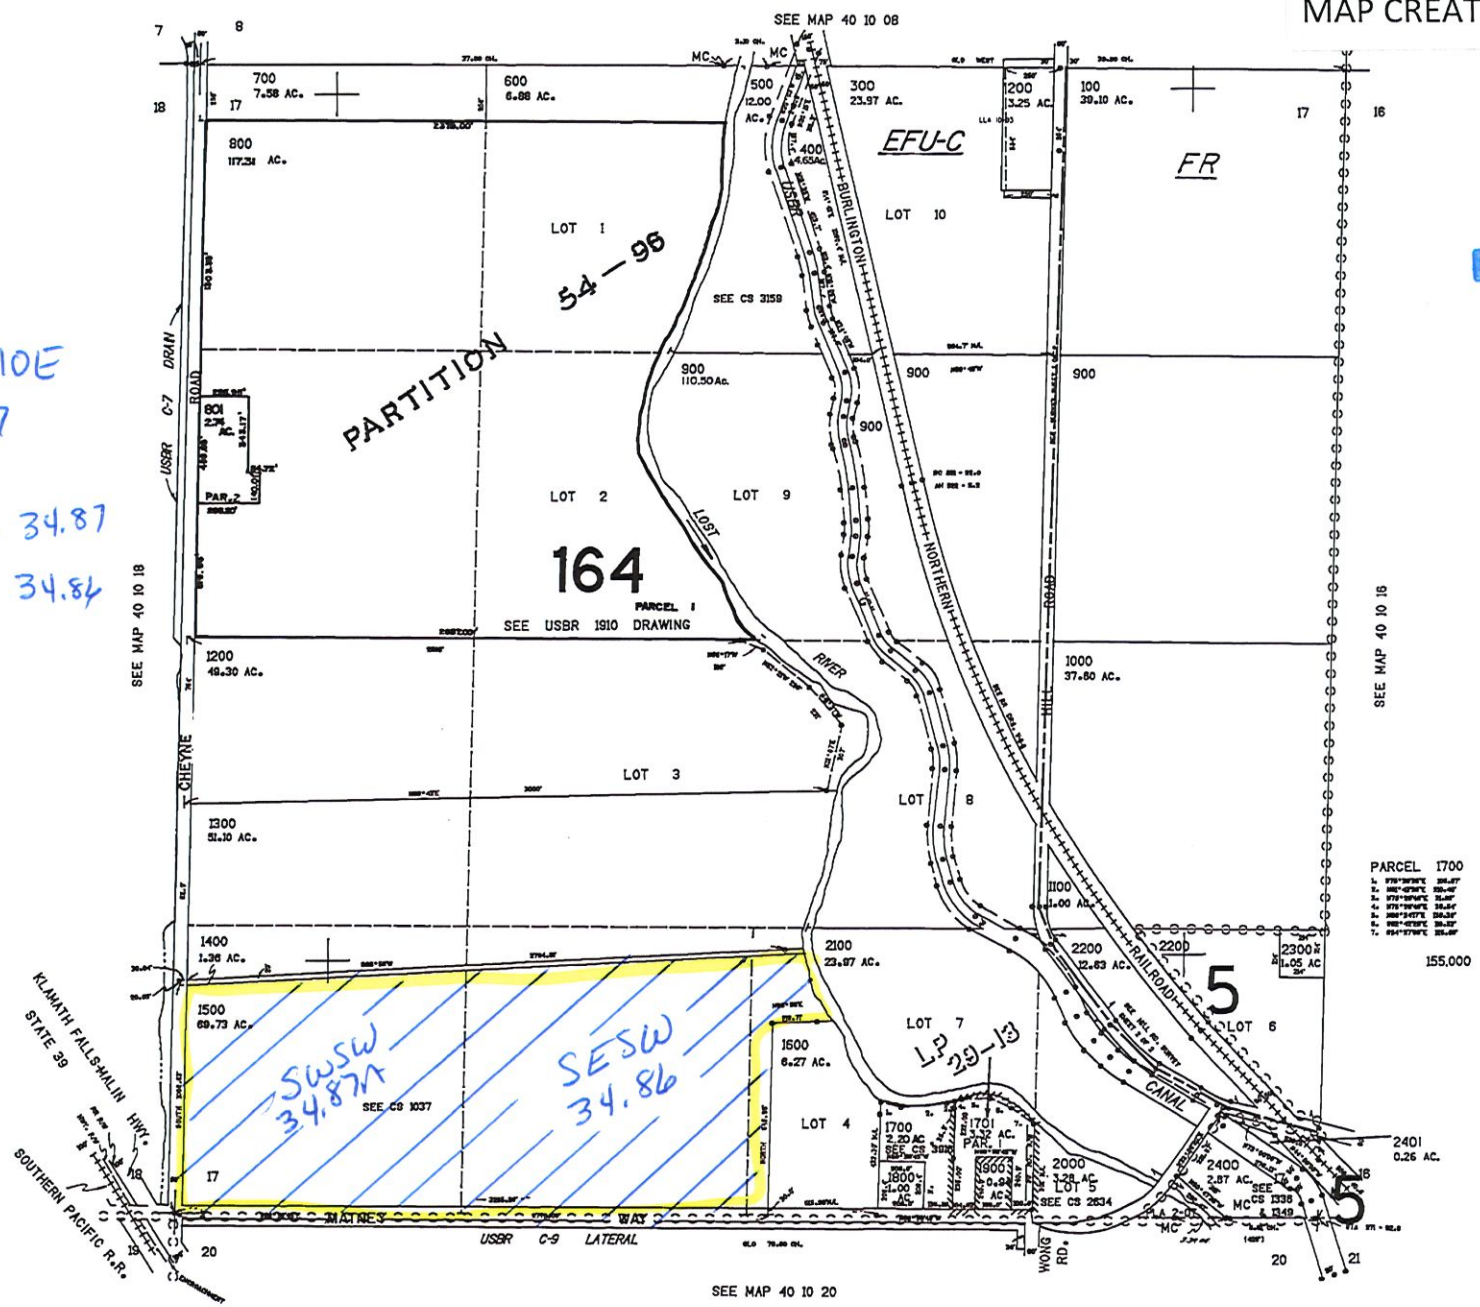

Scale
1" = 880'

16810000

40 10 17

REVISED 04-06-15
 THIS MAP WAS PREPARED FOR
 ASSESSMENT PURPOSE ONLY


SECTION 03 T.41S. R.10E. W.M.
 KLAMATH COUNTY
 1"=400'

MAP 3 OF 3

MAP CREATED 04/14/21

NORTH
 T41 S R10E
 Sec 03
 Tax Lot
 200
 NENE 20.00
 NWNE 11.09
 SWNE 38.00
 SENE 38.00

Scale
 1" = 880'

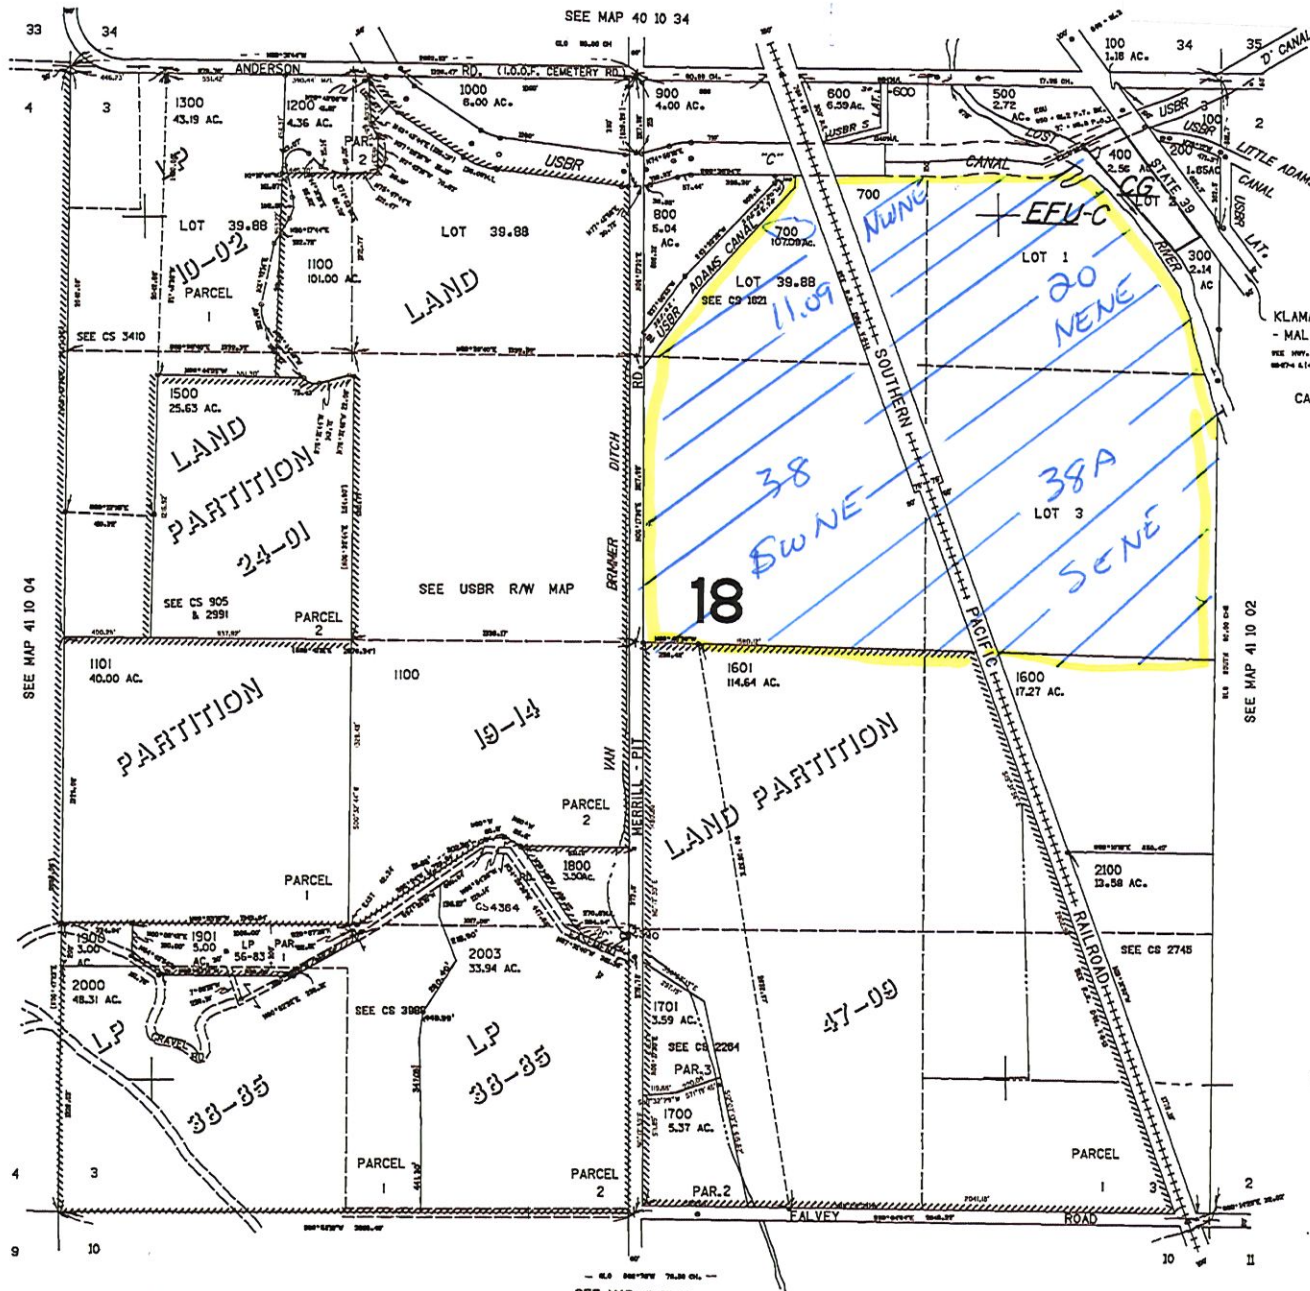

KLAMATH FALLS
 - MALIN HWY.
 SEE MAP, DISTRICT
 MAPS 41 (1985)

CANCELLED NO.
 1400
 2002

RECEIVED
 APR 19 2021
 OWRD

SEE MAP 41 10 04

SEE MAP 41 10 02

SEE MAP 41 10 10

41 10 03