

LAURELWOOD, OR
1956

R 15134

69400

16 Bald Peak
MAM 1629

BALD PEAK
STATE PARK

Microwave
Sta

BM 183

PEAK
BM 1114

47

R-17
H-16

Christensen

31-5

DIXON 31

SALLE ROAD

Hill Cem

Hill School

41

18

57

WASHINGTON CO
YAMHILL CO

Iowa Hill

32

5

49

500

48

17

1000

600

500

500

600

1000

500

500

500

600

800

800

900

900

1000

800

800

900

900

1000

800

800

900

900

1000

800

800

1100

1100

1400

YCOMB

RD

MILL

300

300

300

200

200

200

200

200

600

900

600




















511-3TL770

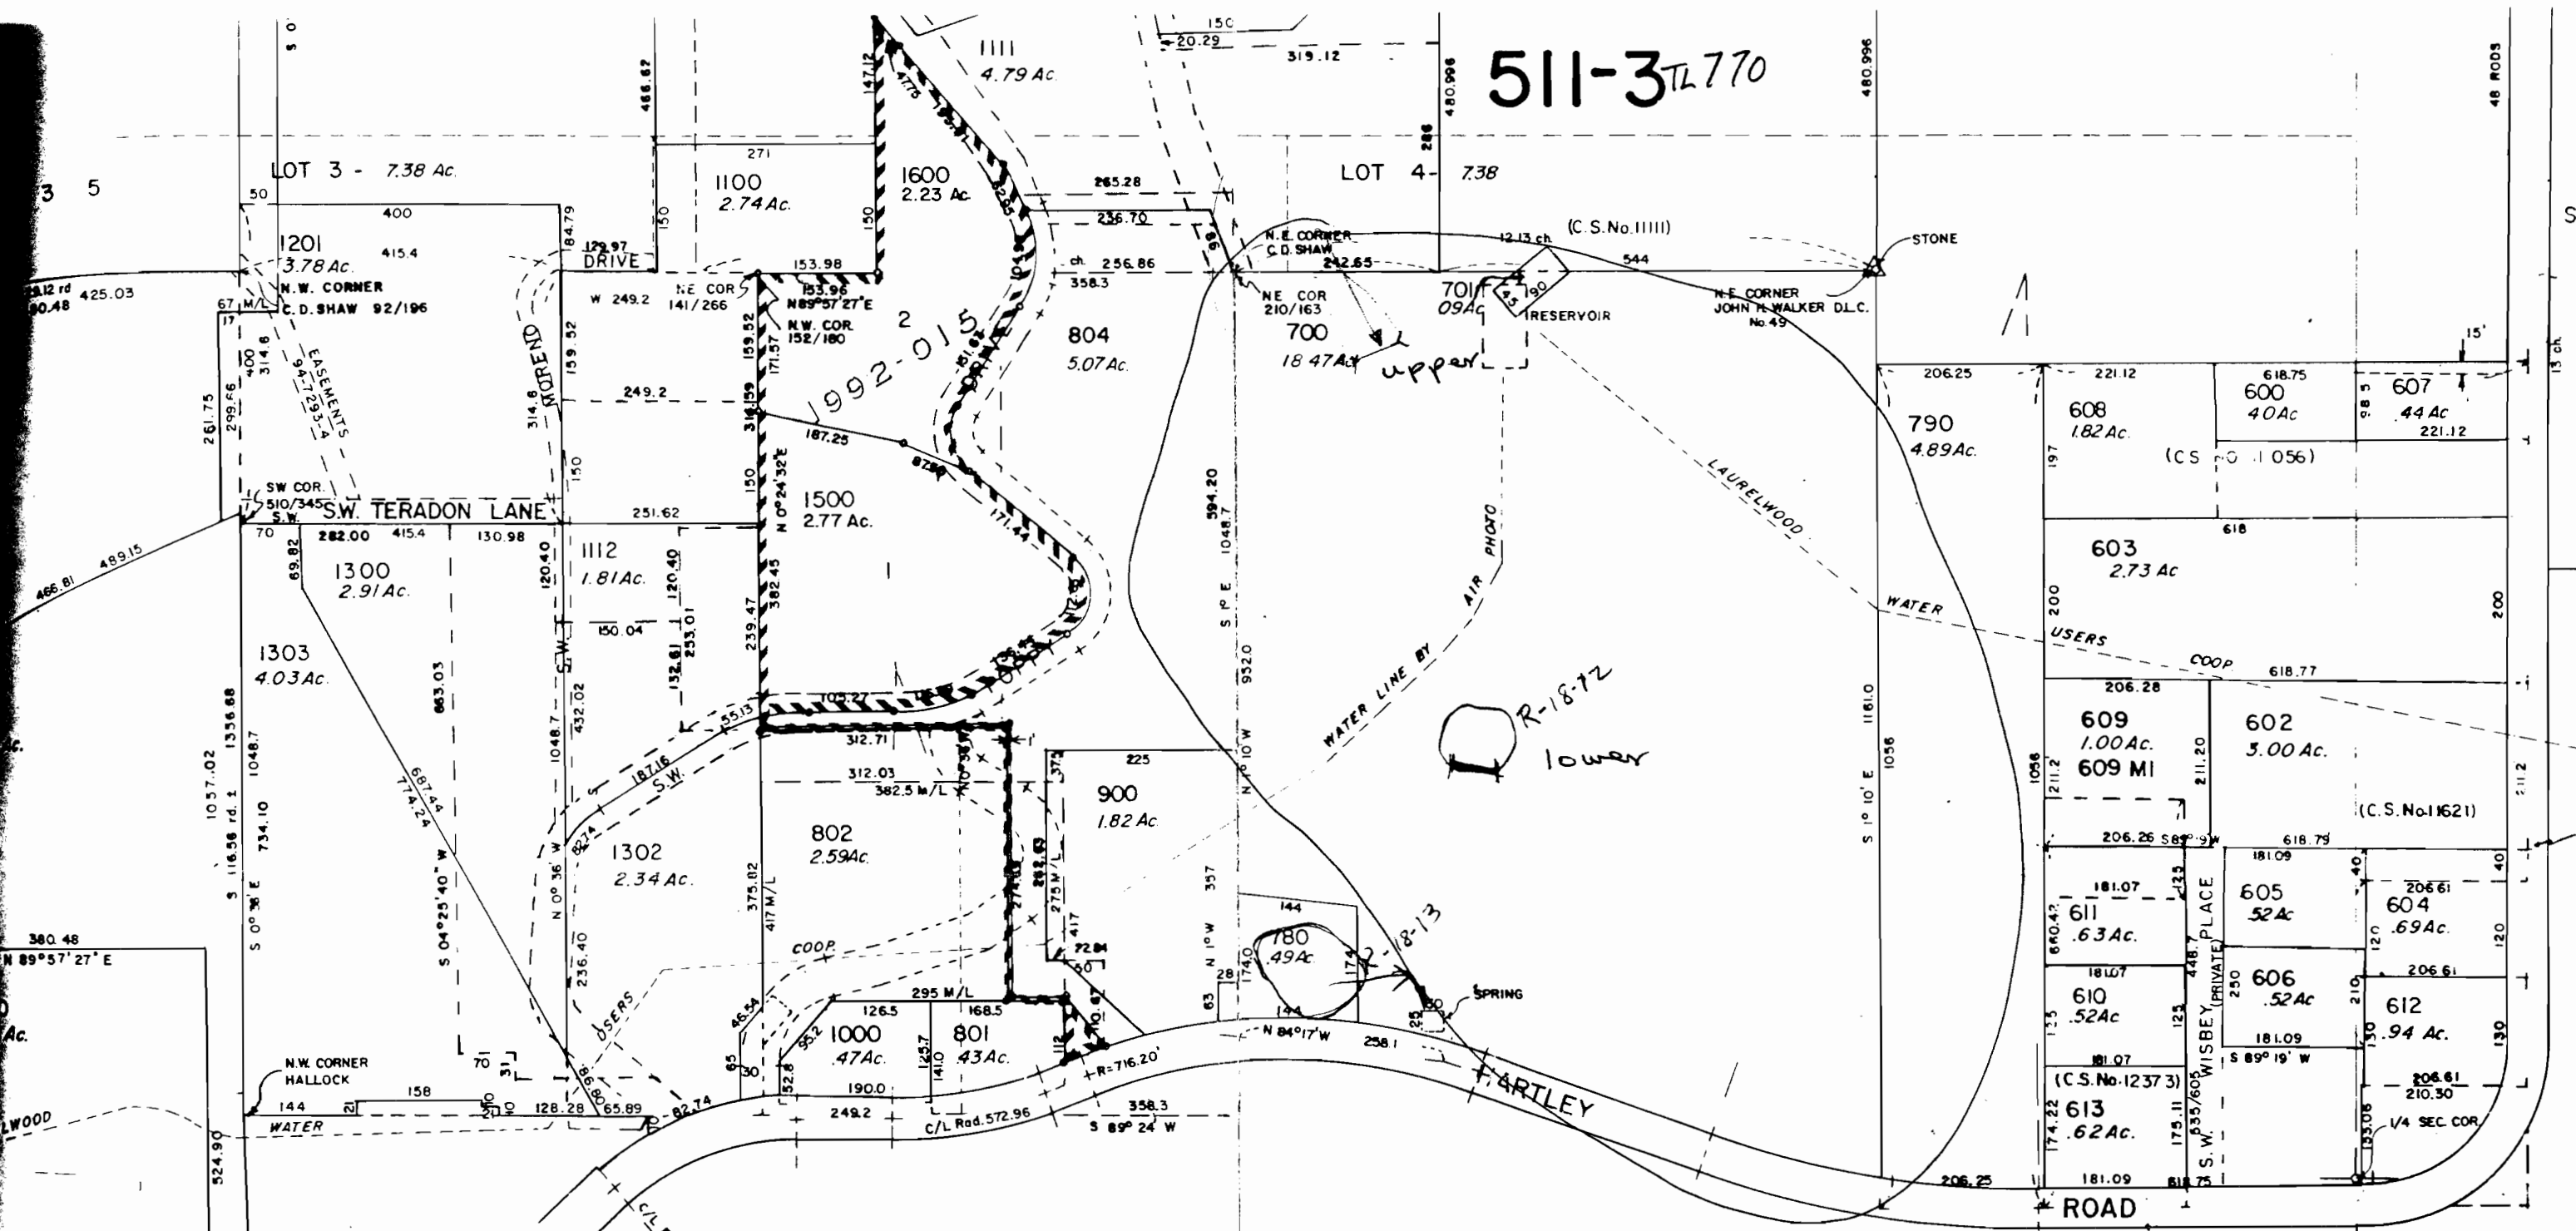

SEE MAP 2S 3 5DB

SEE MAP 2S 3 5

SEE MAP 2S 3 4C

FOR ASSESSMENT PURPOSES ONLY
DO NOT RELY ON FOR ANY OTHER USE

"CERTIFICATE NO. 69400"

R75134

2S 3 5A

2S

ASSESSMENT