

Horsley

MAP 1 OF 4

THIS MAP WAS PREPARED FOR
ASSESSMENT PURPOSE ONLY

SECTION 31 T.39S. R.09E. W.M.
KLAMATH COUNTY

1"=400'

MAP CREATED _____


map created
02/05/2021

RECEIVED

APR 26 2021

OWRD

↑
N

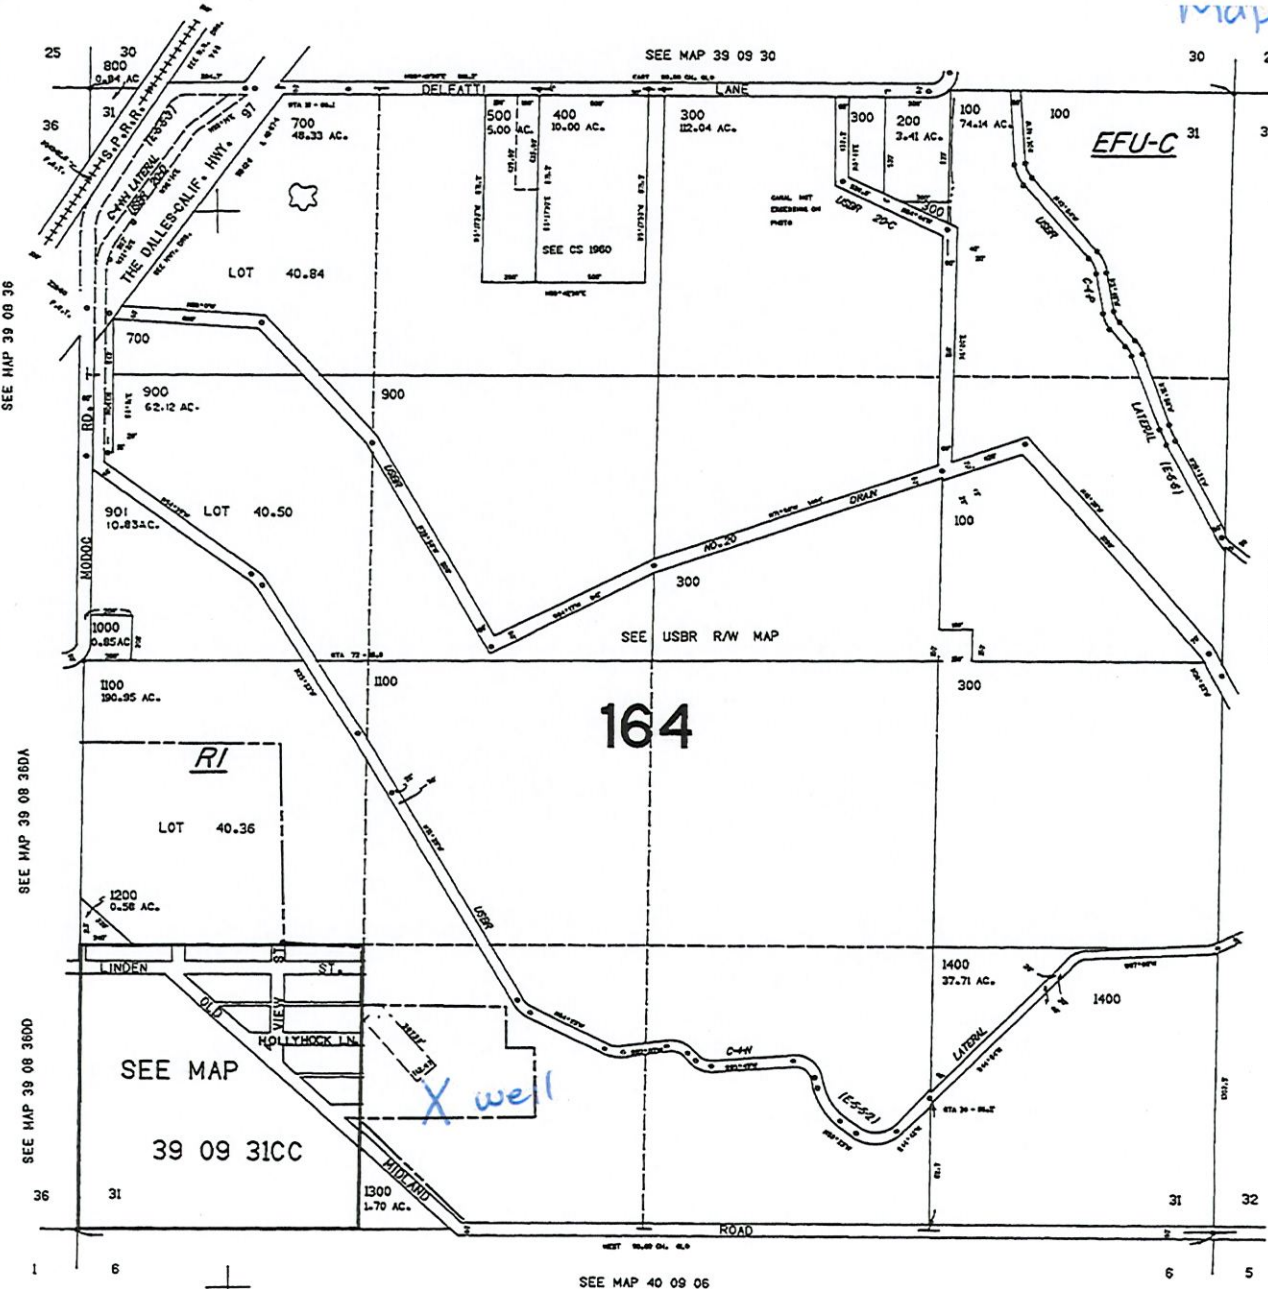

+ 175.000

CANCELLED NO.
600

Well location
KLAM 51231
42.1276
-121.8092

+ 39 09 31
& INDEX

RECEIVED

APR 26 2021

OWRD

NORTH
T39S R09E
SEC. 31

Tax lot
300 NESE 40.00

Scale

1" = 880'


THIS MAP WAS PREPARED FOR
ASSESSMENT PURPOSE ONLY

SECTION 31 T.39S. R.09E. W.M.
KLAMATH COUNTY

1"=400'

MAP 2 OF 4

MAP CREATED 04/08/2021

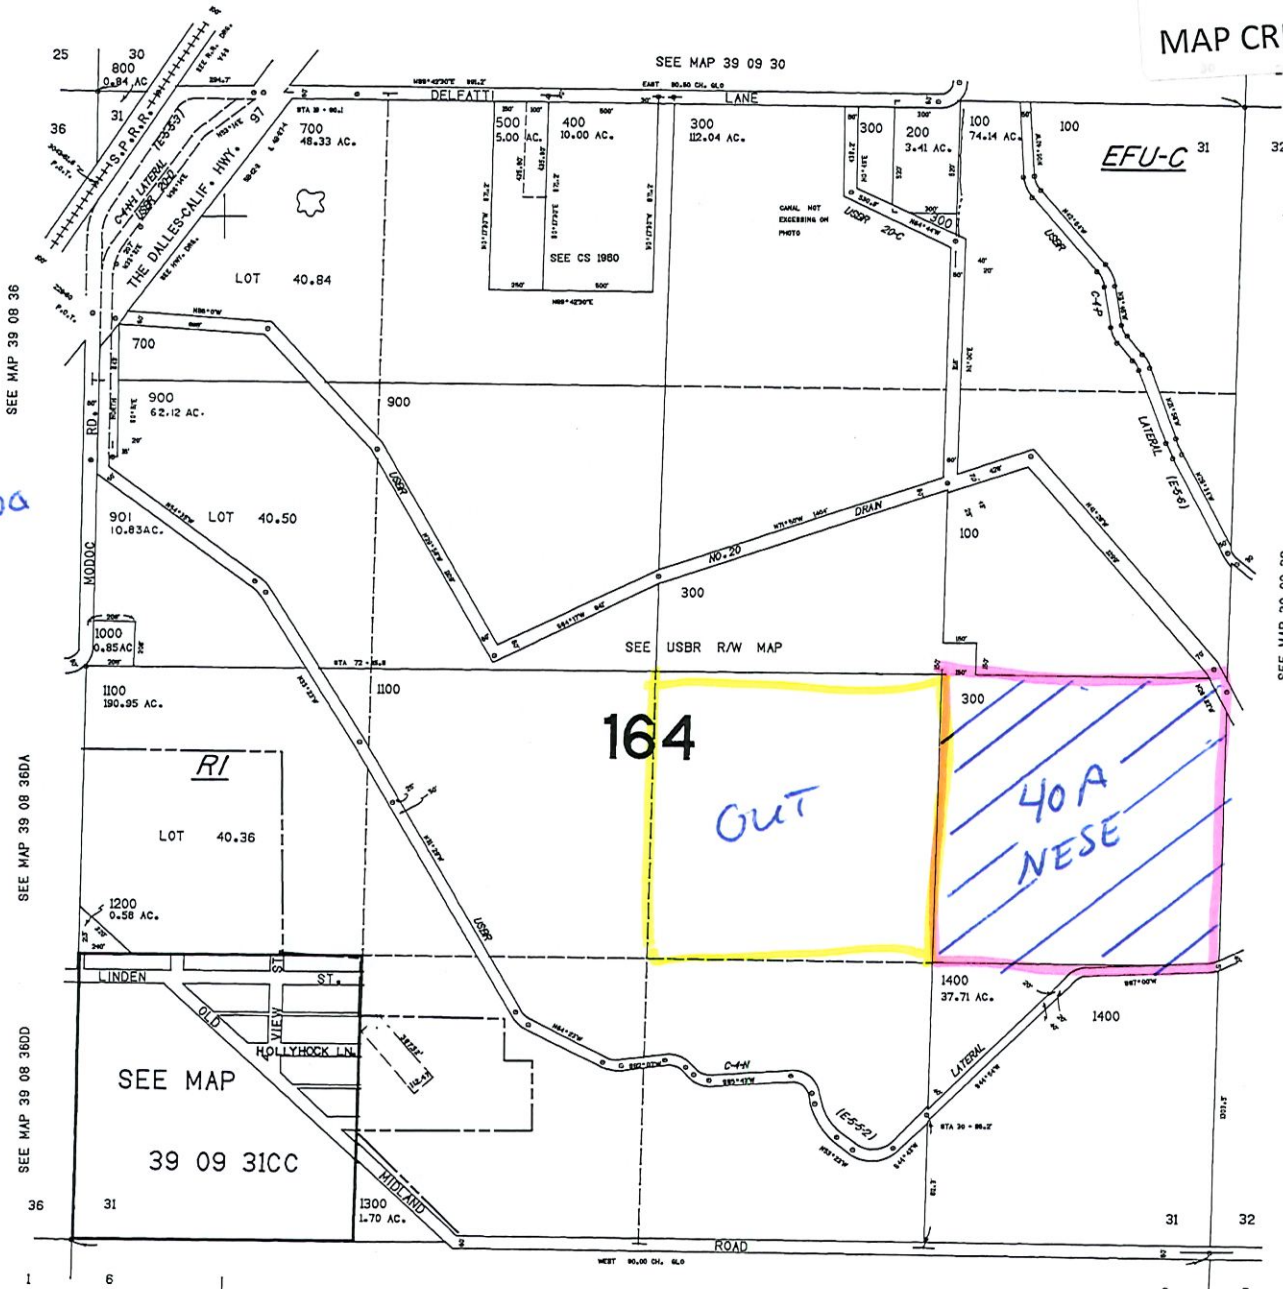

175.000
CANCELLED NO.
600

SEE MAP 39 08 36DA

SEE MAP 39 08 36DD

1

6

SEE MAP 40 09 06

6

5

39 09 31
& INDEX


REVISED 06-16-2016
THIS MAP WAS PREPARED FOR
ASSESSMENT PURPOSE ONLY

SECTION 30 T.39S. R.09E. W.M.
KLAMATH COUNTY

1"=400'

MAP 2 OF 4
39 09 30
MAP CREATED 04/21/2021

NORTH
T39S R09E
SEC 30
Tax lot
1200 SESW 2.00
1300 SWSW 10.00
RECEIVED
APR 26 2021
OWRD

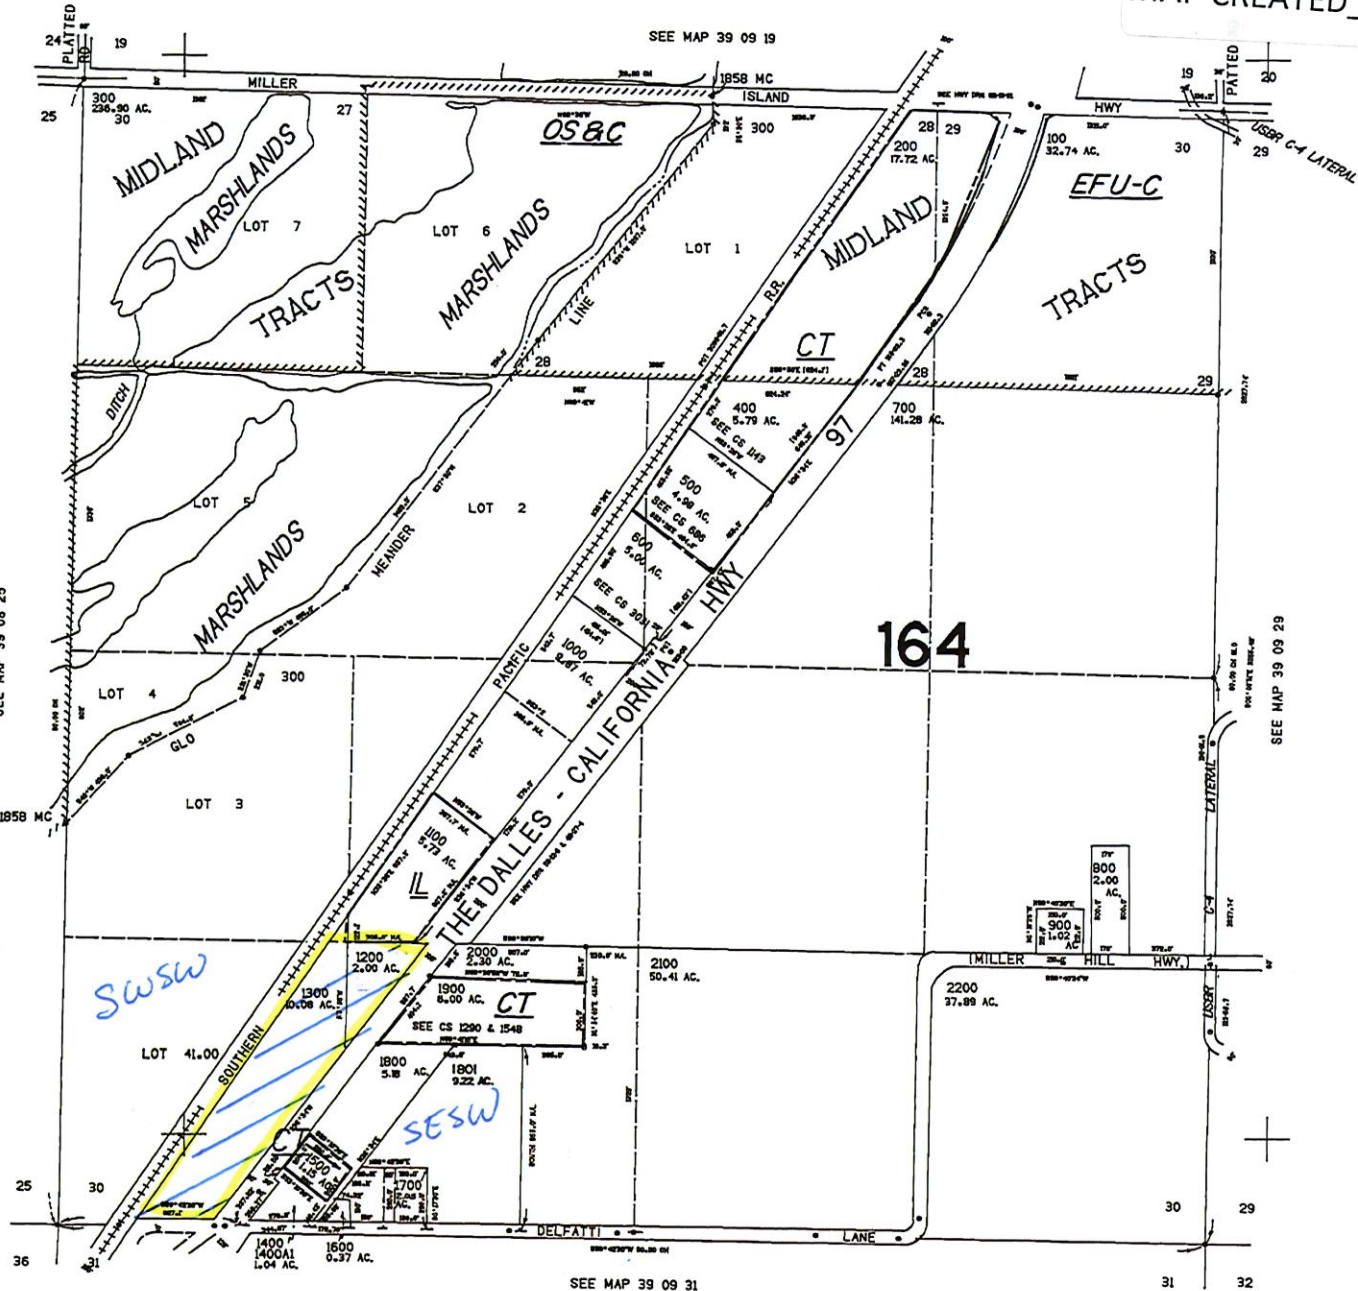

Scale
1" = 880'

176.000

39 09 30

T.40S. R.09E. W.M.
KLAMATH COUNTY

MAP 21 OF 4

REVISED 08-03-2018
THIS MAP WAS PREPARED FOR
ASSESSMENT PURPOSE ONLY

MIDLAND 1" = 2000'

MAP CREATED 04/08/2021

NORTH


T 40S ROSE
Index

Tax lot
4500 SE 1/4
130 Acres

Tax lot
5400 SWSW
40.00

RECEIVED
APR 26 2021

OWRD

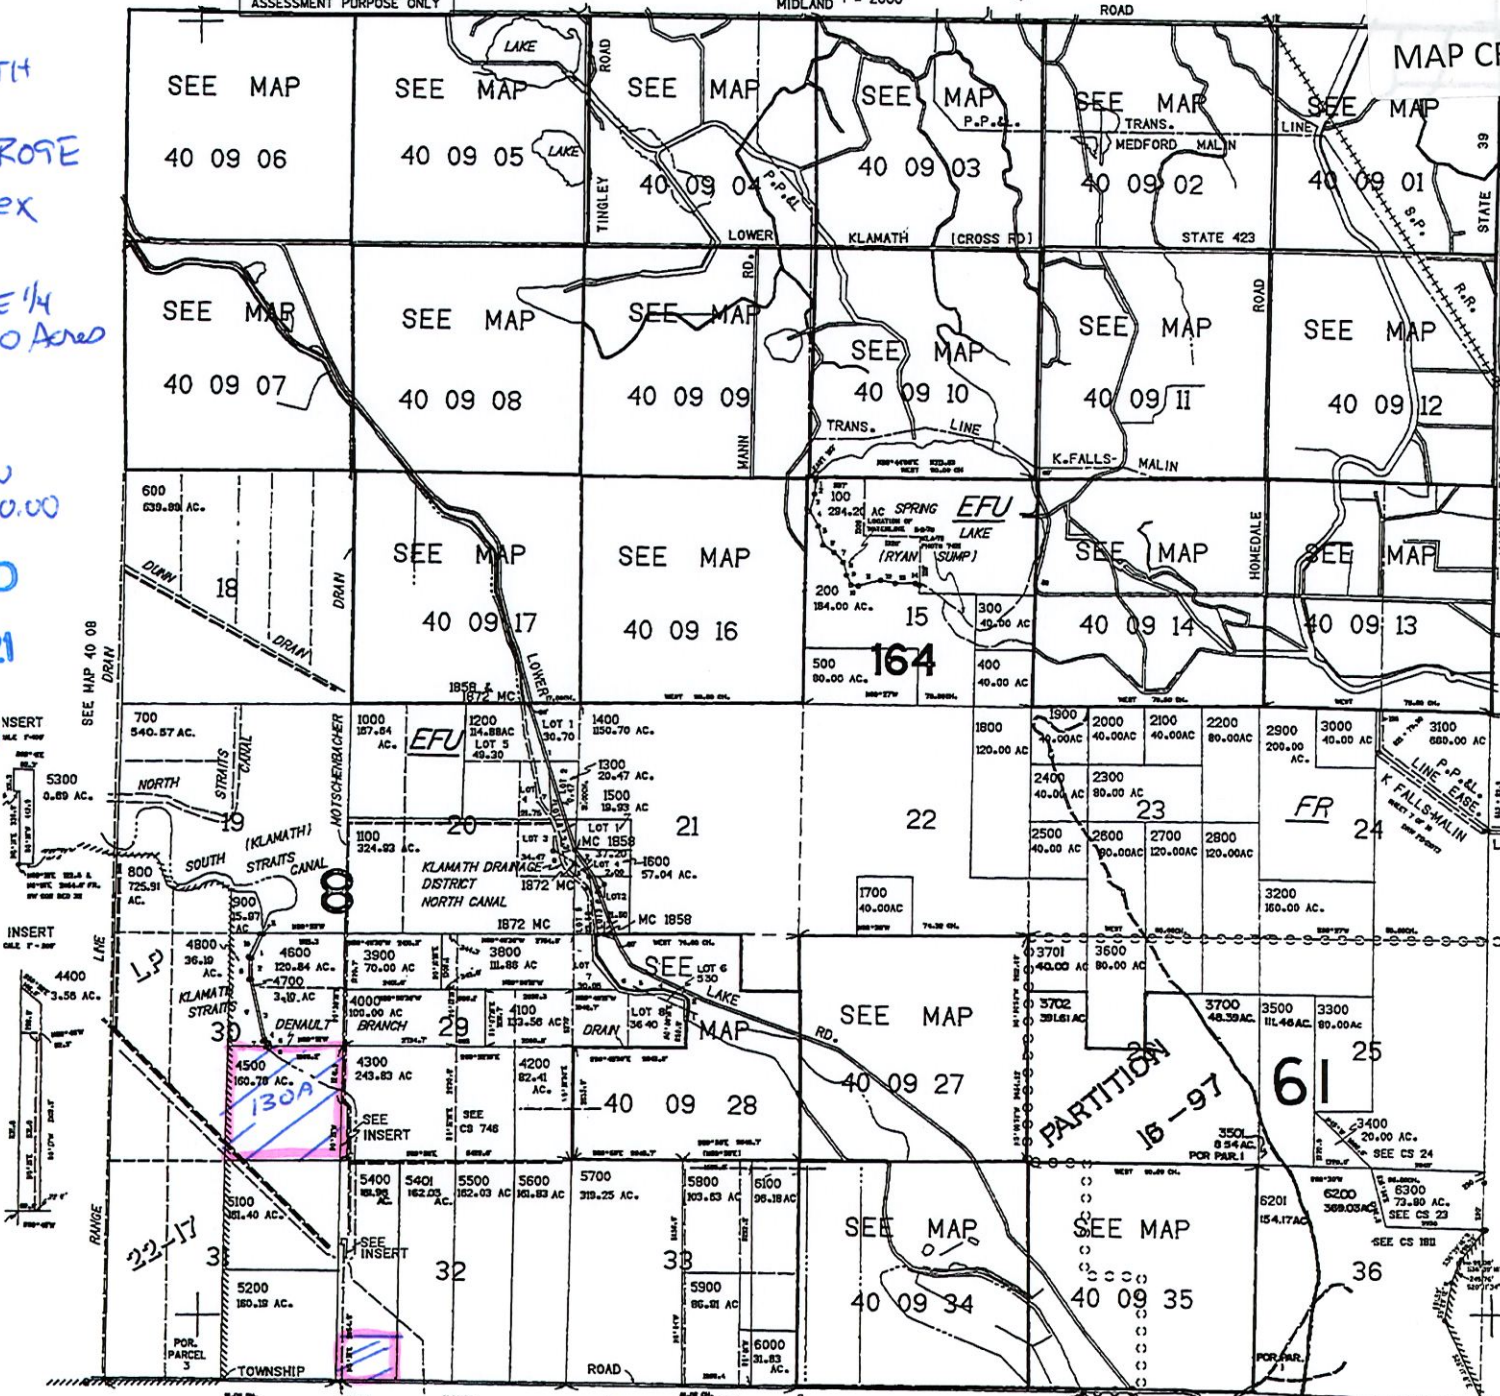

800M - 2100M
2200M - 2300M
2500M - 2600M
2700M - 3500M
3700M - 6200M
6400M
4900
5000

CANCELLED NO.
299 MI INCLUDES
3500M, 3700M
6200M
6400
4900
5000

40 09
& INDEX

- 40 SWSW