



ASSESSMENT & TAX  
CARTOGRAPHY

SECTION 4 T.3S. R.4W. W.M.  
YAMHILL COUNTY OREGON  
1" = 400'

Riverview  
Pond

CANCELLED TAXLOTS:

2100  
2001  
1100  
1001  
300  
302  
301  
202

T 3 S  
R 4 W  
S 4  
Q SE  
1/4 1/4 NW, SW




RECEIVED


APR 12 2021

OWRD

DATE PRINTED: 7/31/2014

This product is for Assessment and Taxation (A&T) purposes only and has not been prepared or is suitable for legal, engineering, surveying or any purposes other than assessment and taxation.

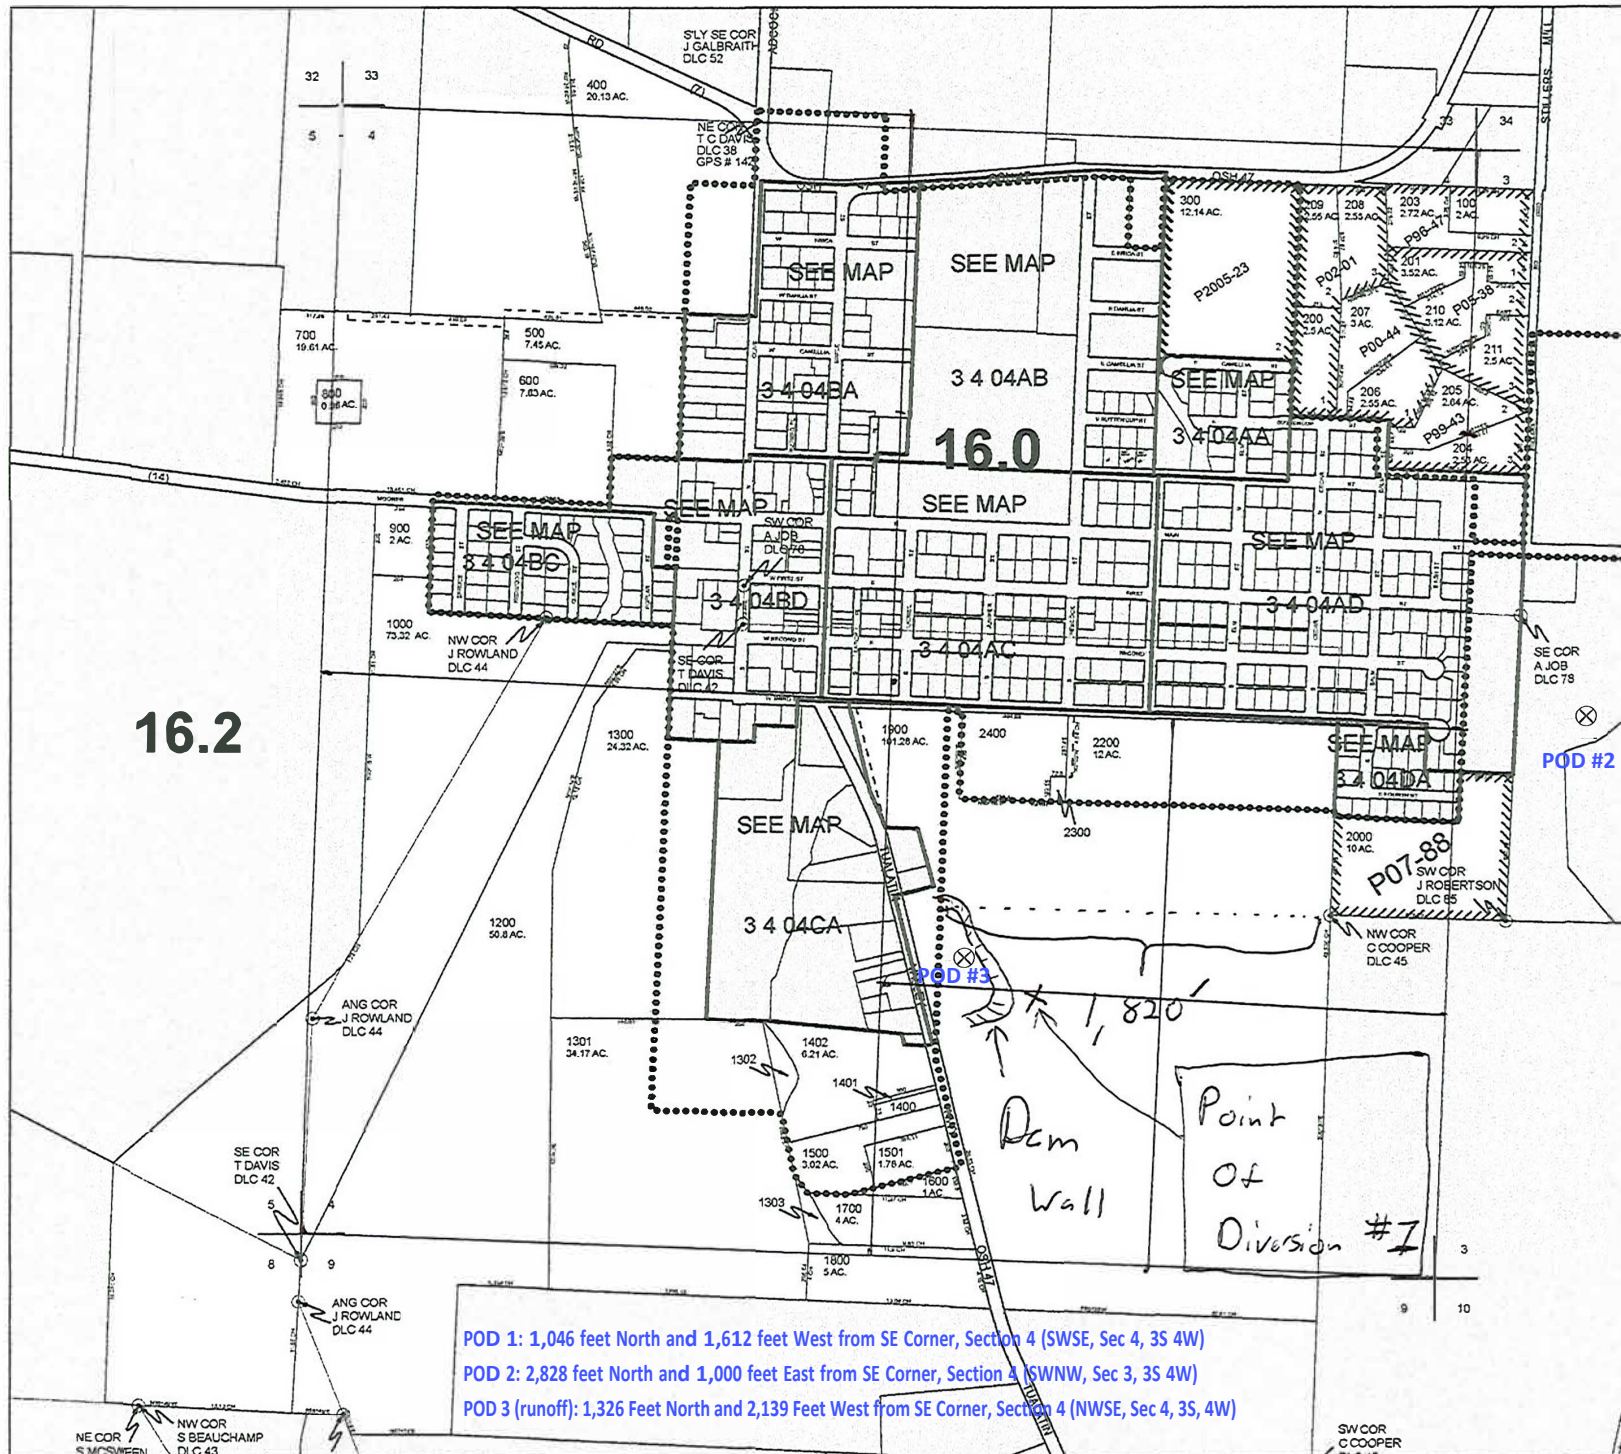

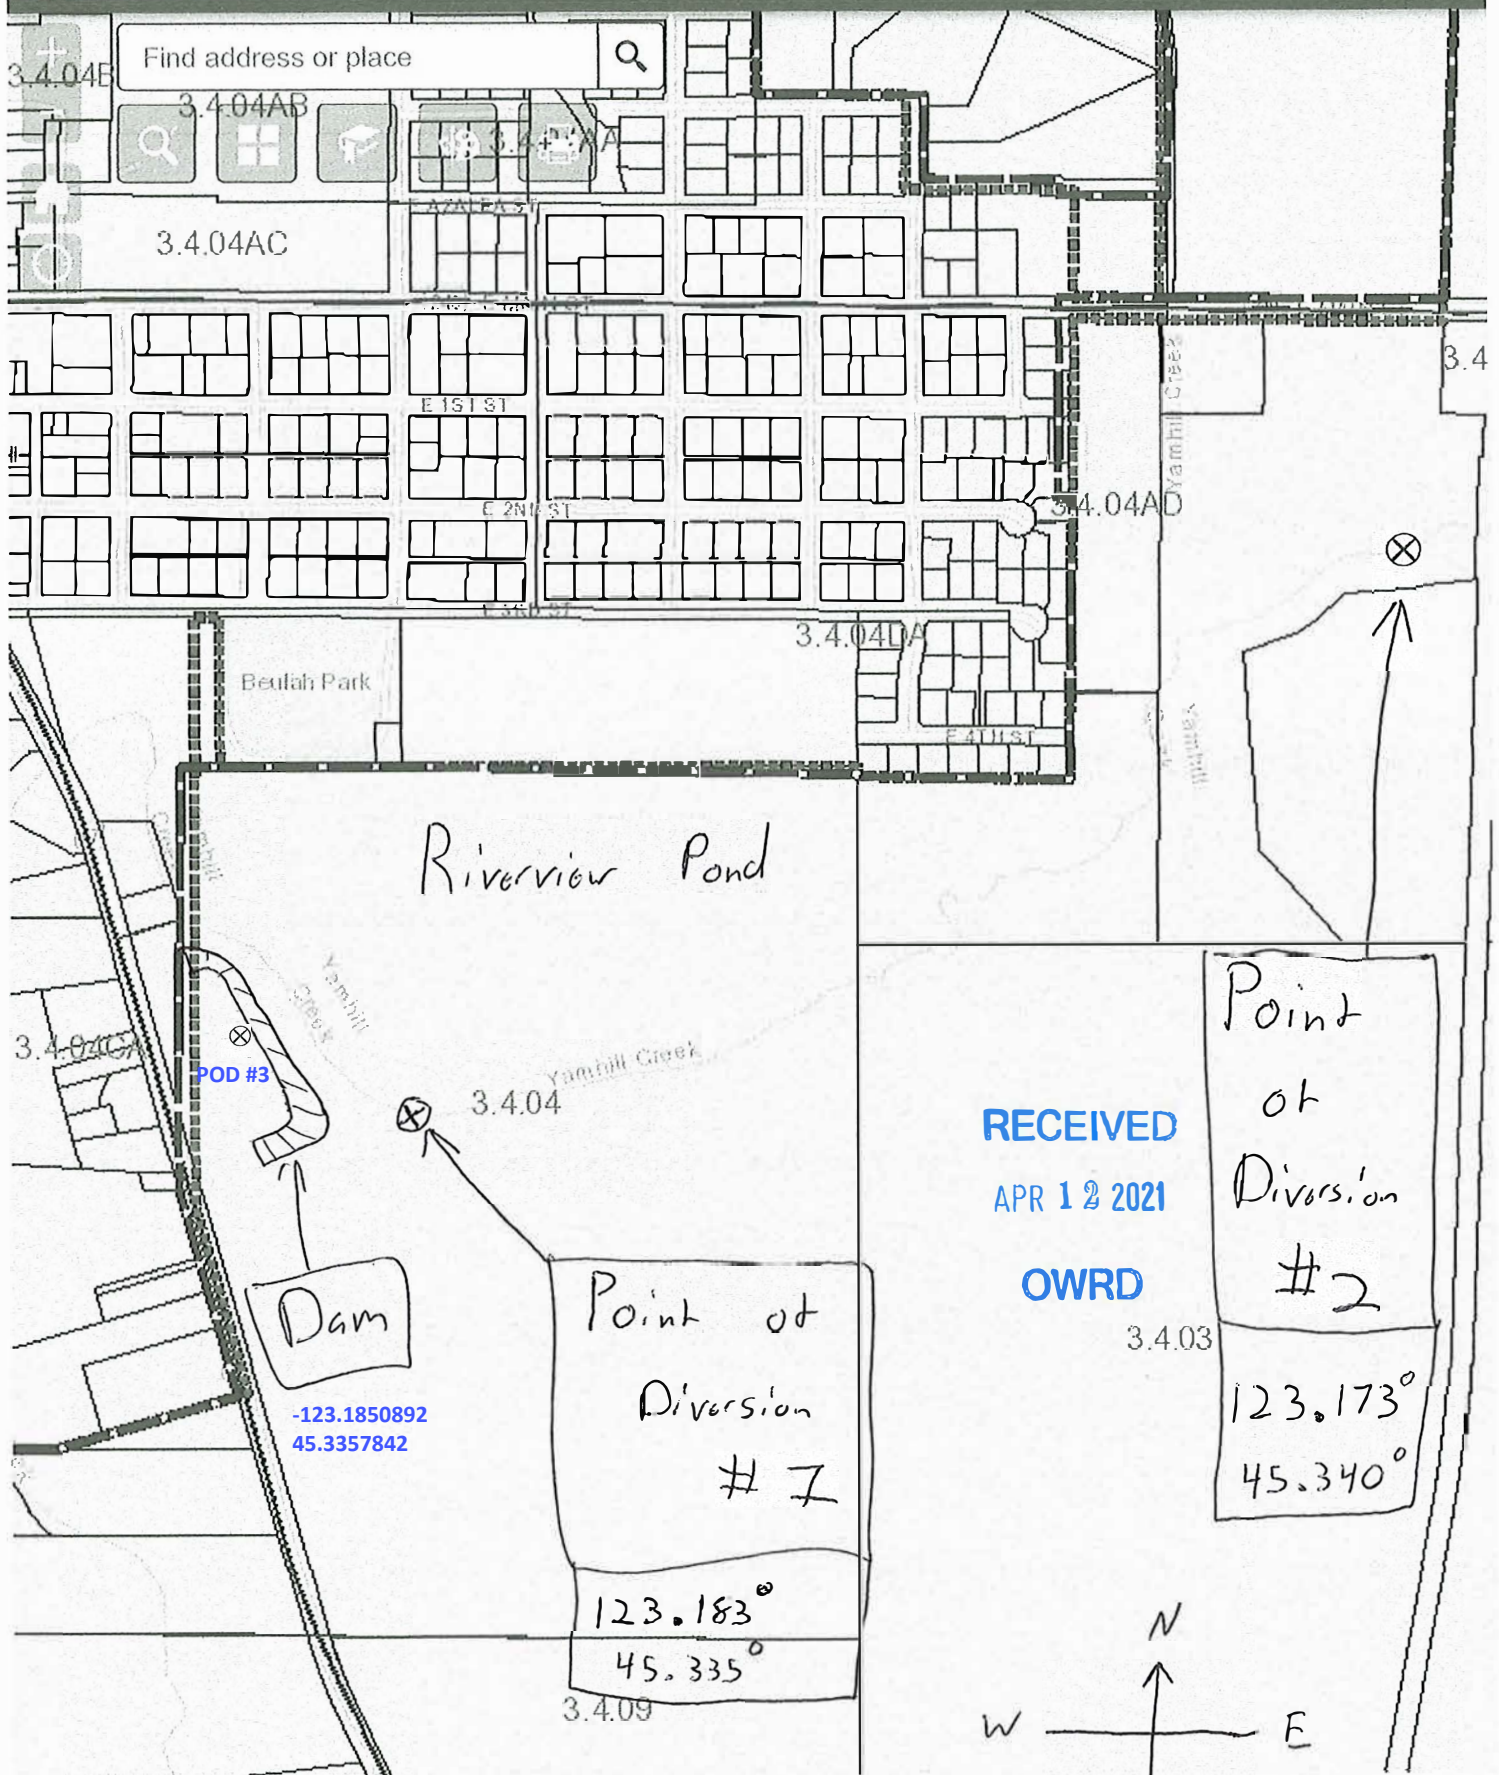

POD 1: 1,046 feet North and 1,612 feet West from SE Corner, Section 4 (SWSE, Sec 4, 3S 4W)

POD 2: 2,828 feet North and 1,000 feet East from SE Corner, Section 4 (SNNW, Sec 3, 3S 4W)

POD 3 (runoff): 1,326 Feet North and 2,139 Feet West from SE Corner, Section 4 (NNSE, Sec 4, 3S, 4W)

Land to Be irrigated



Public GIS 2019

Public ArcGIS Application

Site Instructions



Find address or place




2.4 33



T2R4S33

Lumpkin

T2R4S34

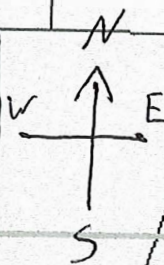

2.4 34

3.4 04BA

3.4 04AB

3.4 04AC




4.31

T2R4S03

RECEIVED

APR 12 2021

OWRD

Beulah Park

3.4 04AD

3.4 04AD

0.2mi


-123.176 45.341 Degrees

3.4 10

T3R4S10

# Yamhill County Map

Riverview Pond

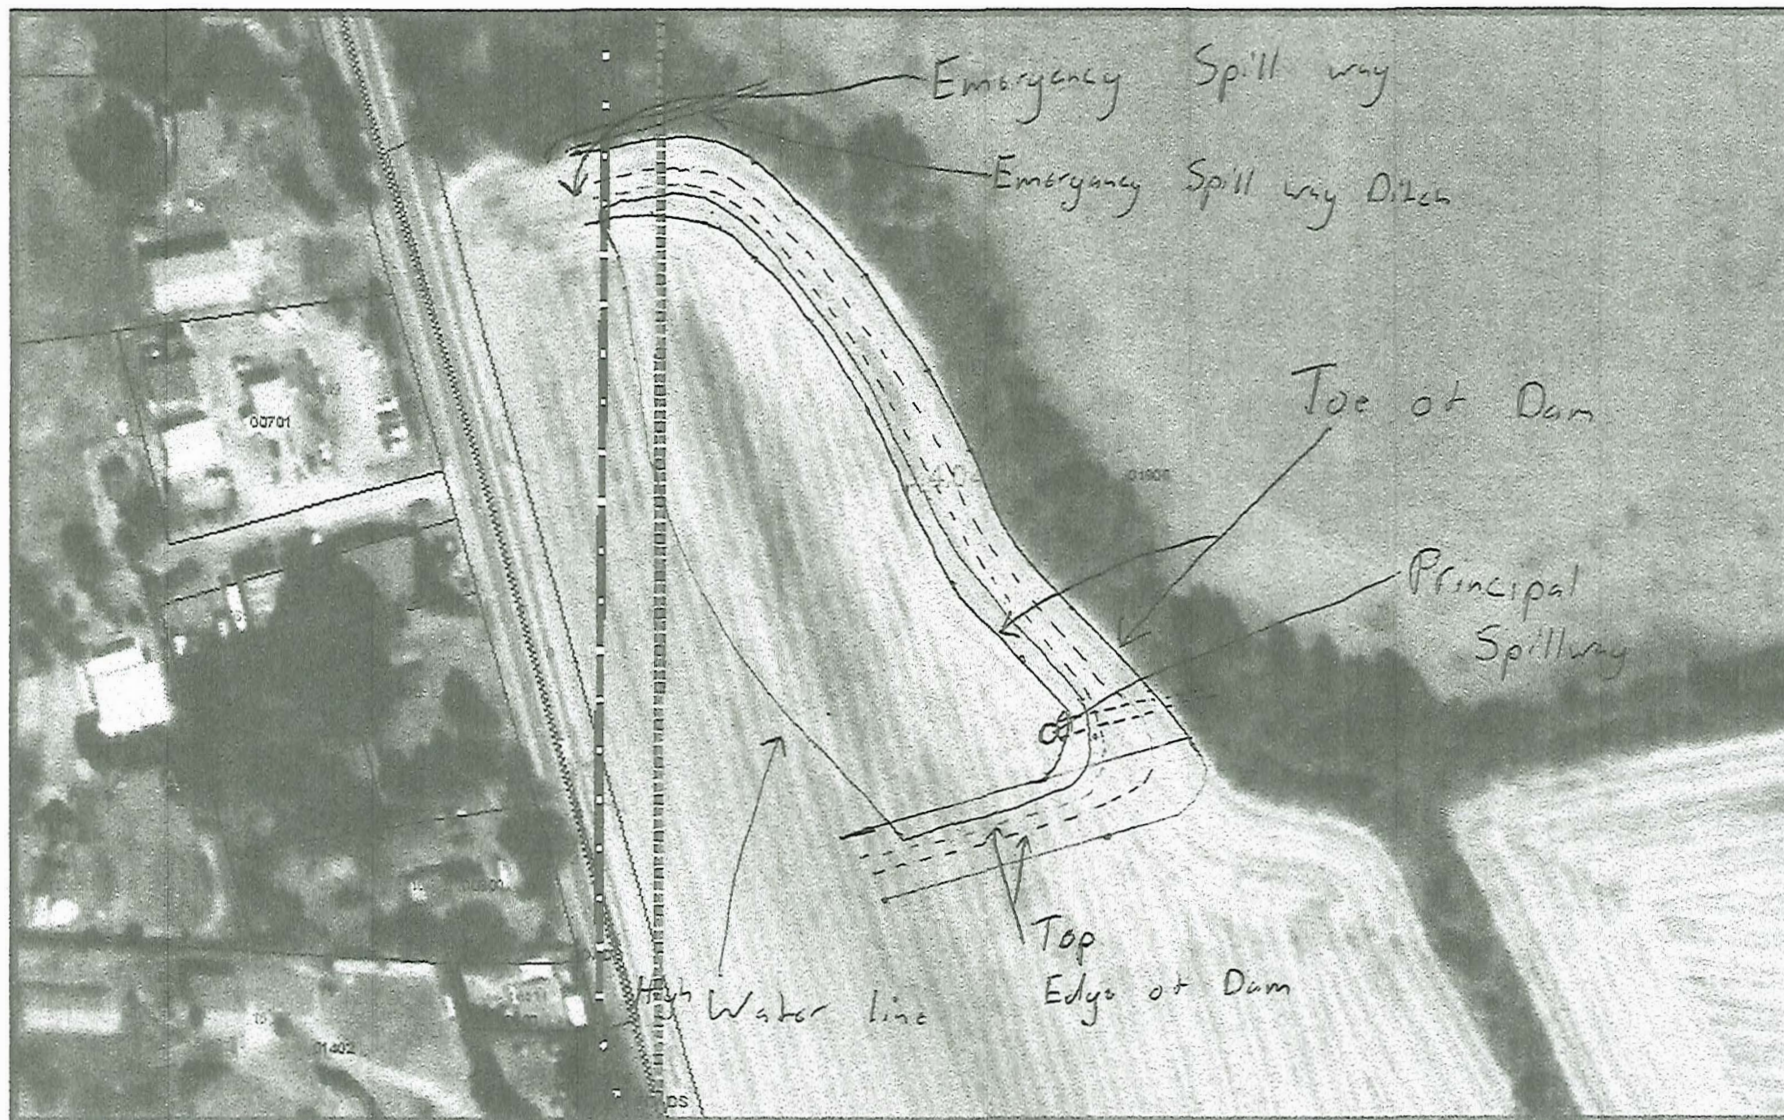

RECEIVED

APR 12 2021

OWRD

November 12, 2019

SL



City Boundary



County Roads



Taxlots



UGB\_YamhillCo




County



Townships

Tax Label

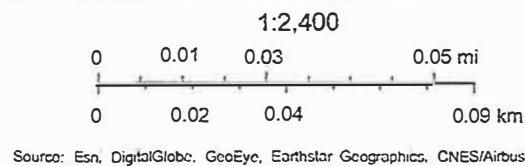

Yamhill County GIS  
Yamhill County 2018

$\frac{1}{2} = 200'$

