






Alternate Reservoir Application - Stellmacher

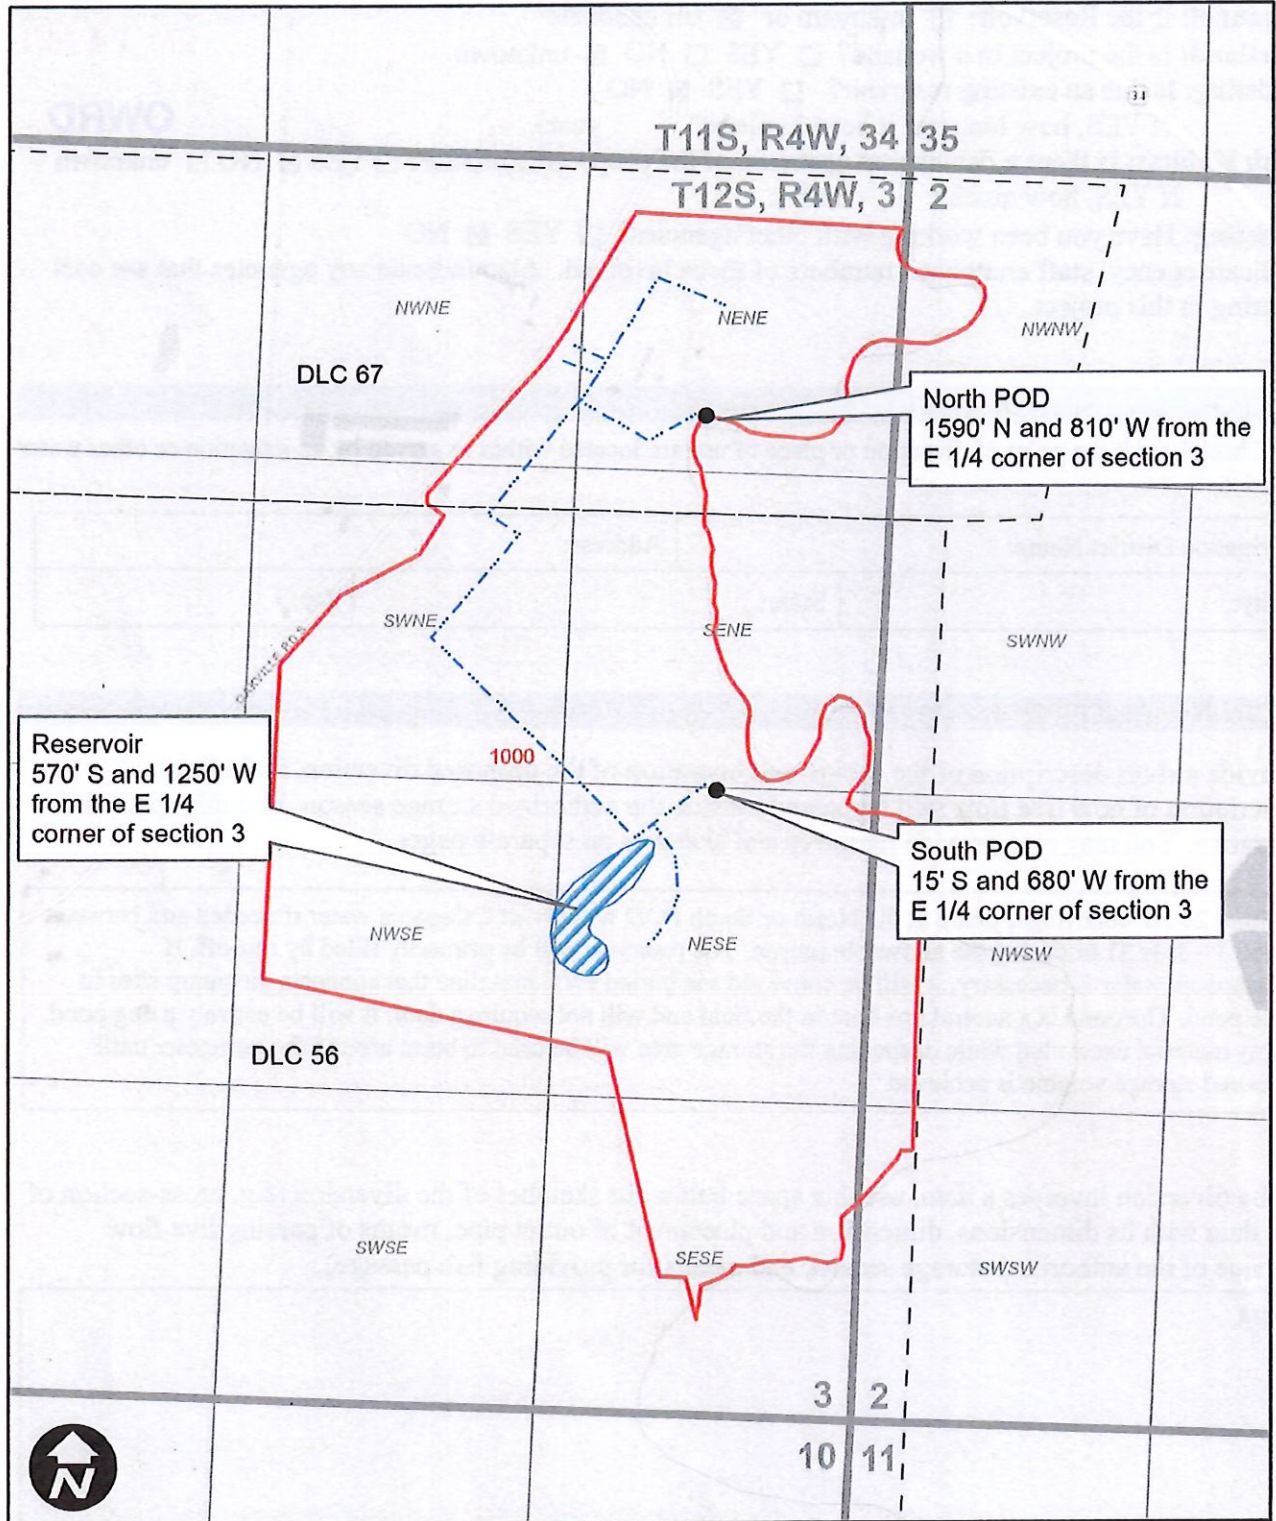

Legend

-  Proposed Reservoir
-  Tax Lot 1000
-  Mainline
-  DLC

0 400 800 1,600 Feet

RECEIVED

MAY 14 2021

OWRD

 WILL MCGILL SURVEYING LLC