

SECTION 30, T.13S., R.11W., W.M.
LINCOLN COUNTY, OREGON

RECEIVED

SEP 04 1998


WATER RESOURCES DEPT
SALEM, OREGON



SCALE: 1" = 400'


MAP BASE:
ASSESSORS MAP
1997 PHOTO

PREPARATION OF THIS MAP IS FOR THE
PURPOSE OF IDENTIFYING THE LOCATION OF
THE WATER RIGHT ONLY. THERE IS NO INTENT
TO PROVIDE DIMENSIONS OR LOCATION OF
PROPERTY OWNERSHIP LINES.

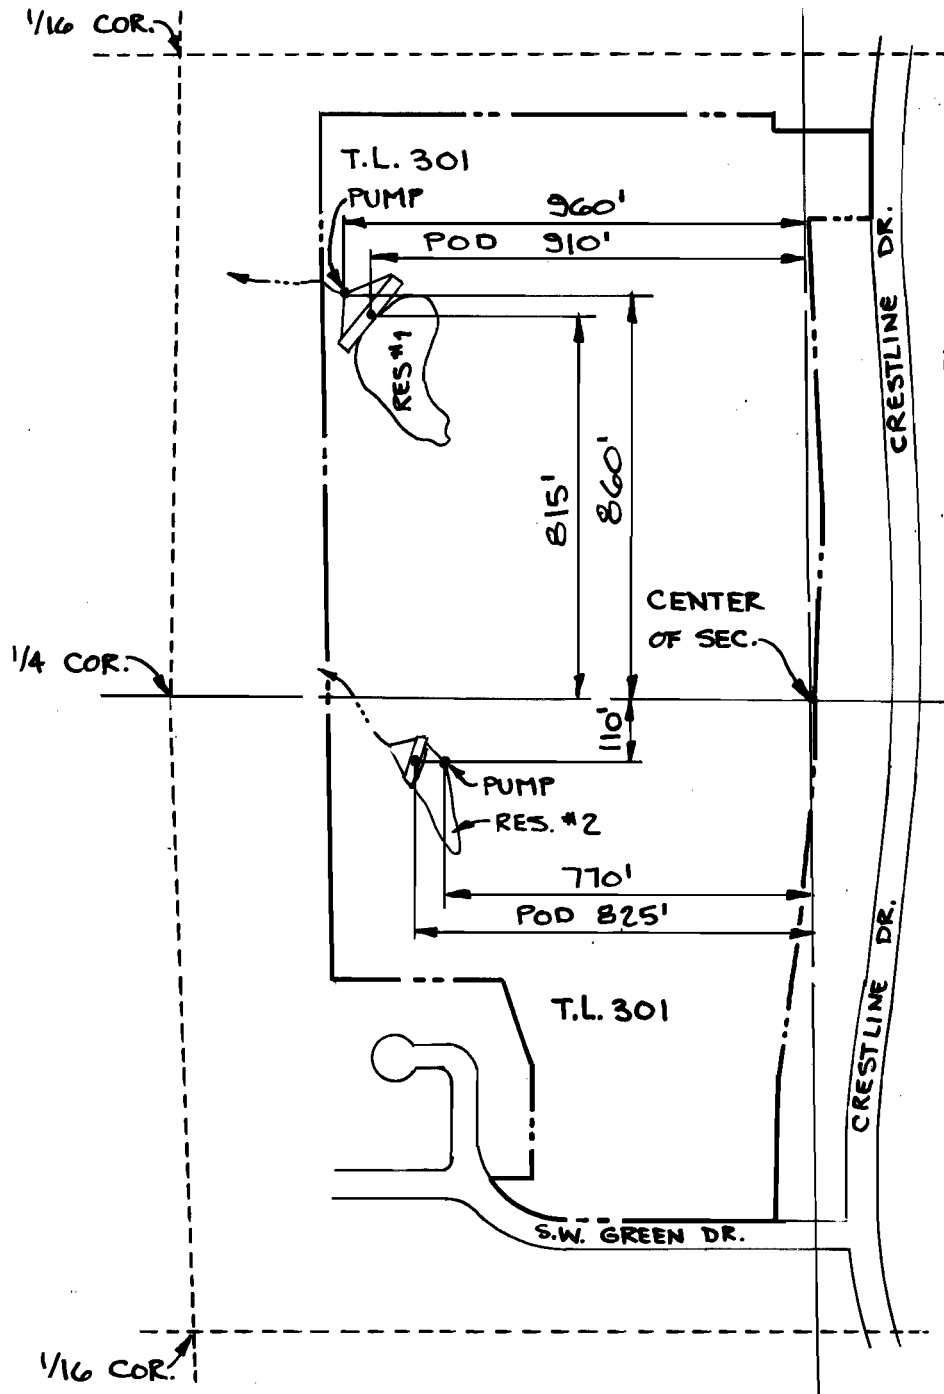

FINAL PROOF SURVEY

SURVEYED AUGUST 7, 1998

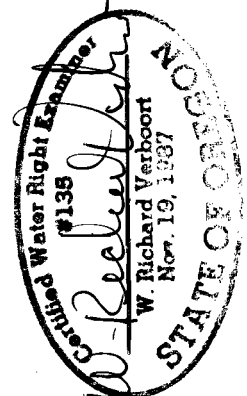

VERBOORT ENGINEERING
AGRICULTURE • CIVIL • WATER RESOURCES
HILLSBORO, OREGON

by date
designed WRV 8-11-98
drawn JER 8-11-98
checked WRV 8-11-98
drawing no. 98-A-08
sheet no. 1/1


MARK & PATRICIA CAMPBELL
1680 S.W. CRESTLINE DR.
WALDPORT, OR 97394

RECEIVED

OCT 13 1993

WATER RESOURCES DEPT.
SALEM, OREGON

T13S R11W WM

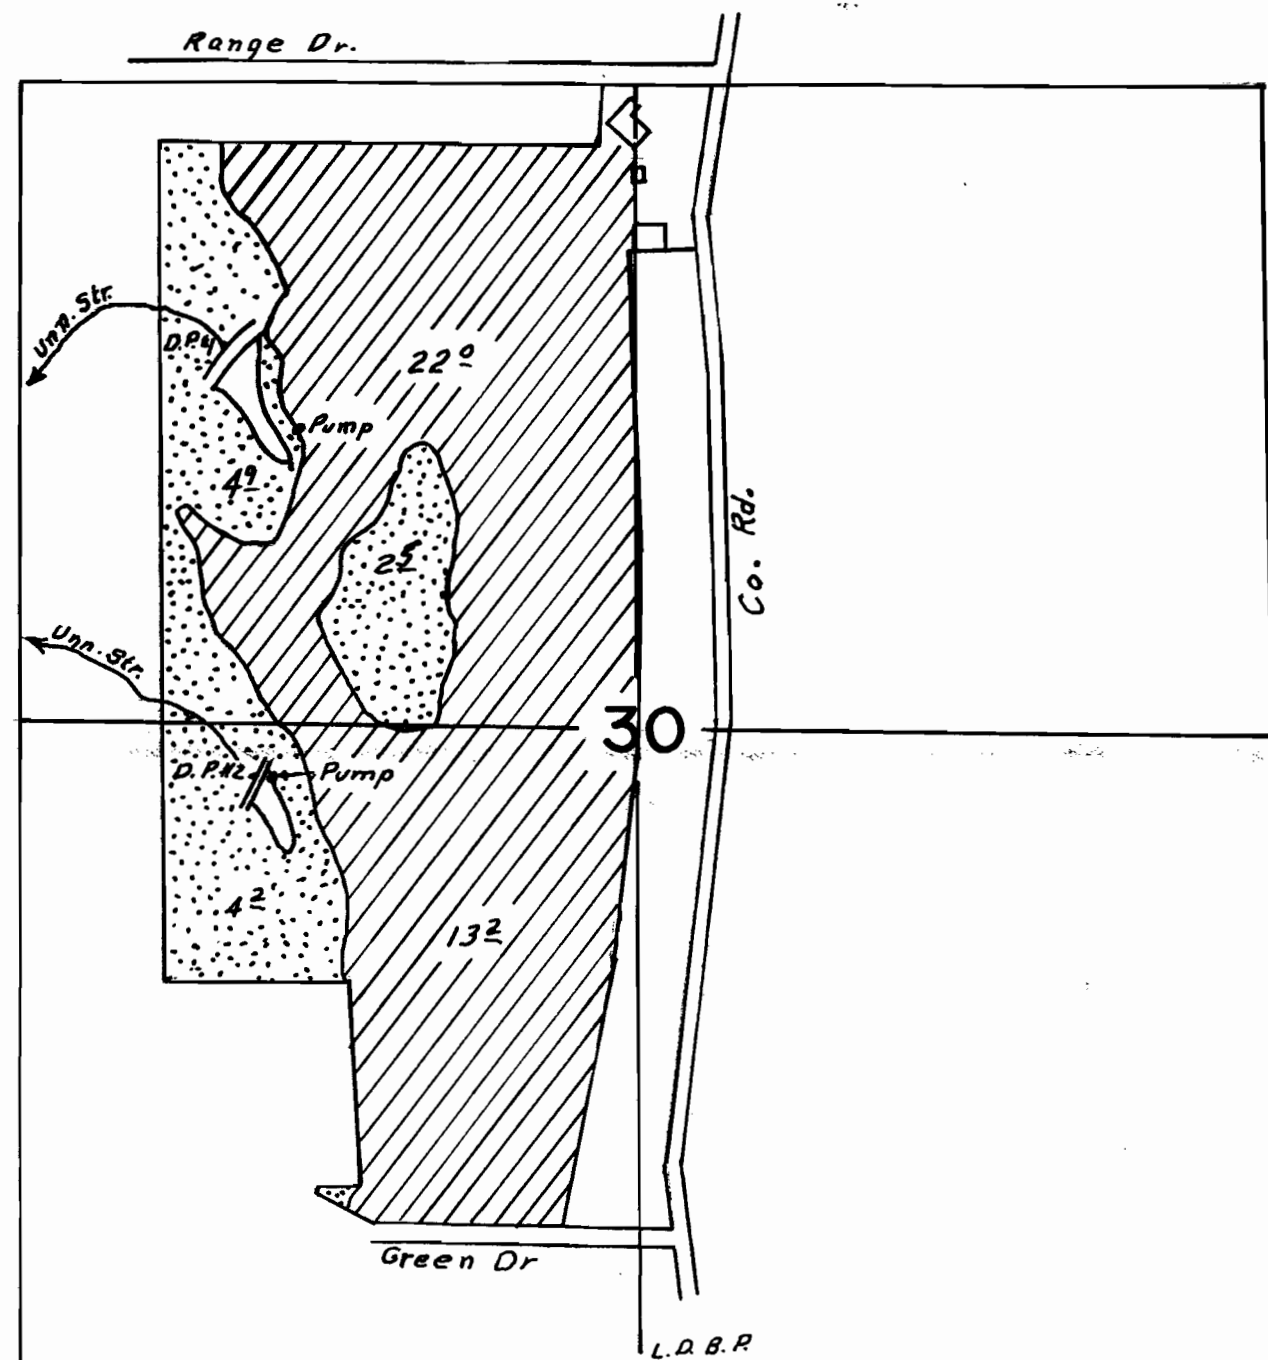

WATER RIGHT

MAP FOR

TIMOTHY & KATHEE

TARPLEY

Scale
1" = 400'

Div. Pts. are located:


No. 1 - 2130' N. & 860' W

No. 2 - 1230' N. & 800' W

from SE cor. NE 1/4 SW 1/4 Sec 30




Irrigated

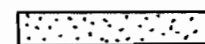

To be irrigated

THIS MAP WAS PREPARED FOR THE
PURPOSE OF IDENTIFYING THE LOCA-
TION OF A WATER RIGHT ONLY AND IS
NOT INTENDED TO PROVIDE LEGAL
DIMENSIONS OR LOCATION OF PROPER-
TY OWNERSHIP LINES.

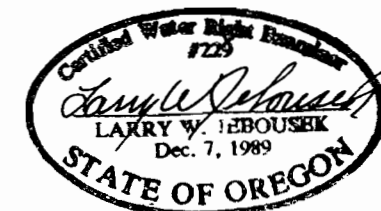

SWR-273