T. 23 S., R. 25 E., W.M.

RECEIVED
AUG 30 1999
WATER RESOURCES DEPT.
SALEM, OREGON

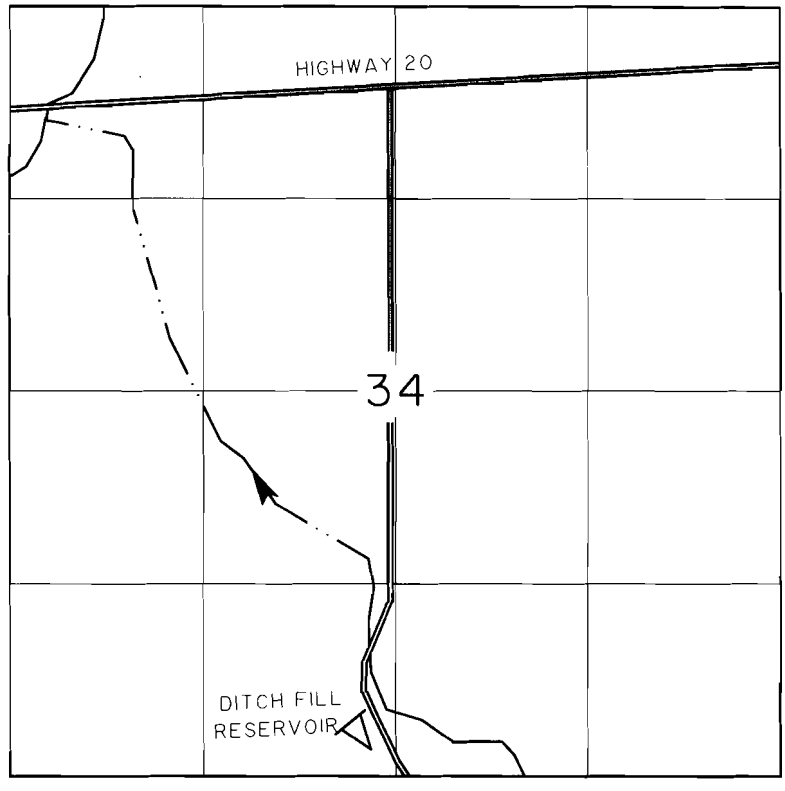

1" = 1320'

DIVERSION IS 450 FEET NORTH AND 2860 FEET WEST OF THE SW CORNER OF SECTION 34.

CLAIM OF BENEFICIAL USE MAP

IN NAME OF

UNITED STATES BUREAU OF LAND MANAGEMENT

APPLICATION NO. R-73147

PERMIT NO. R-11565

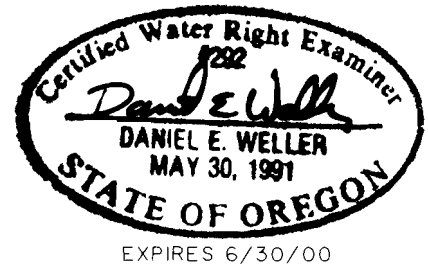

EXPIRES 6/30/00

SURVEYED: JUNE 15, 1999

THE PURPOSE OF THIS MAP IS FOR IDENTIFYING THE LOCATION OF THE WATER RIGHT ONLY AND IS NOT INTENDED TO PROVIDE LEGAL DIMENSIONS OR LOCATION OF PROPERTY OWNERSHIP LINES.

U.S. BUREAU OF LAND MANAGEMENT-OSO
BRANCH OF GEOGRAPHIC SCIENCES

DWG: DITCH

EXECUTED BY:
DANIEL E. WELLER, PLS, CWRE
P.O. BOX 2965
PORTLAND, OREGON 97208