

Form C (690-9-77)

IMPORTANT—This form is a notice to the Water Resources Director that permittee is ready to make **final proof** to the extent to which the water has actually been applied to the intended use under the terms of the permit. Permittee is cautioned that Certificate of Water Right will be issued based on the extent of the quantity and use as determined by the **final proof** inspection and survey which will be made in response to the filing of this Form C.

NOTE: In the case of an irrigation permit, this Form C should not be mailed to the Water Resources Department until all of the land described in the permit, which it is intended to irrigate under this permit at any time, has actually been irrigated.

Fill out, detach and mail to the Water Resources Department, Salem, OR 97310, when all of the water has been applied.

Application No. G-8272

NOTICE OF COMPLETE APPLICATION OF WATER TO A BENEFICIAL USE

I, Jack A. Smith, the holder of Permit No. G-7693

to appropriate the public waters of the state of Oregon, completely applied the waters to a beneficial use in accordance with the terms of said permit, on the 15 day of Aug, 1977

Remarks: _____

IN WITNESS WHEREOF, I have hereunto set my hand this 3 day of Feb, 1978.

Jack A. Smith St Rt 2 181 Low Creek Rd Burns Ore 97720
(Signature of Applicant) (Address)

Form B (690-9-77)

Application No. G-8272

NOTICE OF COMPLETION OF CONSTRUCTION

I, Jack A. Smith, the holder of Permit No. G-7693

to appropriate the public waters of the state of Oregon, completed the construction of the works described therein on the 23 day of July, 1977.

Remarks: _____
If the works have less capacity than described in the permit, or you have definitely abandoned part of the proposed development, you should so state in order that our records may not be unnecessarily encumbered.

IN WITNESS WHEREOF, I have hereunto set my hand this 3 day of Feb, 1978.

Jack A. Smith St Rt 2 181 Low Creek Rd Burns, Ore 97720
(Signature of Applicant) (Address)

Fill out, detach and mail to the Water Resources Department, Salem, OR 97310, when construction work is completed.

Form A (690-9-77)

Application No. G-8272

NOTICE OF BEGINNING OF CONSTRUCTION

I, Jack A. Smith, the holder of Permit No. G-7693

to appropriate the public waters of the state of Oregon, began the actual construction of the works described therein on the 14 day of April, 1977.

Remarks: _____
The appropriator must state the manner of beginning of construction, the amount of work completed and the type of equipment acquired for the water system up to the date of this statement, and any additional information which shows a substantial beginning of construction as authorized by your permit.


IN WITNESS WHEREOF, I have hereunto set my hand this 3 day of Feb, 1978.

Jack A. Smith St Rt 2 181 Low Creek Rd Burns Ore 97720
(Signature of Applicant) (Address)

Fill out, detach and mail to the Water Resources Department, Salem, OR 97310, when construction work is begun.

T22S. R32½E. WM.

COPY

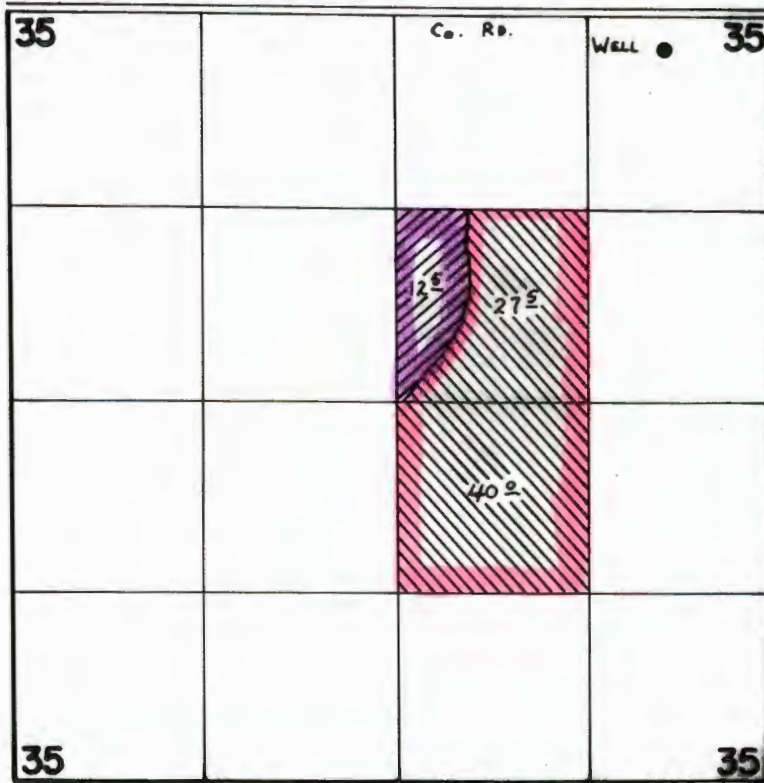

WELL Loc: 225' S. & 730' W. fr. NE. COR. SEC. 35.

▨ - SUPPLEMENTAL IRRIGATION

▨ - PRIMARY IRRIGATION


FINAL PROOF SURVEY
UNDER

Application No. G-8272 Permit No. G-7693
IN NAME OF

JACK G. & BONNIE J. SMITH

Surveyed AUG. 26 1978, by C. L. HUGHES

T22S. R32½E. WM.

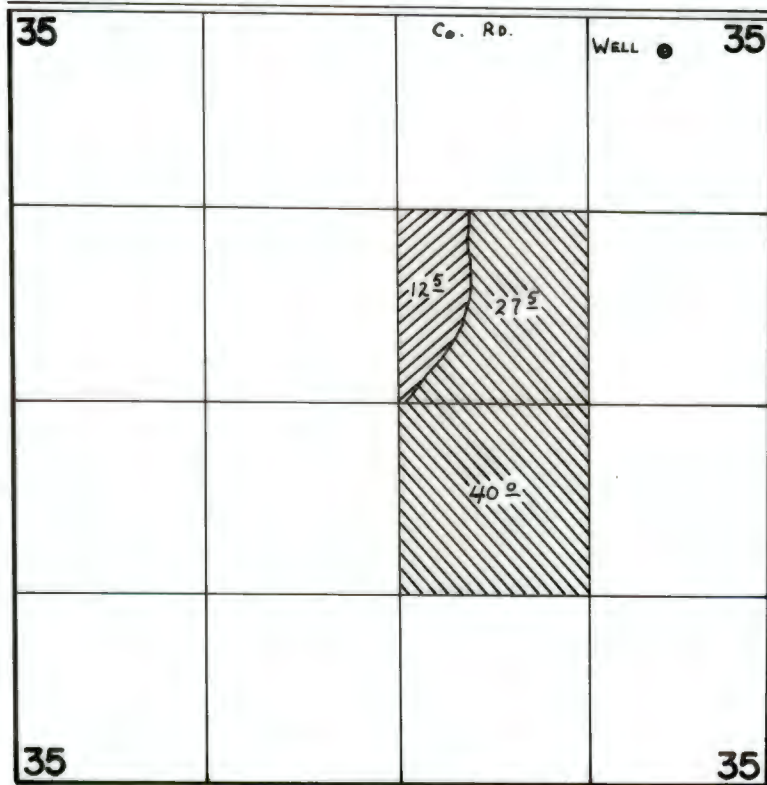

WELL Loc: 225' S. & 790' W. fr. N.E. COR. SEC. 35.

- ▨ - SUPPLEMENTAL IRRIGATION
- ▨ - PRIMARY IRRIGATION

FINAL PROOF SURVEY UNDER

Application No. G-8272 Permit No. G-7693
IN NAME OF

JACK G. & BONNIE J. SMITH

Surveyed AUG. 26 1978, by C. L. HUGHES

STATE OF OREGON
COUNTY OF HARNEY

RECEIVED
JAN 11 1982
WATER RESOURCES DEPT.
SALEM, OREGON

Proof of Appropriation of Water

JACK G. and BONNIE J. SMITH

of Star Route 2, 181 Cow Creek Road, Burns, State of Oregon 97720, has applied beneficially the waters of a well

a tributary of Cow Creek for the purpose of irrigation of 12.5 acres and supplemental irrigation of 67.5 acres

under Permit No. G-7693 and that the use of said waters has been completed under the terms of said permit; that the priority of the right dates from

July 14, 1977

that the amount of water for the purposes aforesaid, has been actually beneficially used in the amount of

1.0 cubic foot per second

or its equivalent in case of rotation, measured at the point of diversion from the well. The well is located in the NE 1/4 NE 1/4, Section 35, T22S, R32 1/2E, WM; 225 feet South and 730 feet West from the NE Corner of Section 35

The amount of water used for irrigation, together with the amount secured under any other right existing for the same lands, shall be limited to one-eightieth of one cubic foot per second per acre, or its equivalent for each acre irrigated and shall be further limited to a diversion of not to exceed 3 acre-feet per acre for each acre irrigated during the irrigation season of each year

and shall conform to such reasonable rotation system as may be ordered by the proper state officer.

A description of the place of use under the right, and to which such right is appurtenant, is as follows:

PRIMARY IRRIGATION

12.5 acres SW 1/4 NE 1/4
Section 35

SUPPLEMENTAL IRRIGATION

27.5 acres SW 1/4 NE 1/4
40.0 acres NW 1/4 SE 1/4
Section 35

Township 22 South, Range 32 1/2 East, WM

I have read the above and foregoing proof of appropriation of water; I know the contents thereof, and that the facts therein stated are true.

IN WITNESS WHEREOF, I have hereunto set my hand this 7th day of January 19...82

Jack G. Smith
Bonnie J. Smith

HARNEY / ON

NOV 14 1985

NOTICE OF INTEREST IN WATER RIGHT

RECEIVED

NOV 14 1985

WATER RESOURCES DEPT
SALEM, OREGON

To: Director of Water Resources
555 13th Street, N.E.
Salem, Oregon 97310

This is to notify you of an interest in the following described water right:

Loan Number M-78248
Borrower's Name Smith, Jack G.
Mailing Address _____

Property being served by the water:

Township 22S Township _____ Township _____
Range 32 1/2 E Range _____ Range _____
Section 2, 22, 27, 28, 29, 35 Section _____ Section _____
Tract _____ Tract _____ Tract _____

Water Right Numbers:

22913

Cow Creek Dec
Vol 12
P 509

B 8272

B 8273

Permit Number(s)

18065

B 7693

B 7694

Certificate Number(s)

21134, 15529

50685

50686

Irrigation District

210.4Ac

327Ac

12.5 Prim
67.5 Supp

187Ac
Prim

The State of Oregon, by and through the Director of Veterans' Affairs, has a security interest in the above described property and hereby requests that no action be taken to diminish the water right without notifying the Department of Veterans' Affairs, 700 Summer Street, N.E., Salem, Oregon, 97310.

28953 28954 28955

Attention: Butch Gehley, Appraisal Coordinator

22772 22773 22774


21508 26321 26322

17.6Ac Prim 22.4Ac Prim 53.8Ac Prim


Attachments:

- Legal Descriptions
- Tax Lot Maps
- Please return copy to ODVA

11-18-85
DM

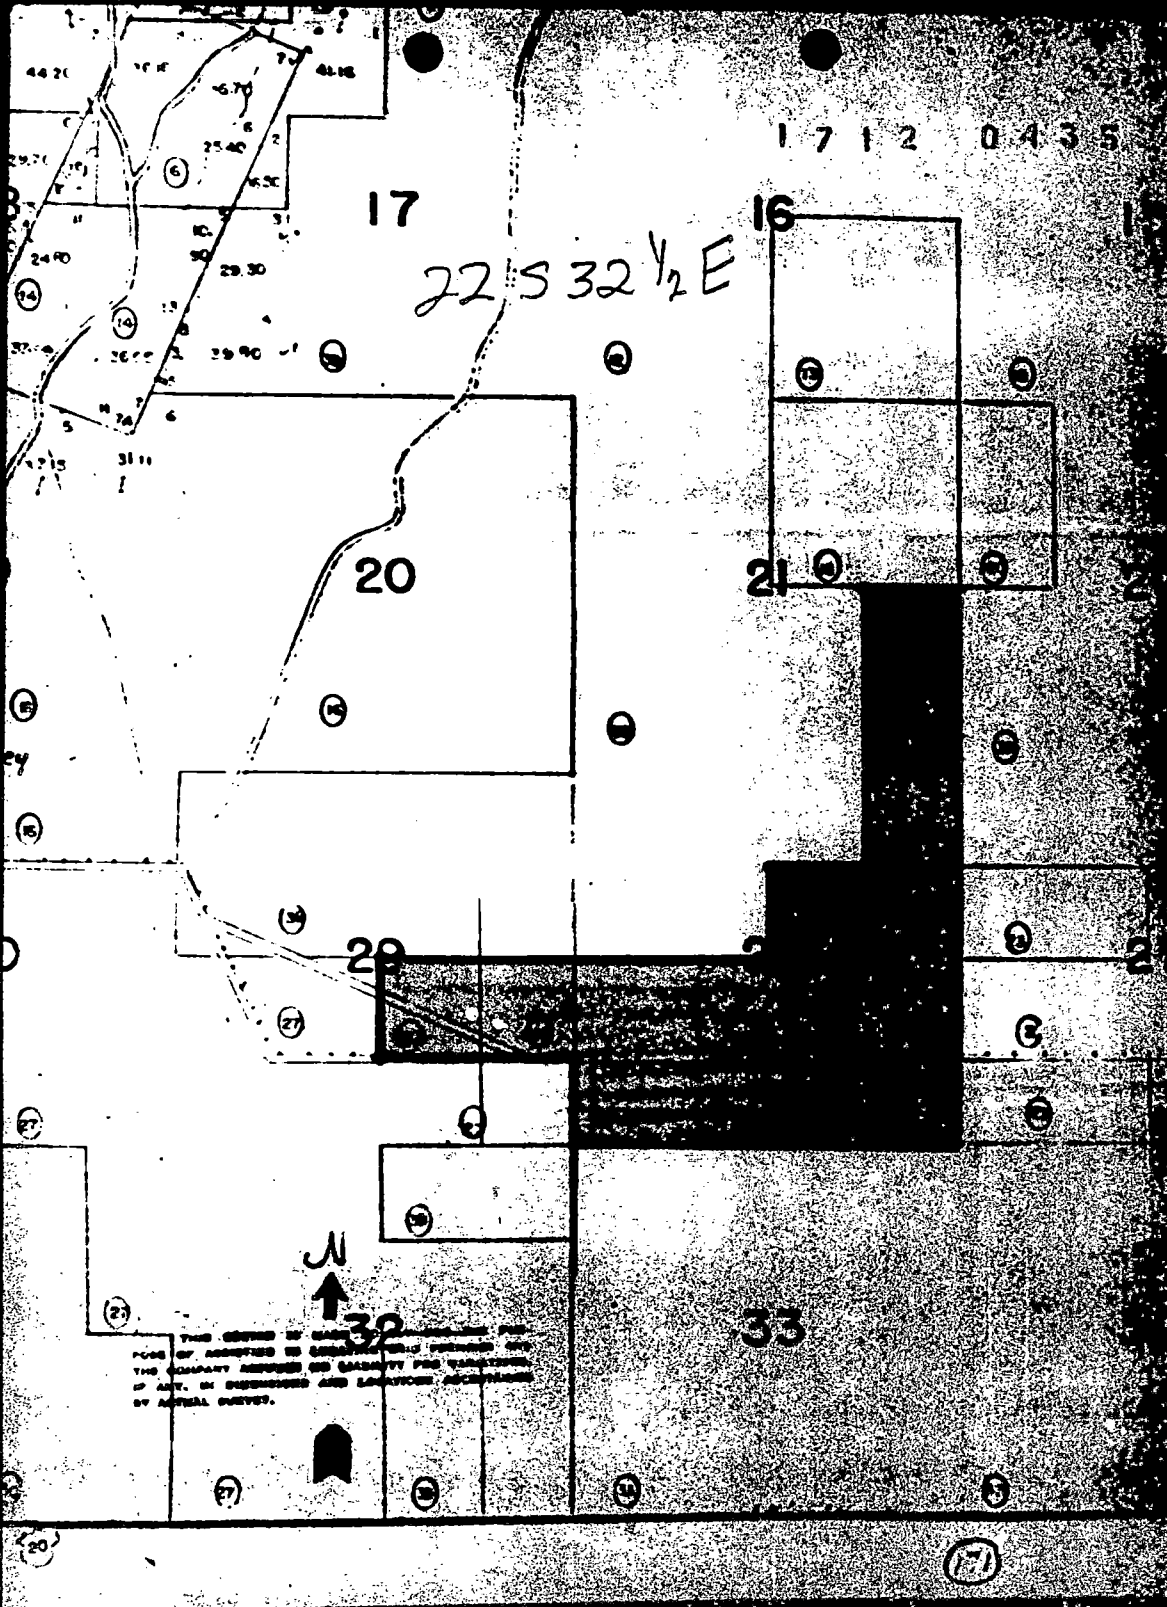

22S 32 1/2 E

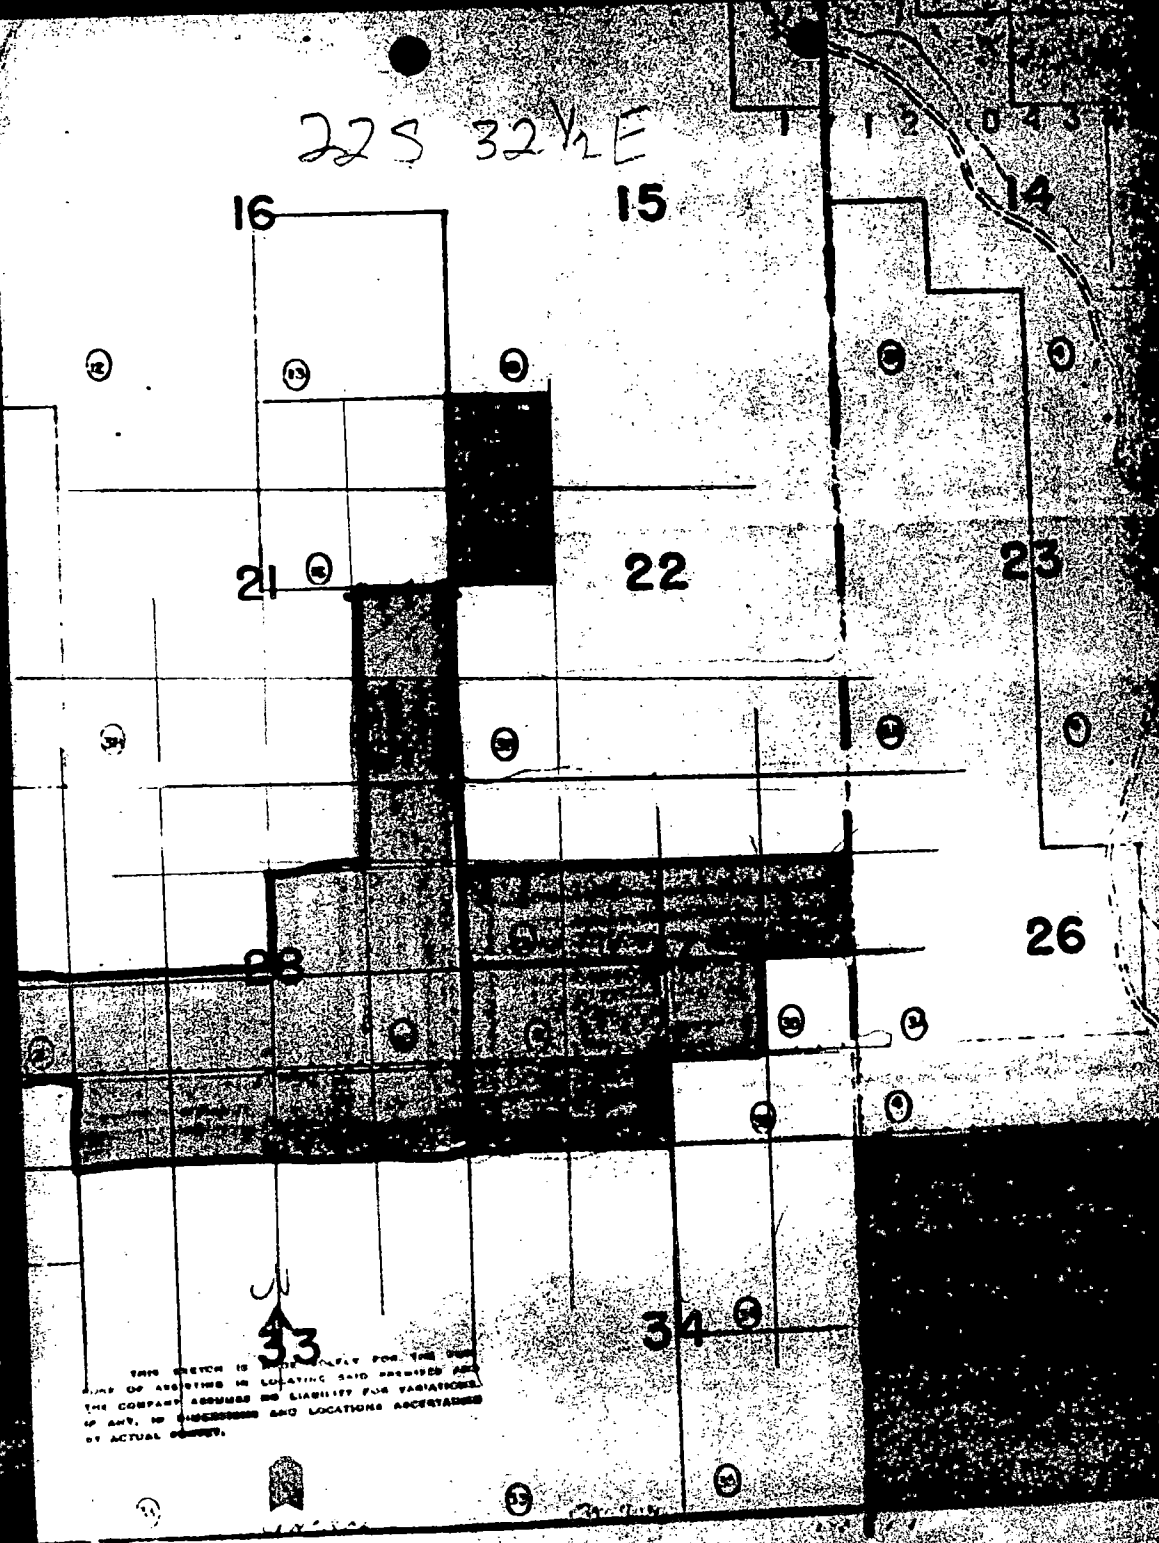

THIS SKETCH IS MADE ONLY FOR THE PURPOSE OF ASSISTING IN LOCATING SAID PREMISES AND THE COMPANY ASSUMES NO LIABILITY FOR VARIATIONS OF ANY KIND BETWEEN THE LOCATIONS ASCERTAINED BY ACTUAL SURVEY.


(17)

December 28, 1977

Jack G. and Bonnie J. Smith
Star Route, 181 Cow Creek Rd.
Burns, OR 97720

G 8271
G 8272

G 7692 and G 7693

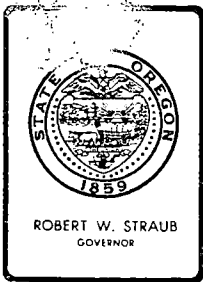

Water Resources Department

MILL CREEK OFFICE PARK

555 13th STREET N.E., SALEM, OREGON 97310

PHONE 378-3066

G 8271, G 8272, G 8273

December 8, 1977

Jack G. & Bonnie J. Smith
Star Route 2, 181 Cow Creek Road
Burns, Oregon 97720

Dear Mr. & Mrs. Smith:

Thank you for returning your maps and application numbered G 8272 that is now for a permit to use 900.0 gallons per minute from a well for primary irrigation of 12.5 acres, and supplemental irrigation of 67.5 acres; and for application numbered G 8273 that is now for a permit to use 1600.0 gallons per minute from a well for the irrigation of 187.0 acres.

All three of the applications, including G 8271, are satisfactory and permits will be issued.

Sincerely,

Vestal R. Garner
Water Rights Engineer

VRG:slk

COPY

G-8271

G-8272

G-8273

15 November 1977

Jack G. and Bonnie J. Smith
Star Route 2, 181 Cow Creek Road
Burns, Oregon 97720

Dear Mr. and Mrs. Smith:

We have received your maps, fees of \$138.10 and three applications for permits to use ground water.

The first application is for a permit to use 300 gallons of water per minute from a well for supplemental irrigation of 50.0 acres. For reference, this application is numbered G-8271. This application is satisfactory and a permit can be issued.

The second application is for a permit to use 900 gallons of water per minute from a well for supplemental irrigation of 30.0 acres. For reference, this application is numbered G-8272.

According to our records, there is an existing right for irrigation of 27.5 acres within the SW $\frac{1}{4}$ NE $\frac{1}{4}$ from Cow Creek as evidenced by certificate numbered 15529. Since your application is requesting supplemental irrigation of 40.0 acres within the SW $\frac{1}{4}$ NE $\frac{1}{4}$, it will be necessary to amend the application to list 27.5 acres supplemental and 12.5 acres primary. Your map will also require amendment to show the location of the primary and supplemental acreage.

The third application is for a permit to use 1600 gallons of water per minute from a well for primary irrigation of 193.3 acres. For reference, this application is numbered G-8273.

According to our records, there is a 14.0 acre water right within the NW $\frac{1}{4}$ NE $\frac{1}{4}$ of Section 35 for use of water from Cow Creek as evidenced by Certificate numbered 15529. Since your application is proposing to irrigate 33.3 acres, a portion of this probably included under the right from Cow Creek. Your application should be requesting primary irrigation of only the new land and supplemental irrigation of land having a Cow Creek right, if this is your desire. The map should also be amended to reflect the project you intend to carry out. At the present time, the area illustrated as being 33.3 acres within the NW $\frac{1}{4}$ NE $\frac{1}{4}$ of the section contains 25.0 acres. If 25.0 acres is the actual figure to be irrigated, the map and application should be amended accordingly.

Jack G. and Bonnie J. SMith
Page Two
G-8271
G-8272
G-8273

I am returning your maps and application numbered G-8272 and G-8273 for correction and completion. These applications are endorsed so that in order to retain their priority date they must be received on or before January 16, 1978.

Sincerely,

Vestal R. Garner
Water Rights Engineer

VRG:clh

378-3066

September 12, 1977

Jack G. and Bonnie J. Smith
Star Route 2, 181 Cow Creek Rd.
Burns, Oregon 97720

Dear Mr. and Mrs. Smith:

We have received your application for sprinkle irrigation and supplemental irrigation along with the supporting data and fees. Our receipt number's 62502, 62503 and 62504 are enclosed. Your applications have been filed and assigned numbers G-8271, G-8272 and G-8273.

Because of the many applications which have been filed in recent months, we are temporarily behind in our processing. Your applications will be examined in detail as soon as possible. We will contact you if we need any additional information.

The permits approving your applications will be issued without further correspondence if no additional information is required. Thank you for your patience.

Sincerely,

Larry W. Jebousek
Administrator
Water Rights Division

LWJ: td
ENCL: Receipt's No. 62502, 62503 and 62504

Application No. G-8272

Permit No. G 7693

[Handwritten initials]

STATE OF OREGON WATER RESOURCES DEPARTMENT

Application for a Permit to Appropriate Ground Water

RECEIVED

JUL 14 1977

I, Jack G. Smith and Bonnie J. Smith
(Name of Applicant)

WATER RESOURCES DEPT.
SALEM, OREGON

of Star Rt 2 181 Cow Creek Rd.
(Mailing Address)

Burns
(City)

State of Oregon, 977 20 Phone No. 493-2383 do hereby

make application for a permit to appropriate the following described ground waters of the State of Oregon:

1. The development will consist of one well TRIB Cow CR.
(Give number of wells, tile lines, infiltration galleries, etc.)

having a diameter of 12" and an estimated depth of 250 feet.

2. The well or other source is to be located 745 ft S and 30 ft W
(N. or S.) (E. or W.)

from the NE corner of Section 35, Tp 22, R 32 E
(Public Land Survey Corner)

(If there is more than one well, each must be described)

being within the NE $\frac{1}{4}$ of the NE $\frac{1}{4}$ of

Sec. 35 Tp. 22 S R. 32 E, W. M., in the county of Harney

3. Location of area to be irrigated, or place of use if use other than irrigation.

Township	Range	Section	List $\frac{1}{4}$ $\frac{1}{4}$ of Section	List use and/or number of acres to be irrigated
<u>22 S</u>	<u>32 E</u>	<u>35</u>	<u>SW $\frac{1}{4}$ of the NE $\frac{1}{4}$</u>	<u>27.5 Supp. To Cow Cr</u>
<u>22 S</u>	<u>32 E</u>	<u>35</u>	<u>NW $\frac{1}{4}$ of the SE $\frac{1}{4}$</u>	<u>40 acres supp</u>
		<u>35</u>	<u>SW NE</u>	<u>(C#15529)</u> <u>Supplanted</u> <u>PRIMARY</u>
			<u>SW SW</u>	<u>27.5</u> <u>12.5</u>
				<u>40</u>
				<u>67.5</u> <u>12.5</u>

4. It is estimated that 60 feet of the well will require $\frac{1}{2}$ " well 12" casing.
(Kind)

5. Depth to water table is estimated 17 feet. Well drilled by Skinner & Son

Chain Survey
8/26/78 CLH

[Handwritten notes]
id 12-509
604 PLU

7889A

Application No. G-8272

Permit No. G 7693

Permit to Appropriate the Public Waters of the State of Oregon

This is to certify that I have examined the foregoing application and do hereby grant the same, SUBJECT TO EXISTING RIGHTS INCLUDING THE EXISTING MINIMUM FLOW POLICIES ESTABLISHED BY THE WATER POLICY REVIEW BOARD and the following limitations and conditions:

The right herein granted is limited to the amount of water which can be applied to beneficial use and shall not exceed 1.0 cubic feet per second measured at the point of diversion from the well or source of appropriation, or its equivalent in case of rotation with other water users, from a well

TRIB. COW CREEK

The use to which this water is to be applied is irrigation of 2.5 acres and supplemental irrigation

of 67.5 Acres

If for irrigation, this appropriation shall be limited to 1/80th of one cubic foot per second or its equivalent for each acre irrigated and shall be further limited to a diversion of not to exceed 3.0 acre-feet per acre for each acre irrigated during the irrigation season of each year;

provided further that the right allowed herein shall be limited to any deficiency in the available supply of any prior right existing for the same land and shall not exceed the limitation allowed herein,

and shall be subject to such reasonable rotation system as may be ordered by the proper state officer.

The well shall be constructed in accordance with the General Standards for the Construction and Maintenance of Water Wells in Oregon.

The works constructed shall include an air line and pressure gauge or an access port for measuring line, adequate to determine water level elevation in the well at all times.

The permittee shall install and maintain a weir, meter, or other suitable measuring device, and shall keep a complete record of the amount of ground water withdrawn.

The priority date of this permit is July 14, 1977

Actual construction work shall begin on or before December 28, 1978 and shall thereafter be prosecuted with reasonable diligence and be completed on or before October 1, 1979

Complete application of the water to the proposed use shall be made on or before October 1, 1980

WITNESS my hand this 28th day of December, 1977

James E. Peterson
Water Resources Director

Info: Mr. Smith. Area is irrigated as applied.

Source: A well. Depth - 250' W.L. - 17' Drawdown - 6.8'

pump - GE 30 HP @ 1750 RPM turbine.

Johnston 8" disch. (open discharge)

Use: Irrigation of hay crop.

Equip: He runs pump open discharge into ditch.

Land is flood irrigated by a series of ditches.

The main ditches are 5' x 4' x 2½' - 3' deep all along outside edges of property. Smaller ditches come off the main ditches and run into center of property.

Smaller ditches are 2' x 1½' x 1' deep.

Measurements on discharge 8" pipe ~~XXXXXXXXXX~~

5" x-c area water 15" hor. flow with 12" drop.

Tie: Chain Survey. See App. map (map is accurate)

$$\text{Freeboard} = 3" \quad D = 8"$$

$$X = 15" \quad Y = 12"$$

$$\frac{F}{D} = \frac{3}{8} = .375 \quad \text{Eff. Area} = .658$$

$$Q = \frac{(3.61)(50.27)(.658)(15)}{\sqrt{12}} = 517.7 \text{ GPM}$$

$$\frac{517.7}{450} = 1.15 \text{ cfs}$$

Chris Hughes

FE

8/26/78


SECTION PLAT

SEC 35 TWP 22S R 32 1/2 E.

County of HARNEY State of OREGON

8" = 1 MC.

N

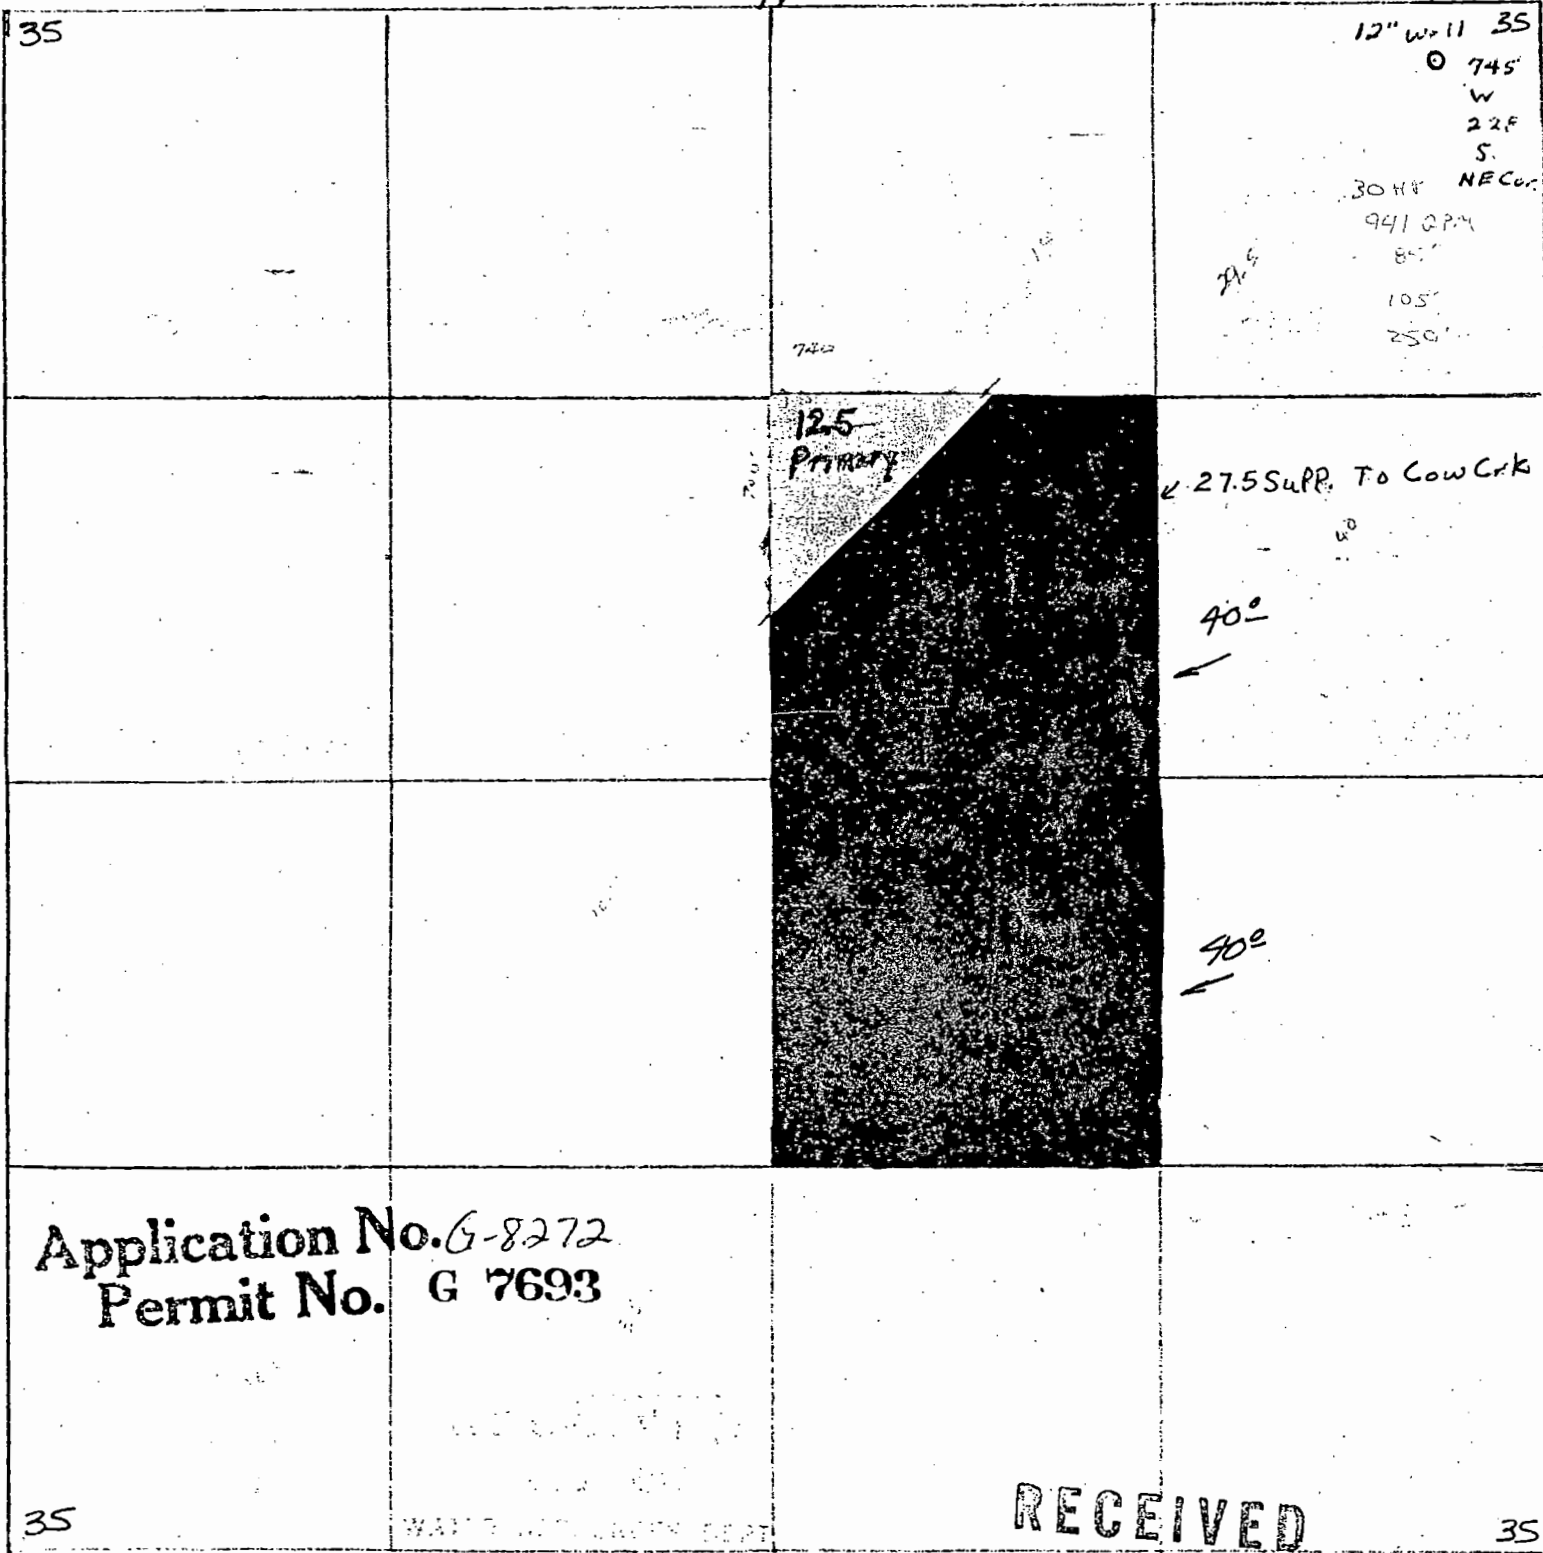

Application No. G-8272
Permit No. G 7693

RECEIVED

NOV 28 1977

WATER RESOURCES DEPT
SALEM, OREGON

S

SECTION PLAT

SEC 35 T12N R 32 1/2 E.

County of HARNEY STATE of OREGON

8" = 1 MC.

N



Application No. G-8272
Permit No. G 7693

RECEIVED

NOV 28 1977
WATER RESOURCES DEPT
SALEM, OREGON

S