

SEE MAP 23S 1

WATER RIGHTS APPLICATION MAP
JIM & DONNA ROBINSON
LOCATED IN THE SW ¼ OF SECTION 03,
TOWNSHIP 23 SOUTH, RANGE 12 WEST, W.M.
TAX LOT 1400
COOS COUNTY, OREGON

SCALE 1" = 400'

LEGEND

- POINT OF BEGINNING
- * POINT OF DIVERSION
- RESIDENCE
- PIPELINE FOR WATER

13-04


13-02

Portion of
P
2014-2

RECEIVED

JUN 08 2021

OWRD

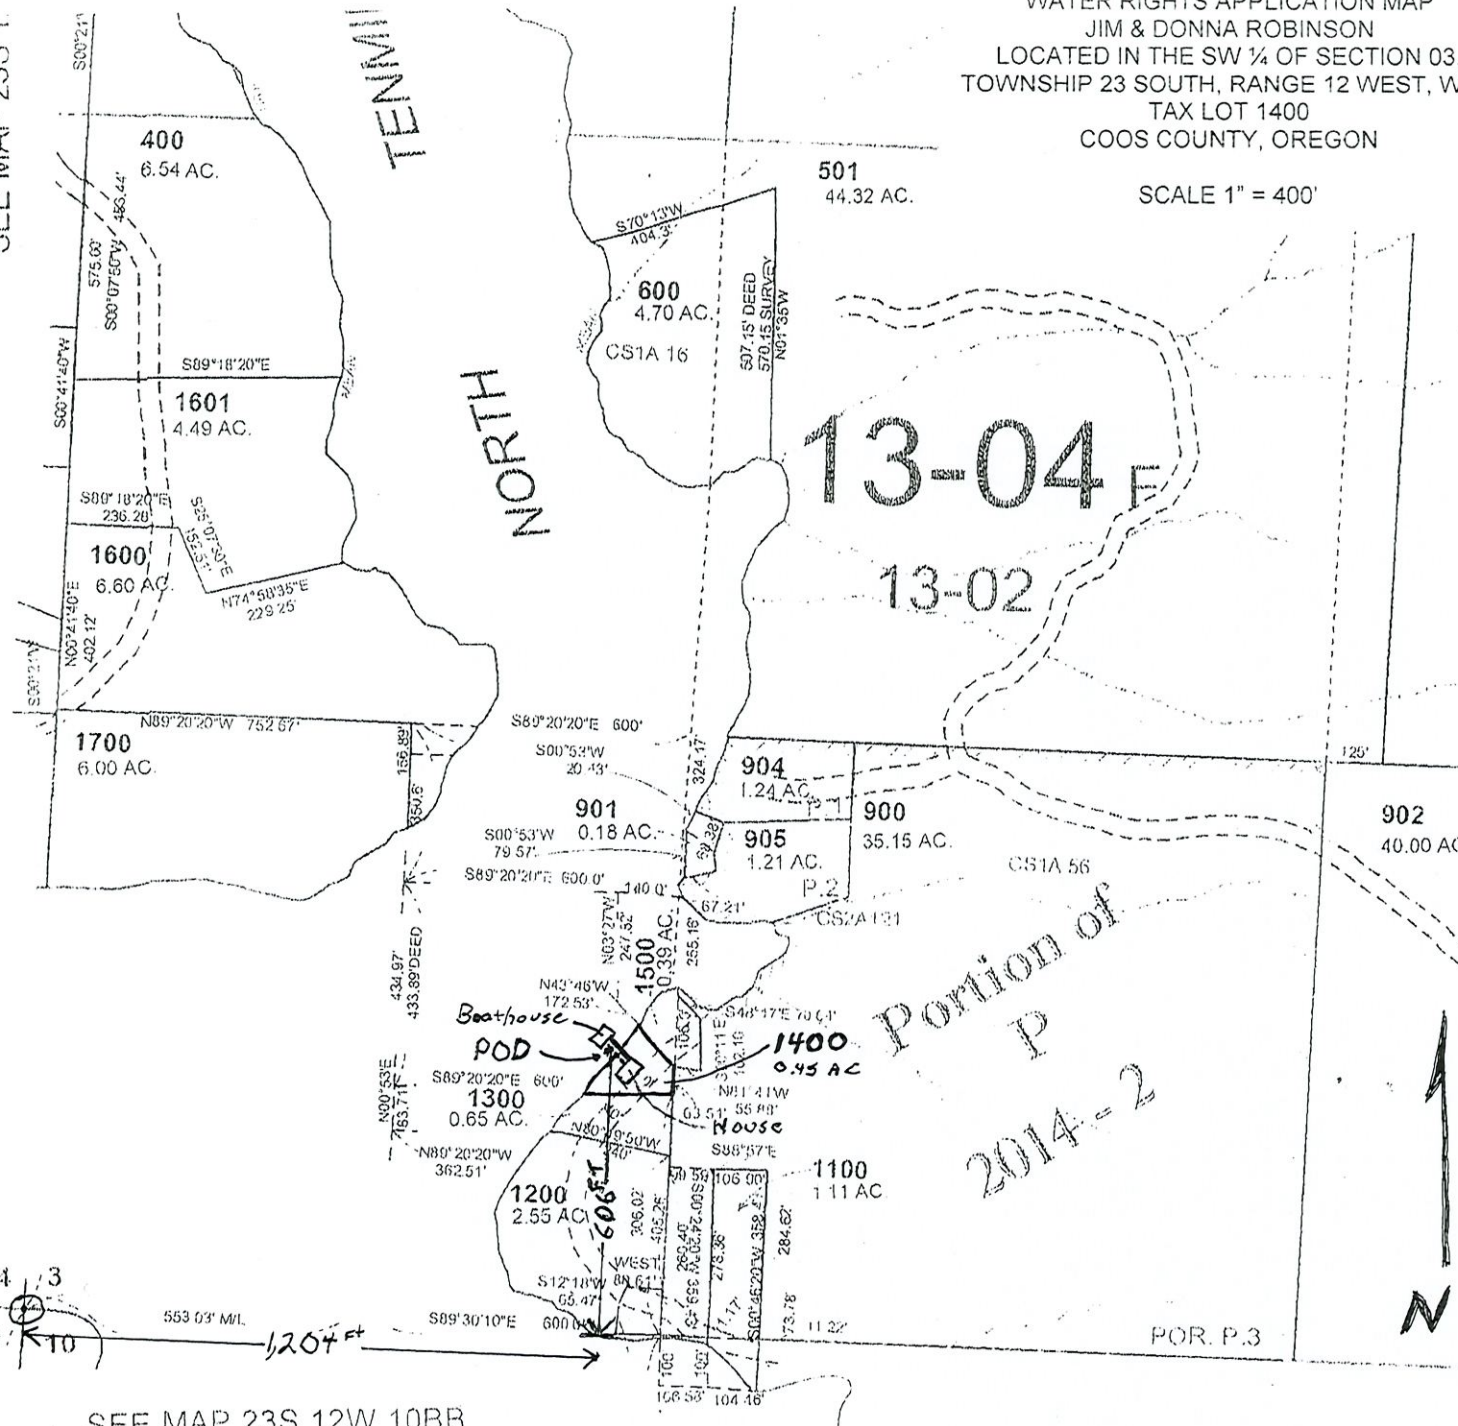

S89°06'W 80.75 CHS G.L.O


NOTE:
THE POINT OF DIVERSION IS AN INLAKE ¾ HP PUMP,
LOCATED 1,204 FEET EAST AND 606 FEET NORTH FROM
THE SOUTHWEST ¼ CORNER OF SECTION 03, TOWNSHIP
23 SOUTH, RANGE 12 WEST.

SEE MAP 23S 12W 10BB

23S 12W 03

CANCELLED NO.

1000
100M2
1602
903

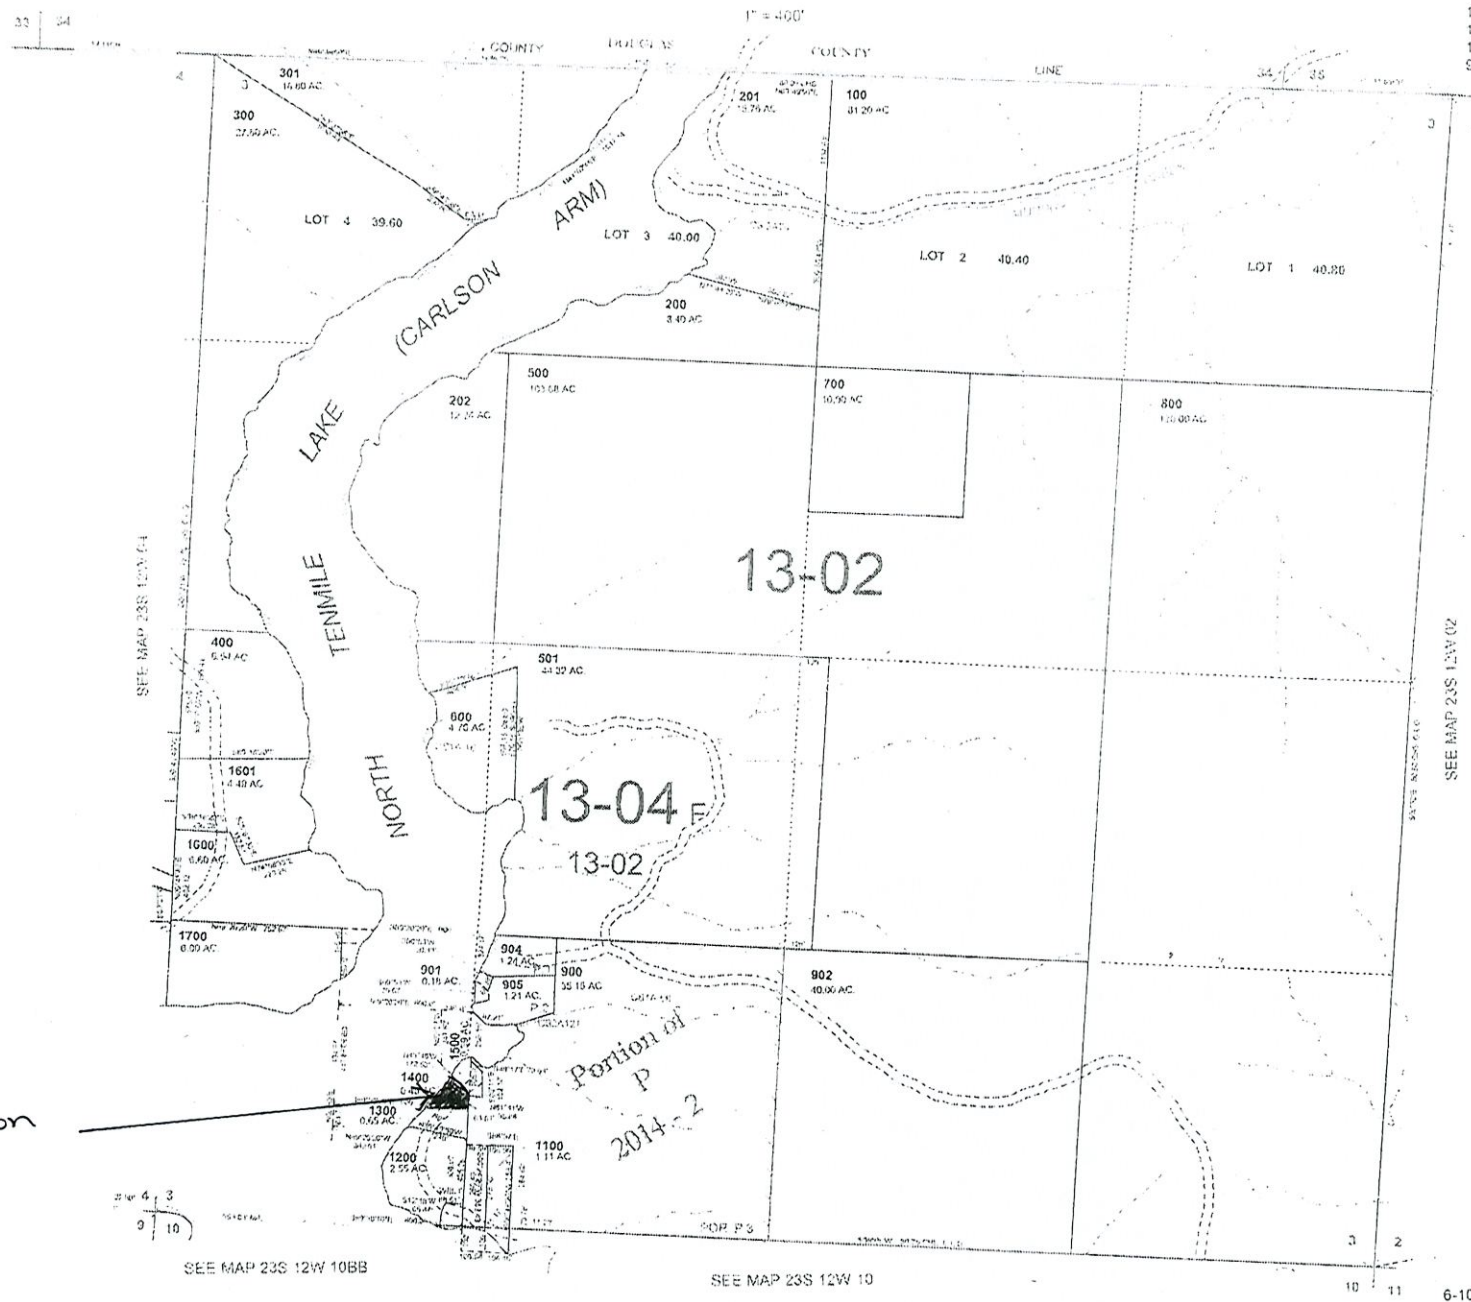

WATER RIGHTS APPLICATION MAP
JIM & DONNA ROBINSON
LOCATED IN THE SW ¼ OF SECTION 03,
TOWNSHIP 23 SOUTH, RANGE 12 WEST, W.M.
TAX LOT 1400
COOS COUNTY, OREGON

RECEIVED

JUN 08 2021

OWARD

6-10-2014

23S 12W 03