

78.5

# CLAIM OF BENEFICIAL USE

## for Reservoirs storing less than 9.2 acre-feet permitted under ORS 537.409



Oregon Water Resources Department  
725 Summer Street NE, Suite A  
Salem, Oregon 97301-1266  
(503) 986-0900  
[www.oregon.gov/OWRD](http://www.oregon.gov/OWRD)

RECEIVED

JUN 21 2021

OWRD

A fee of \$200 must accompany this form.  
The Claim will be returned if the fee is not included.

This form may be completed by the permit holder of record if:

- 1) The permit was issued under the authority of ORS 537.409; and
- 2) No secondary permit exists for the use of water stored in the reservoir; and
- 3) The developed capacity of the reservoir is less than 9.2 acre-feet; and
- 4) The water was stored by the date required in the permit; and

A separate form shall be completed for each permit.

This form must be submitted to the Water Resources Department within one year of storage of water in the reservoir.

Please type or print in dark ink. If the data provided is found to contain errors or omissions, it may be returned. The Department may require the submittal of additional information.

If you have questions regarding the completion of this form, please call 503-986-0900 and ask for the Certificate Section.

### SECTION 1

### GENERAL INFORMATION

#### File Information:

APPLICATION # <b>R-87446</b>	PERMIT # <b>R-15104</b>
---------------------------------	----------------------------

#### Applicant Information:

APPLICANT NAME <b>Eagle Fern Camp</b>	PHONE NO. <b>(503) 630-4978</b>	ADDITIONAL CONTACT NO.	
ADDRESS <b>37700 SE Camp Rd.</b>			
CITY <b>Estacada</b>	STATE <b>OR</b>	ZIP <b>97023</b>	E-MAIL <b>jimb@eagleferncamp.com</b>

RECEIVED

JUN 21 2021

OWRD

SECTION 2  
RESERVOIR INFORMATION

Reservoir Dimensions and Capacity:

AVERAGE LENGTH	AVERAGE WIDTH	AVERAGE DEPTH	MAXIMUM CAPACITY IN ACRE-FEET
215'	93'	4.9'	2.2

To determine capacity in acre-feet use for the above table, use the following calculation:

$$\text{Acre-feet} = \frac{(\text{Average Length})(\text{Average Width})(\text{Average Depth})}{43,560}$$

SECTION 3  
MAP


Attach a map identifying the reservoir location. If the water right application map accurately reflects the location of the reservoir, you may attach a copy of it. Otherwise, you must submit a map meeting the standards of OAR 690-310-0050, which are attached.

Preparation of the map by a Certified Water Rights Examiner is **not** required for this type of permit, but may be submitted.

SECTION 4  
SIGNATURE

*This Claim of Beneficial Use must be signed by each permit holder of record.*


By my signature, I certify that the information contained herein is true and correct to the best of my knowledge.

SIGNATURE	PRINT OR TYPE NAME	TITLE	DATE
	Daniel Joss	President	6/11/21



# Claim of Beneficial Use

Application R-87446, Permit R-15104  
Township 3S, Range 4E, W.M.

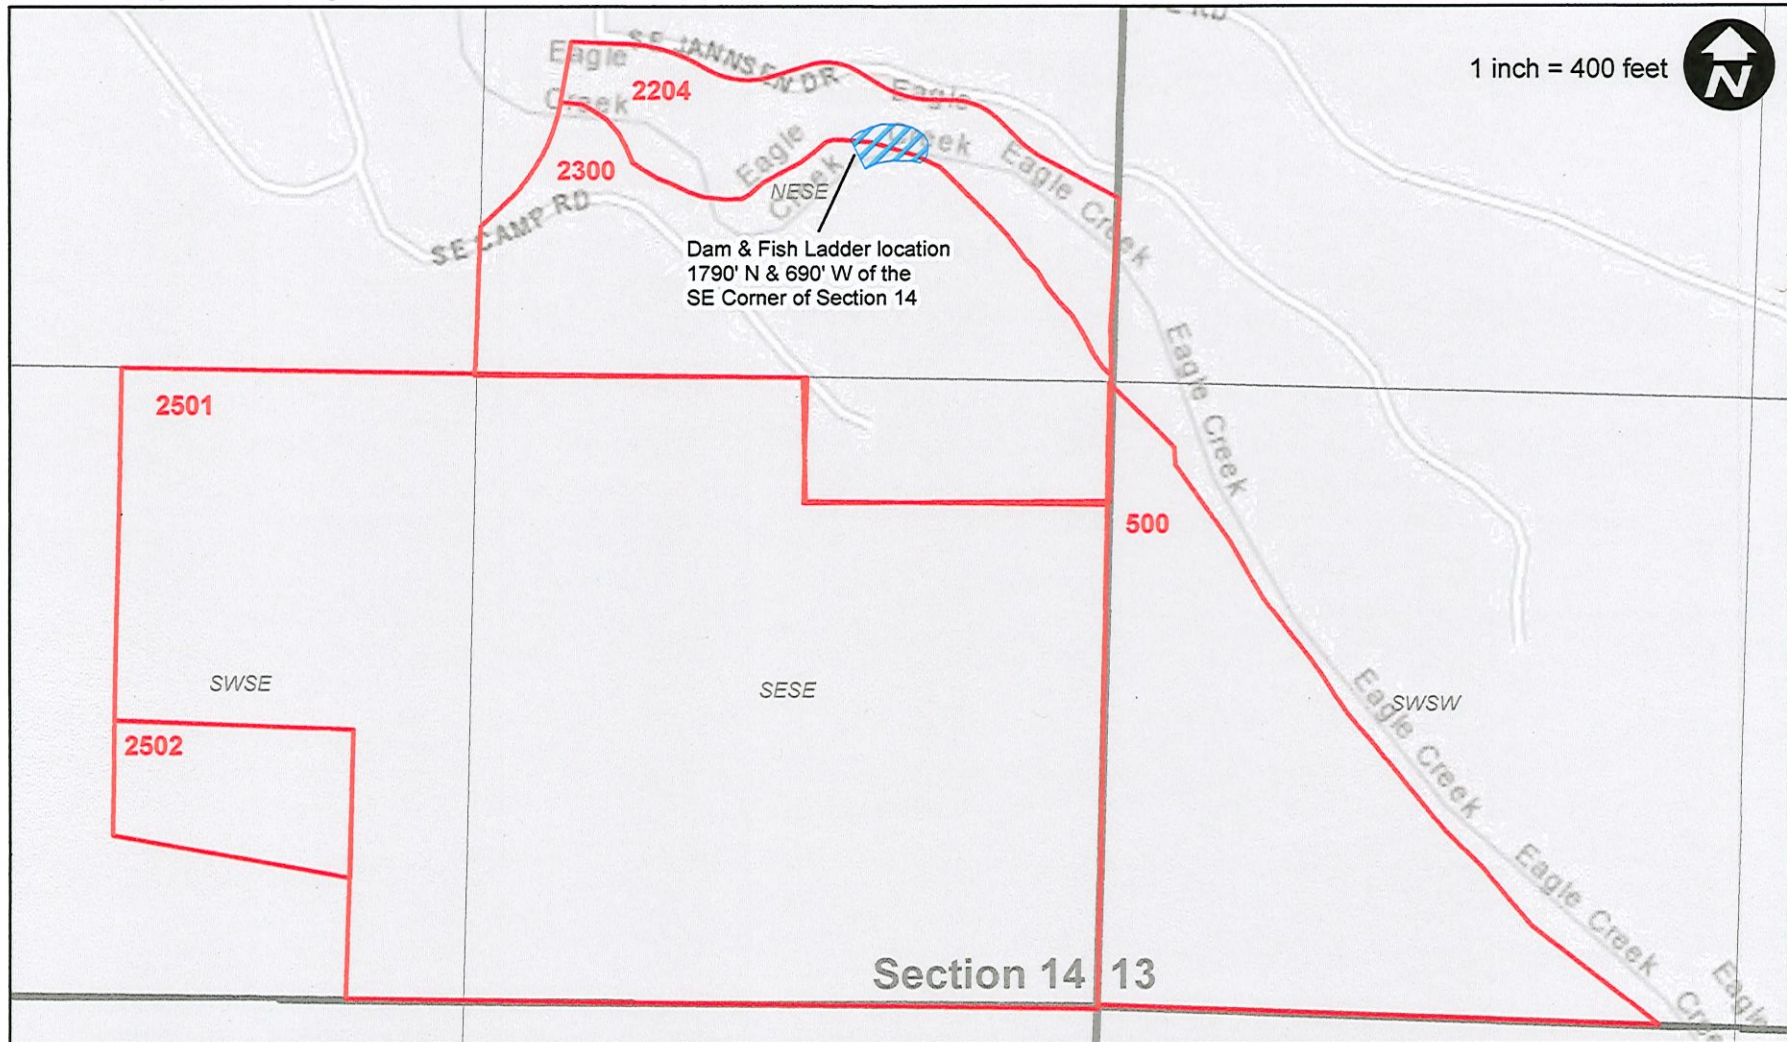

*This map is not intended to provide legal dimensions or locations of property ownership lines.*

## Legend

 Reservoir  Tax Lots

RECEIVED

JUN 21 2021

OWRD

 WILL MCGILL SURVEYING LLC



## Business Registry Business Name Search

[New Search](#)

## Business Entity Data

06-07-2021  
08:04

Registry Nbr	Entity Type	Entity Status	Jurisdiction	Registry Date	Next Renewal Date	Renewal Due?
089265-11	DNP	ACT	OREGON	04-06-1970	04-06-2022	
<b>Entity Name</b>	EAGLE FERN CAMP					
<b>Foreign Name</b>						
<b>Non Profit Type</b>	RELIGIOUS					

RECEIVED

JUN 21 2021

[New Search](#)

## Associated Names

OWRD

Type	PPB	PRINCIPAL PLACE OF BUSINESS				
<b>Addr 1</b>	37700 SE CAMP ROAD					
<b>Addr 2</b>						
<b>CSZ</b>	ESTACADA	OR	97023	<b>Country</b>	UNITED STATES OF AMERICA	

Please click [here](#) for general information about registered agents and service of process.

Type	AGT	REGISTERED AGENT	Start Date	03-05-2019	Resign Date	
<b>Name</b>	SANDRA		STONE			
<b>Addr 1</b>	150 SE 80TH AVE					
<b>Addr 2</b>						
<b>CSZ</b>	PORTLAND	OR	97215	<b>Country</b>	UNITED STATES OF AMERICA	

Type	MAL	MAILING ADDRESS				
<b>Addr 1</b>	37700 SE CAMP RD					
<b>Addr 2</b>						
<b>CSZ</b>	ESTACADA	OR	97023	<b>Country</b>	UNITED STATES OF AMERICA	

Type	PRE	PRESIDENT			Resign Date	
<b>Name</b>	DAN		JOSSI			
<b>Addr 1</b>	23830 SE EAGALE CREEK RD					
<b>Addr 2</b>						
<b>CSZ</b>	EAGLE CREEK	OR	97022	<b>Country</b>	UNITED STATES OF AMERICA	

Type	SEC	SECRETARY			Resign Date	
<b>Name</b>	AMBER		SMART			
<b>Addr 1</b>	911 SW 8TH ST					
<b>Addr 2</b>						
<b>CSZ</b>	GRESHAM	OR	97080	<b>Country</b>	UNITED STATES OF AMERICA	

[New Search](#)

## Name History

Business Entity Name	Name Type	Name Status	Start Date	End Date
EAGLE FERN CAMP	EN	CUR	04-09-1992	
EAGLE FERN YOUTH CAMP	EN	PRE	04-06-1970	04-09-1992



# EAGLE FERN YOUTH CAMP DAM & FISHLADDER - FOUNDATION

ECW Dwg 9/97

(WITH DAM & FISHLADDER WALLS REMOVED)

Elevations (El.) are relative.

Natural Creek Bank

Fishladder Footing

River gravel El. 9±

Creek bottom depth during July & August is 2.7'.  
Min. water depth at sill El. 7.0

Boulder deposited by stream before 950, (6' x 5' x 5').

Embankment

El. 14.25 Top of Abutment

Footing width 2.0' typical except as noted.

El. 10.75

El. 10

Top of buttress d/s footing even w/ creek bottom

Fishladder Slab

El. 8.5'

13.3'

8.0'

1.5'

6.5'

1.5'

El. 10

El. 9.25

El. 8.5

El. 7.75

El. 9.25

El. 8.5

El. 7.75

Flow

Concrete Dam Footing

Solid Rock Shelf El. 10.2±

Solid Rock wall: 0.7' Concrete Abutment

PLAN 1/8" = 1'-0"

Center Line of buttress slots

110.5'

8.0'

10.0'

10.0'

9.2'

9.67'

Embankment

Concrete Abutment

Concrete Dam Footing

Concrete Footing

Concrete Footing

Concrete abutment placed against bed rock.

Concrete abutment placed against bed rock.

Concrete abutment placed against bed rock.

Natural bank u/s & d/s of embankment.

River rock, 10" minus.

Bottom of Dam footing. Top of river gravel.

0.75' each

Boulder

6'

1.5'

1.5'

3.6'

Bedrock at Dam Footing.

Bedrock





Solid rock 6' d/s of dam

Solid rock just downstream of dam

RECEIVED

JUN 21 2021


OWRD

ELEVATION 1/8" = 1'-0"  
(Elevations are relative)



EAGLE FERN  
YOUTH CAMP  
ECW  
Dwg 9/97


# DAM & FISH LADDER (with walls in place) $\frac{1}{8}'' = 1'-0''$

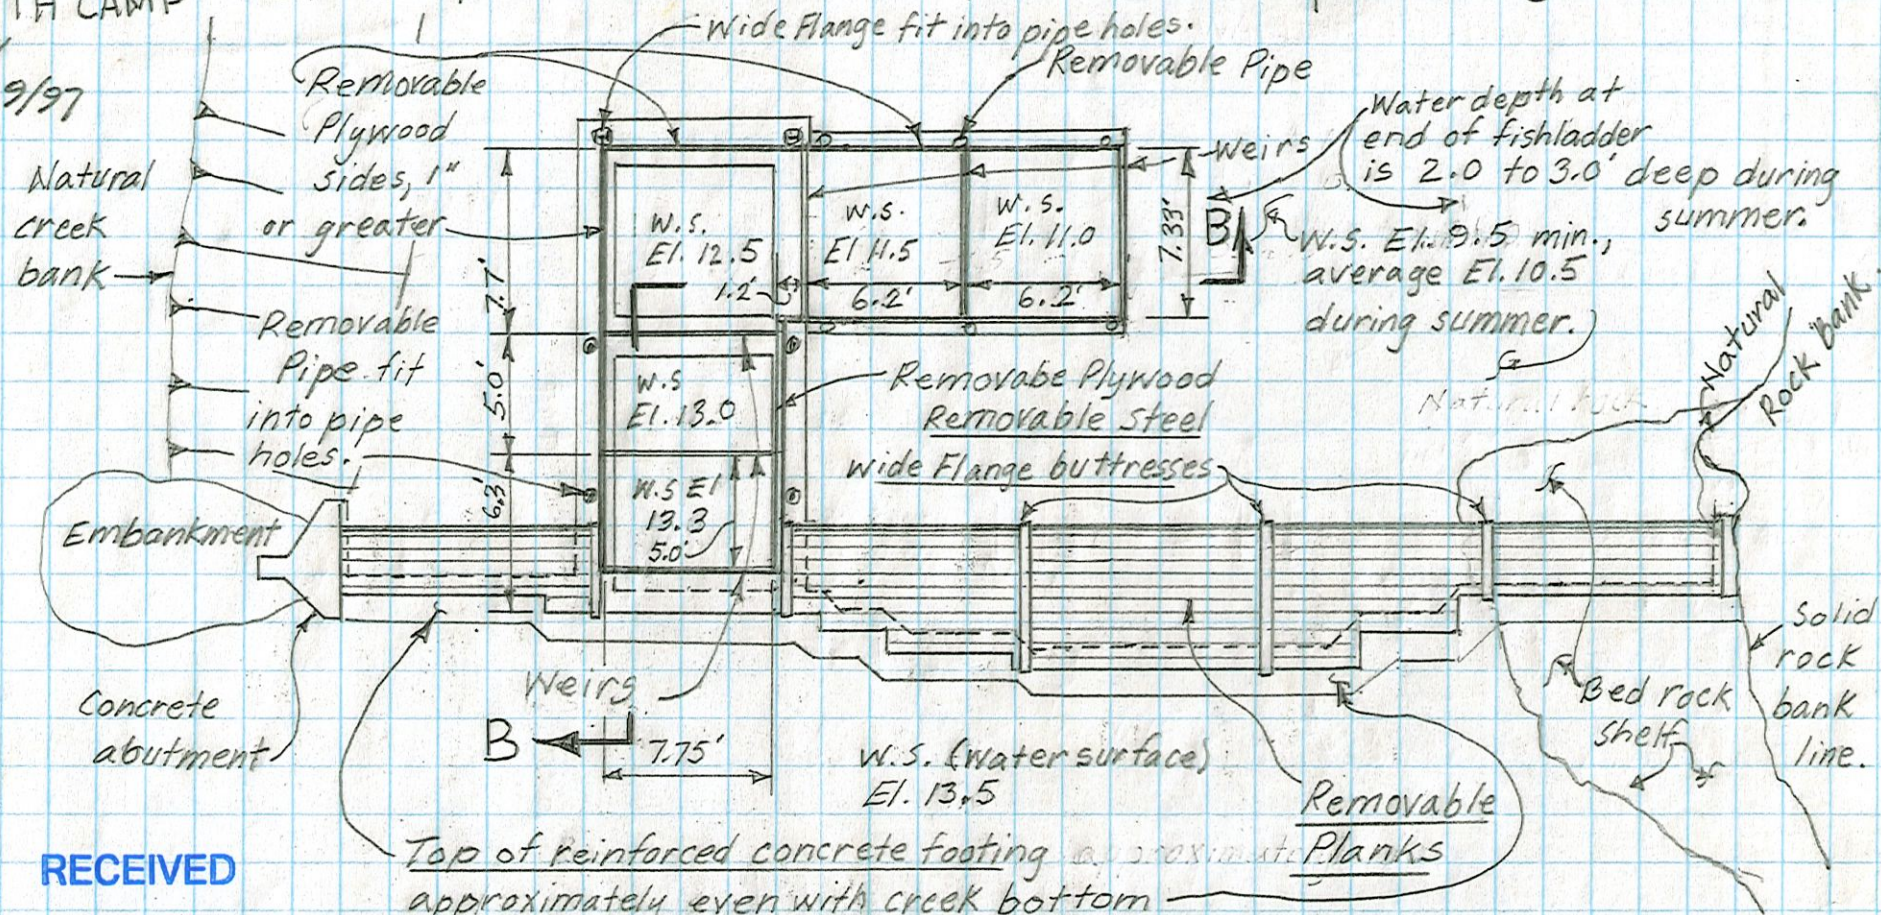

RECEIVED  
JUN 21 2021

Top of reinforced concrete footing approximately even with creek bottom

## PLAN $\frac{1}{8}'' = 1'-0''$

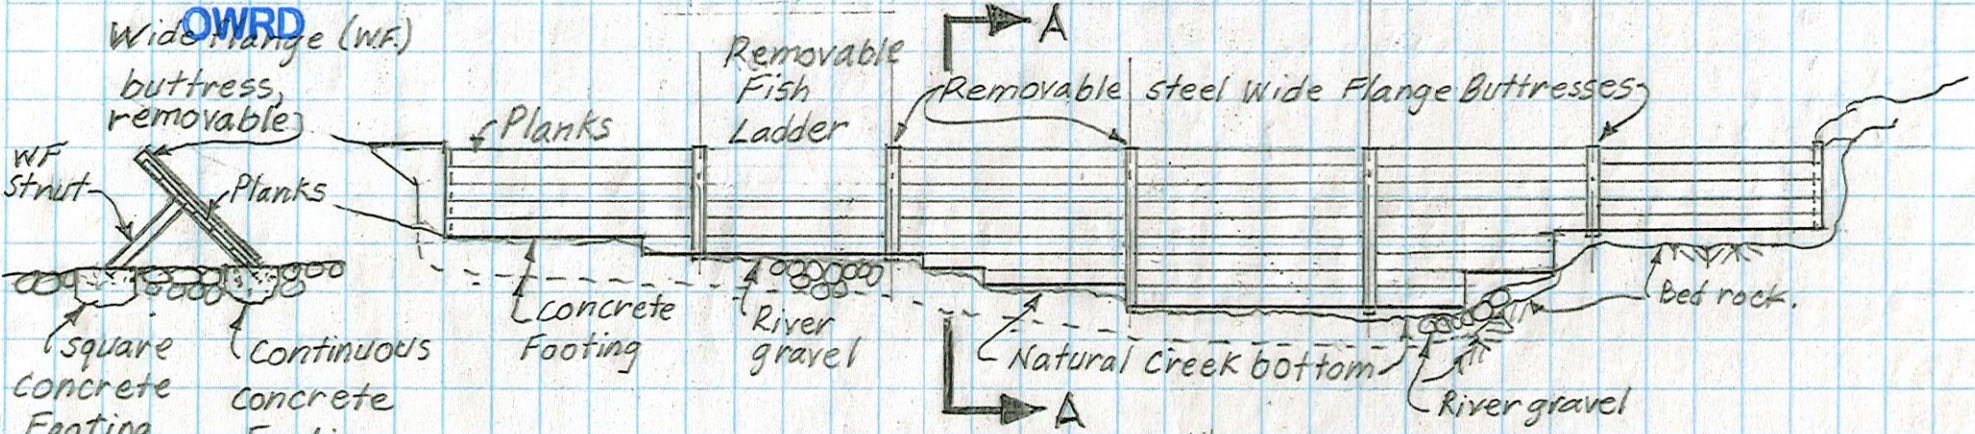

## SECTION A-A

ELEVATION  $\frac{1}{8}'' = 1'-0''$  Note: All removable members to be placed & removed as recommended by ODFW (Looking Downstream)



EAGLE FERN  
YOUTH CAMP  
ECW, Dwg 9/97

# DAM & DOCK LOCATION

1" = 30' (Approx)

Original dam & Fishladder  
built in 1960. Fishladder  
was rebuilt to Oregon  
State Fish & Wildlife  
recommendations  
in 1985.



## SECTION D-D

1" = 30'

Natural  
Creek  
bank

FLOW

Dam placement  
and removal to be  
timed according to  
Oregon State Dept.  
of Fish & Wildlife  
consultation.

Boulder

Dam abutments

Natural  
solid rock  
creek bank

w.s. with  
dam in place

Dock placed  
at the last of  
June & removed  
at the last of  
August


Stream edge  
during summer  
when dam is not  
in place.

Footings for  
this pier are removed  
after August.



## SECTION C-C (Dock in Place)

FLOW

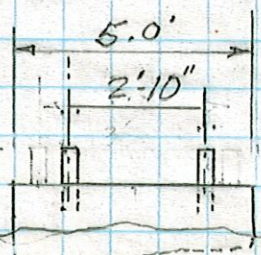

## SECTION C-C (Dock Removed)

1/2" = 1'-0"

RECEIVED

JUN 21 2021

OWRD

## SITE PLAN

1" = 30' (Approx)





**Oregon**  
Kate Brown, Governor

**Water Resources Department**

725 Summer St NE, Suite A

Salem, OR 97301

(503) 986-0900

Fax (503) 986-0904

June 24, 2021

KCK Partners LLC  
11483 SE Amity Dayton Highway  
Dayton OR 97114

On June 21, 2021, the Water Resources Department received the Claim of Beneficial Use (COBU) for the following Transfer(s):

T-12601

The COBU included a report and map. The Department hopes to review your submittal within approximately 2 - 4 years. At that time we will review these items and provide a final certificate, proposed certificate, or a request for additional information.

If you are interested in having your COBU reviewed sooner, you may pay to have your file processed immediately, using the Reimbursement Authority program, which is described at:

<https://www.oregon.gov/OWRD/programs/WaterRights/RA/Pages/Certificate.aspx>

For all other questions please call our Customer Service phone: (503) 986-0900.

If you sell the property, please contact the Department, or have the new owners contact the Department about the need to file an assignment.

cc: file T-12601  
Doann Hamilton, CWRE



# Checklist for Claims of Beneficial Use Received at CSG Counter

Application #:	WRD Reviewer:
Transfer #:	
Date Received:	
CWRE Name:	
Priority Date (s):	

## Fees Required:

- YES  NO  A fee of \$200 must accompany this form for permits with priority dates of July 9, 1987, or later.
- YES  NO  A fee of \$200 must accompany this form for any transfers including a water right with a priority date of July 9, 1987, or later.  
 Example – A transfer involves 5 rights and one of the rights has a priority date of July 9, 1987, or later, the fee is required.

Fill in App or Transfer Number

## Map Review:

- Map on polyester film (OAR 690-014-0170(1) & 310-0050(1)(b))
- Application & permit #; or transfer # (OAR 690-014-0100(1))
- Disclaimer (OAR 690-014-0170(5))
- North arrow (OAR 690-310-0050(2)(c))
- CWRE stamp and signature (OAR 690-014 & 310-0050)
- Appropriate scale (1" = 1320', 1" = 400', or the original full-size scale of the county assessor map) (014 & 310)
- Township, range, section, and tax lot numbers (OAR 690-310-0050(4) )

## Report Review:

- On form provided by the Department (OAR 690-014-0100(1))
- Application & permit #; or transfer # (OAR 690-014)
- Ownership information (OAR 690-014)
- Date of survey (OAR 690-014)
- Person interviewed (OAR 690-014)
- County (OAR 690-014)
- CWRE stamp and signature (OAR 690-014-0100)
- Signature(s) of all permittee of transfer holder (OAR 690-014-0100)

**MONEY SLIP**

DATE: \_\_\_\_\_ RECEIPT #: \_\_\_\_\_

RECEIVED FROM: \_\_\_\_\_ APPLICATION PERMIT TRANSFER

CASH  CHECK # \_\_\_\_\_ OTHER (IDENTIFY) \_\_\_\_\_ TOTAL RECD \$ \_\_\_\_\_

**1083 TREASURY 4178 MISC CASH ACCT.**

0407 COPIES \_\_\_\_\_ \$ \_\_\_\_\_  
 OTHER: (IDENTIFY) \_\_\_\_\_ \$ \_\_\_\_\_

0243 Instream Lease \_\_\_\_\_ 0244 Muni Water Mgmt. Plan \_\_\_\_\_ 0245 Cons. Water \_\_\_\_\_

**1083 TREASURY 4270 WRD OPERATING ACCT.**

MISCELLANEOUS

0407 COPY & TAPE FEES 4611 \$ \_\_\_\_\_

0410 RESEARCH FEES \$ \_\_\_\_\_

0409 MISC REVENUE (IDENTIFY) \$ \_\_\_\_\_

TC162 DEPOSIT LIAB. (IDENTIFY) \$ \_\_\_\_\_

0240 EXTENSION OF TIME \$ \_\_\_\_\_

**WATER RIGHTS**

0201 SURFACE WATER EXAM FEE \$ \_\_\_\_\_ RECORD FEE \$ \_\_\_\_\_

0203 GROUND WATER \$ \_\_\_\_\_ 0202 \$ \_\_\_\_\_

0205 TRANSFER \$ \_\_\_\_\_ 0204 \$ \_\_\_\_\_

**WELL CONSTRUCTION**

0218 WELL DRILL CONSTRUCTOR EXAM FEE \$ \_\_\_\_\_ RECORD FEE \$ \_\_\_\_\_

LANDOWNER'S PERMIT \$ \_\_\_\_\_ 0219 \$ \_\_\_\_\_

OTHER (IDENTIFY) COBU \$ 200.00 0220 \$ \_\_\_\_\_

**0607 TREASURY 0487 HYDROELECTRIC**

0233 POWER LICENSE FEE (FWWRD) LIC NUMBER \_\_\_\_\_ \$ \_\_\_\_\_

0231 HYDRO LICENSE FEE (FWWRD) \_\_\_\_\_ \$ \_\_\_\_\_

HYDRO APPLICATION \$ \_\_\_\_\_

**SPECIAL INSTRUCTIONS:**

RETURN TO APPLICANT -- LETTER ATTACHED

## Groundwater File Review:

- Pump Test not required (Priority Date prior to December 20, 1988) \*If no, include pump test flyer w/acknowledgment letter
- Pump Test required (Priority Date on or after December 20, 1988)
- Pump Test submitted
- Pump Test not submitted