


CLAIM OF BENEFICIAL USE MAP  
 IN THE NAME OF  
 GARY D. BORK AND CAROL J. BORK


SE 1/4 of SE 1/4 Section 18, T.6 S., R.1 E., W.M.  
 MARION County, Oregon  
 FINAL SURVEY SEPT. 10, 2000

APPLICATION NO. S-73815 PERMIT NO. R-11599

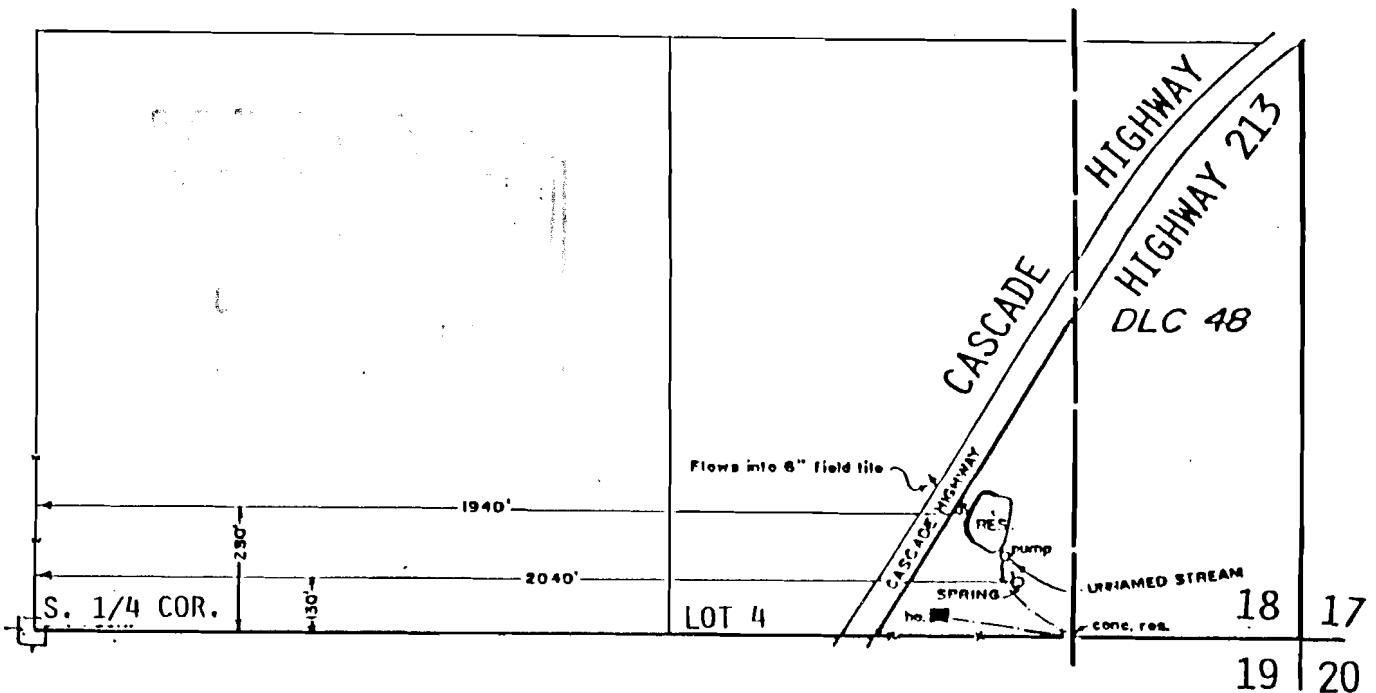

BASE IS ASSESSORS MAP 6S 1 18 AND  
 DONALD R. BUELL, CWRE APPLICATION MAP

RESERVOIR IS LOCATED 280 FEET NORTH AND  
 1940 FEET EAST OF THE SOUTH 1/4 CORNER  

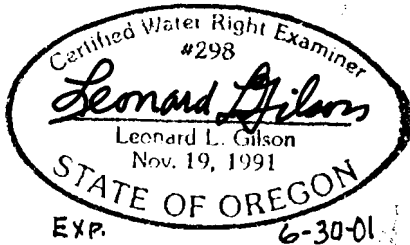

This map is for the purpose  
 of locating a water right only  
 and has no intent to provide  
 legal dimension or the location  
 of property lines.



SCALE: 1" = 400'

LEONARD L. GILSON, P.E., P.L.S.  
 ENGINEERING - SURVEYING  
 7275 SW 82<sup>ND</sup> AVE.  
 PORTLAND, OR 97223-7319  
 PHONE: (503) 246-1612  
 (503) 838-5611