

THIS MAP WAS PREPARED FOR ASSESSMENT PURPOSE ONLY

SECTION 19 T.11S. R.4W. W.M.
BENTON COUNTY




11 4 19


Well GPS
44,594755
-123,226733
875' North
1090 East
from SW
Corner Sec 19

SWSW
3.42 acres

Tax Lot 1201

To 
6/28/21

RECEIVED
JUN 29 2021
OWRD

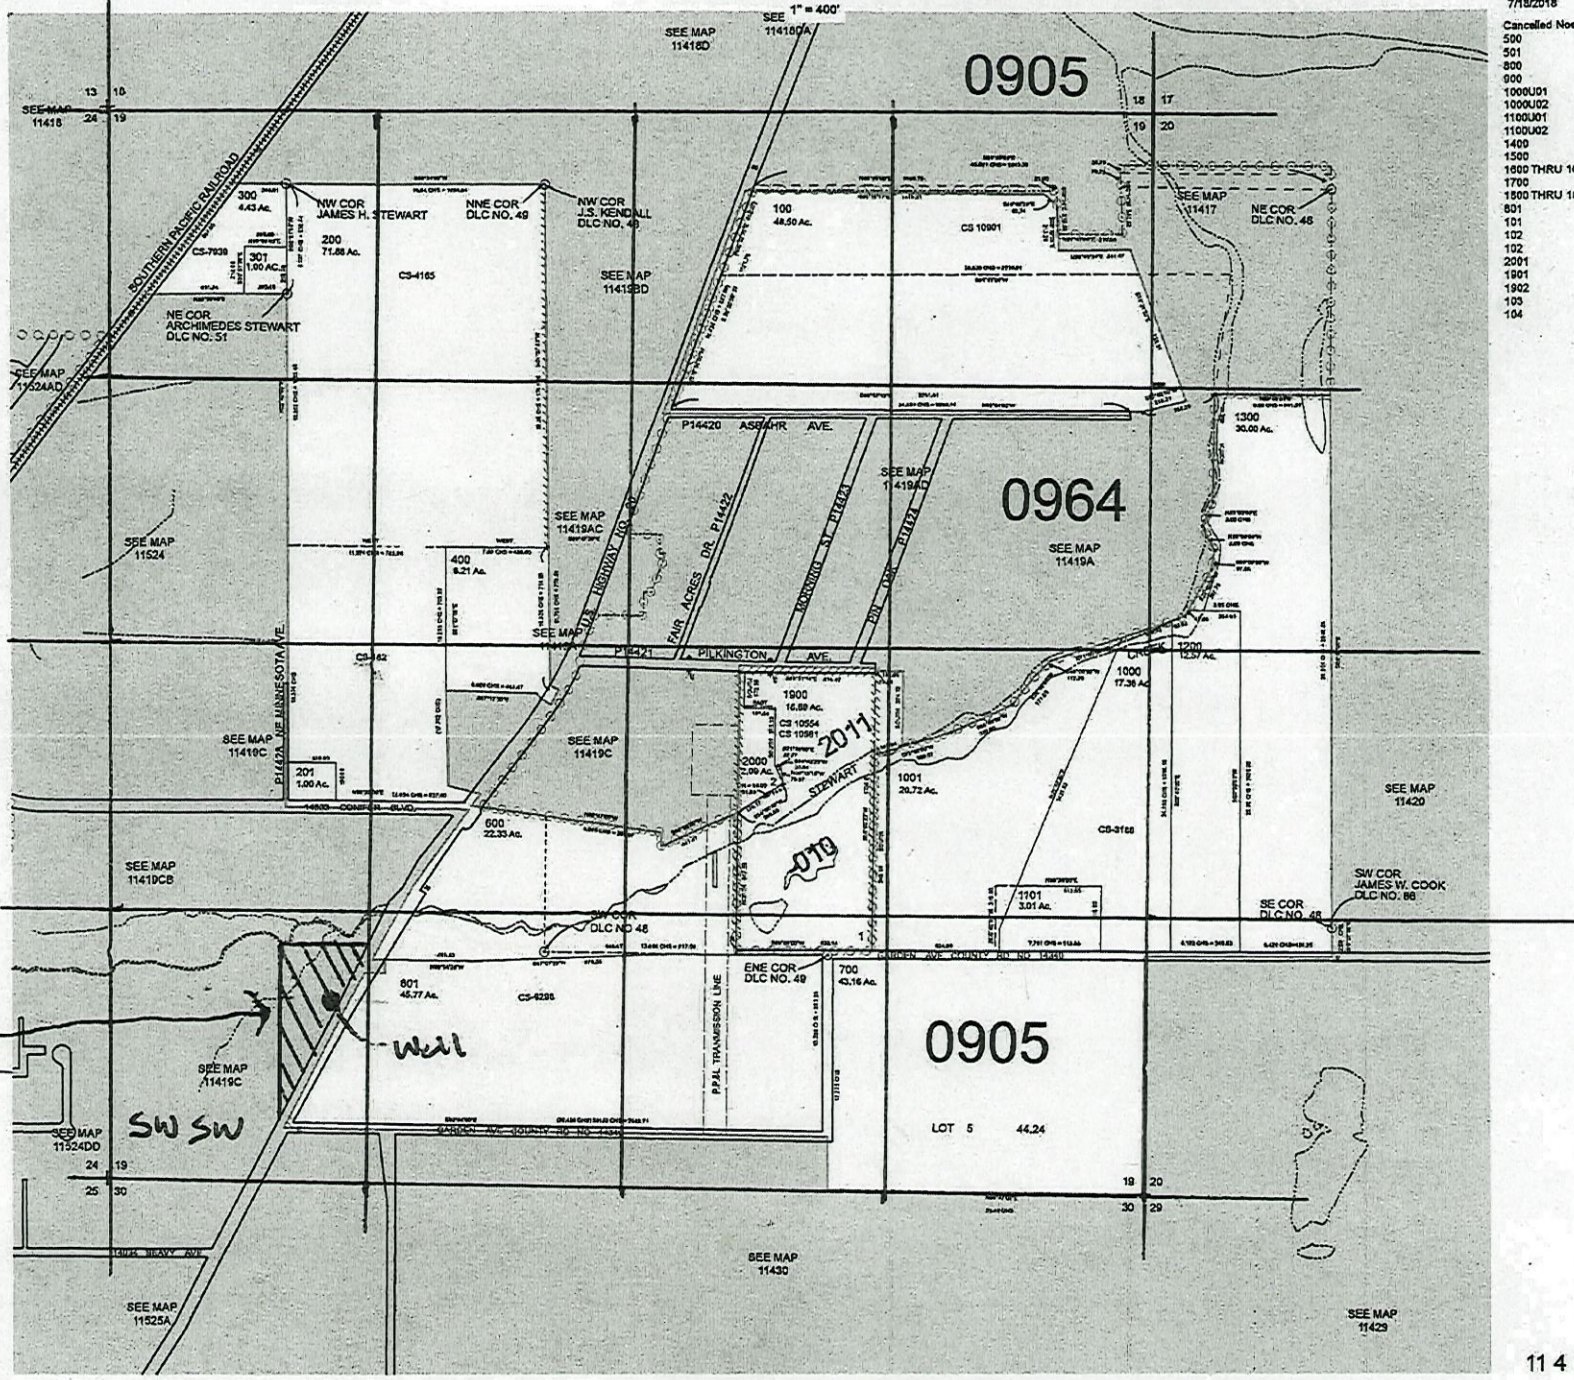

- 7/19/2018
- Cancelled Nos.
- 500
- 501
- 800
- 900
- 1000J01
- 1000J02
- 1100J01
- 1100J02
- 1400
- 1500
- 1600 THRU 1600
- 1700
- 1800 THRU 1802
- 801
- 101
- 102
- 102
- 2001
- 1901
- 1902
- 103
- 104

11 4 19

1100
0.87 Ac

14333

BENTON COUNTY M-2490
N89°40'00"E

NE MIT

1200
8.22 Ac

0905

SEE MAP
11419CB

1201
3.42 Ac

U.S. HIGHWAY NO. 20

1300
0.03 Ac
CS-3500

CS-3169

RECEIVED
JUN 29 2021
OWRD

700
1.96
Ac

1801
3.95 Ac

26°00'W

N89°38'00"E 300.00'

1800

