
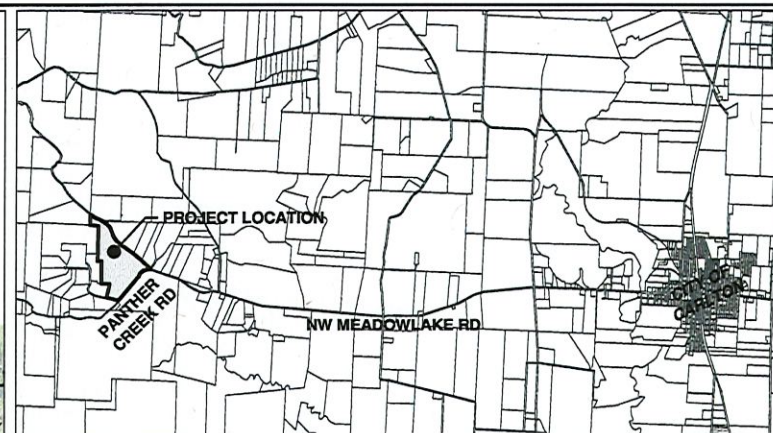


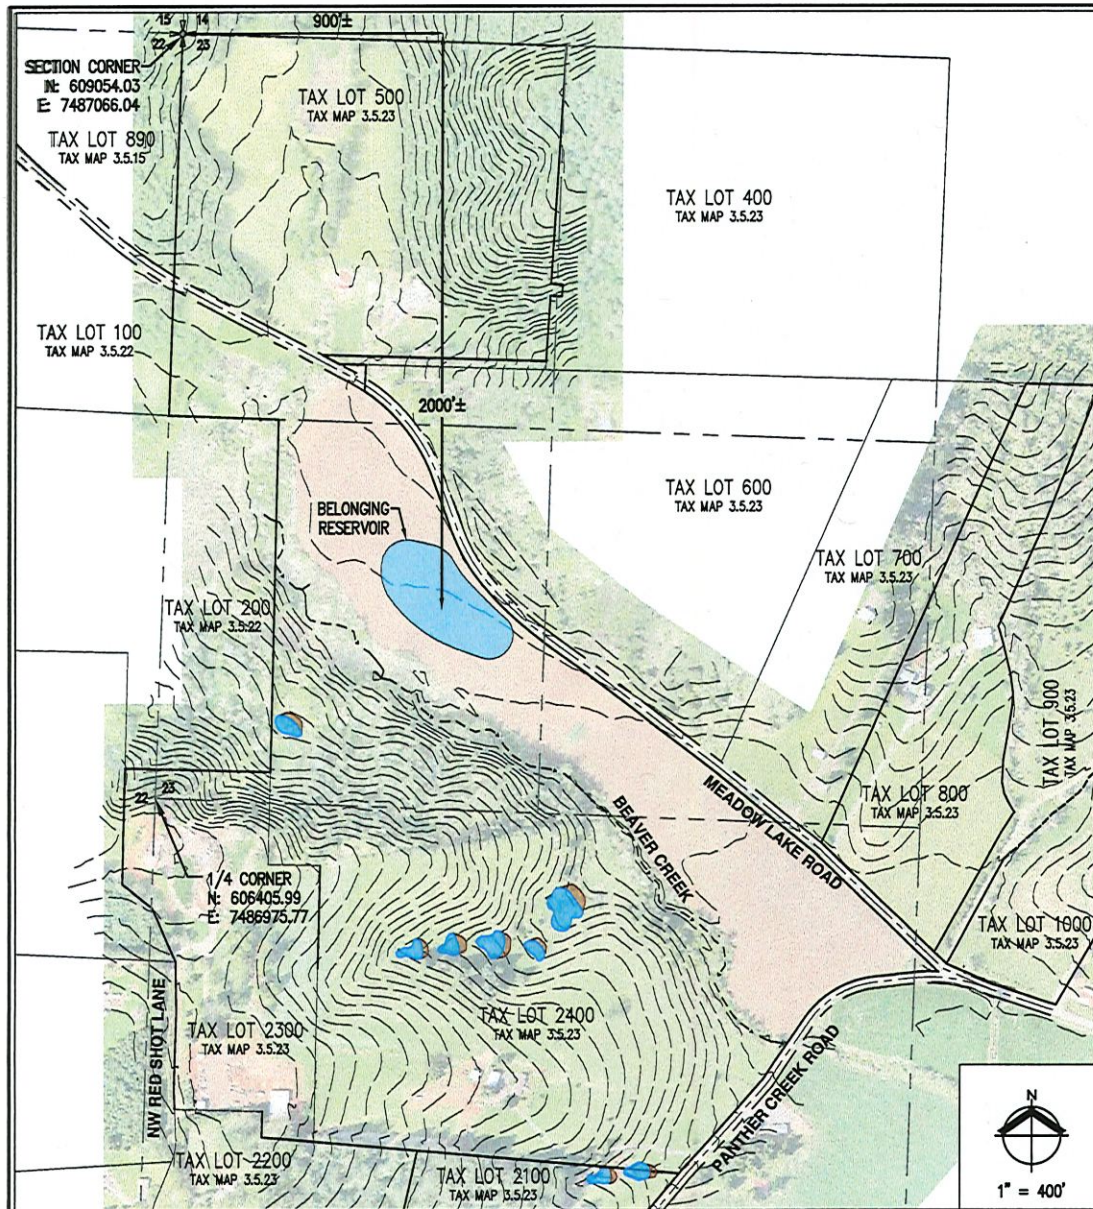

VICINITY MAP
1" = 5,000'

RESERVOIR DATA:
RESERVOIR LOCATED IN THE SOUTHWEST 1/4 OF THE NORTHWEST
1/4 OF SECTION 23, TOWNSHIP 3 SOUTH, RANGE 5 WEST,
WILLAMETTE MERIDIAN, YAMHILL COUNTY, OREGON.

900'± EAST OF NORTHWEST CORNER OF SECTION 23
2,000'± SOUTH OF NORTHWEST CORNER OF SECTION 23

RECEIVED

JUL 06 2021

OWRD

BELONGING RESERVOIR SITE PLAN MAP DATE: 5/19/2021