


T. 7 S.R. 46 E.W.M.

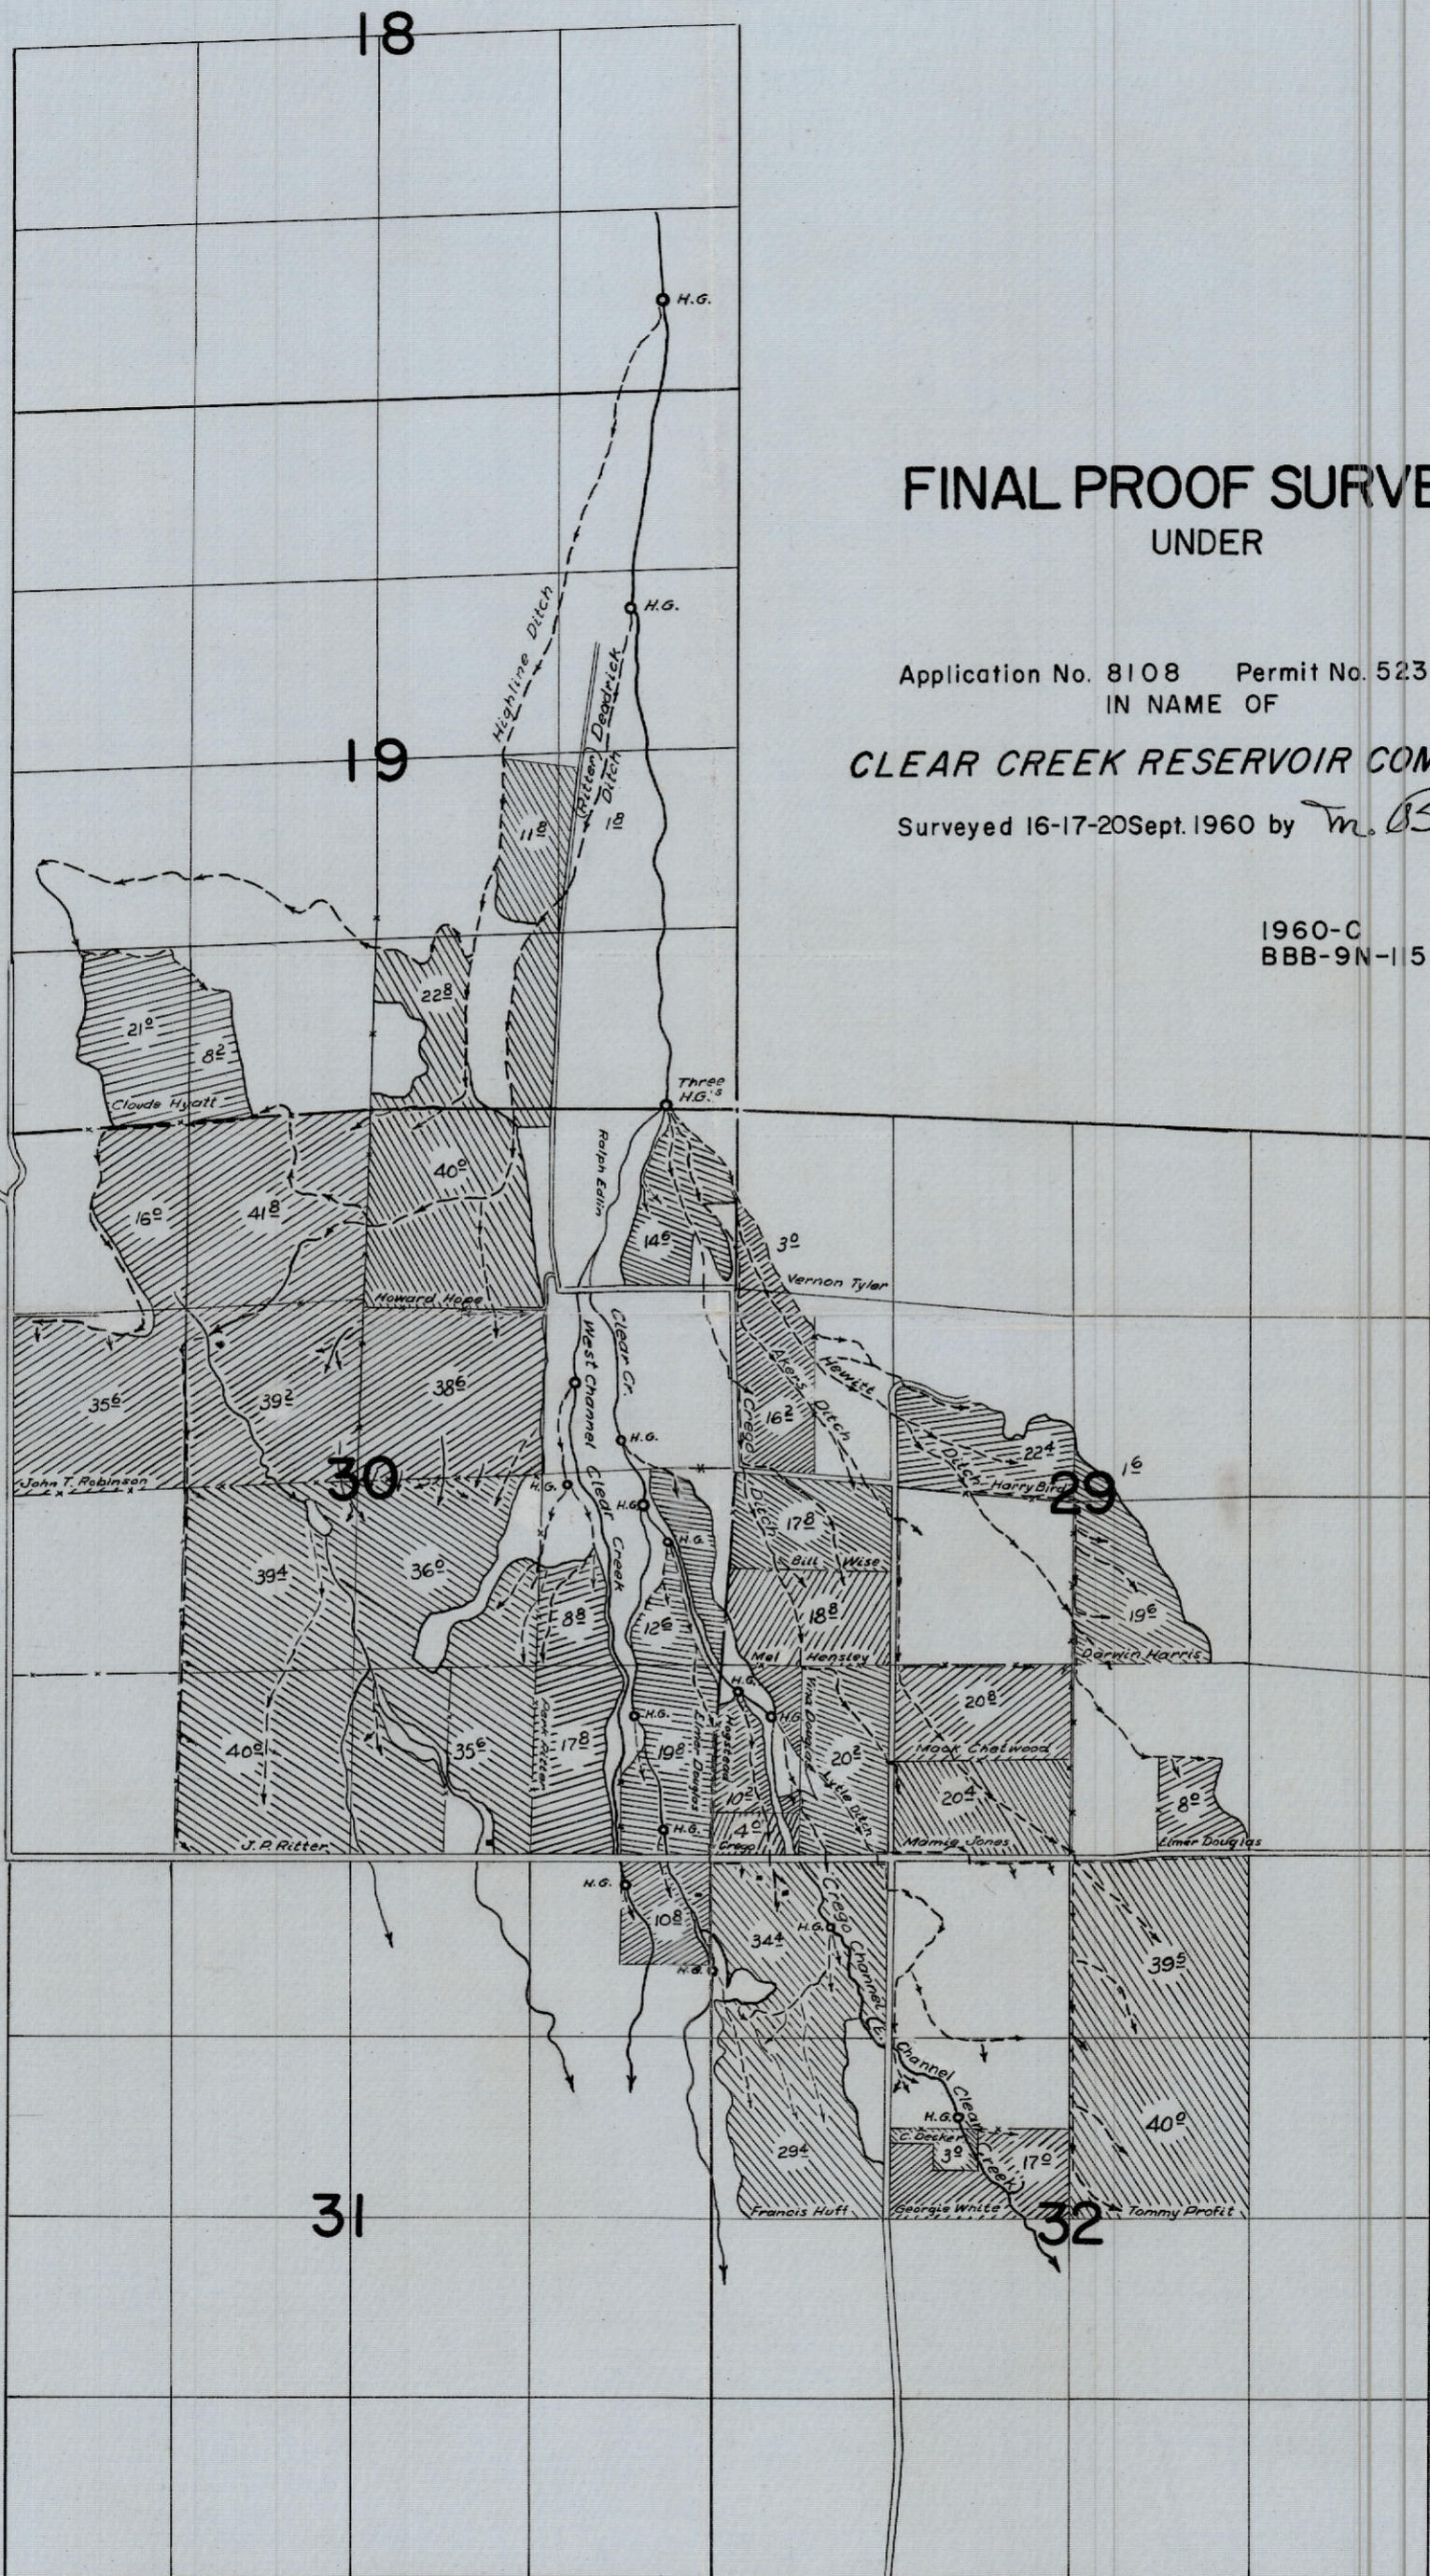

FINAL PROOF SURVEY
UNDER

Application No. 8108 Permit No. 5234
IN NAME OF
CLEAR CREEK RESERVOIR COMPANY
Surveyed 16-17-20 Sept. 1960 by *M. Bish*

1960-C
BBB-9N-15