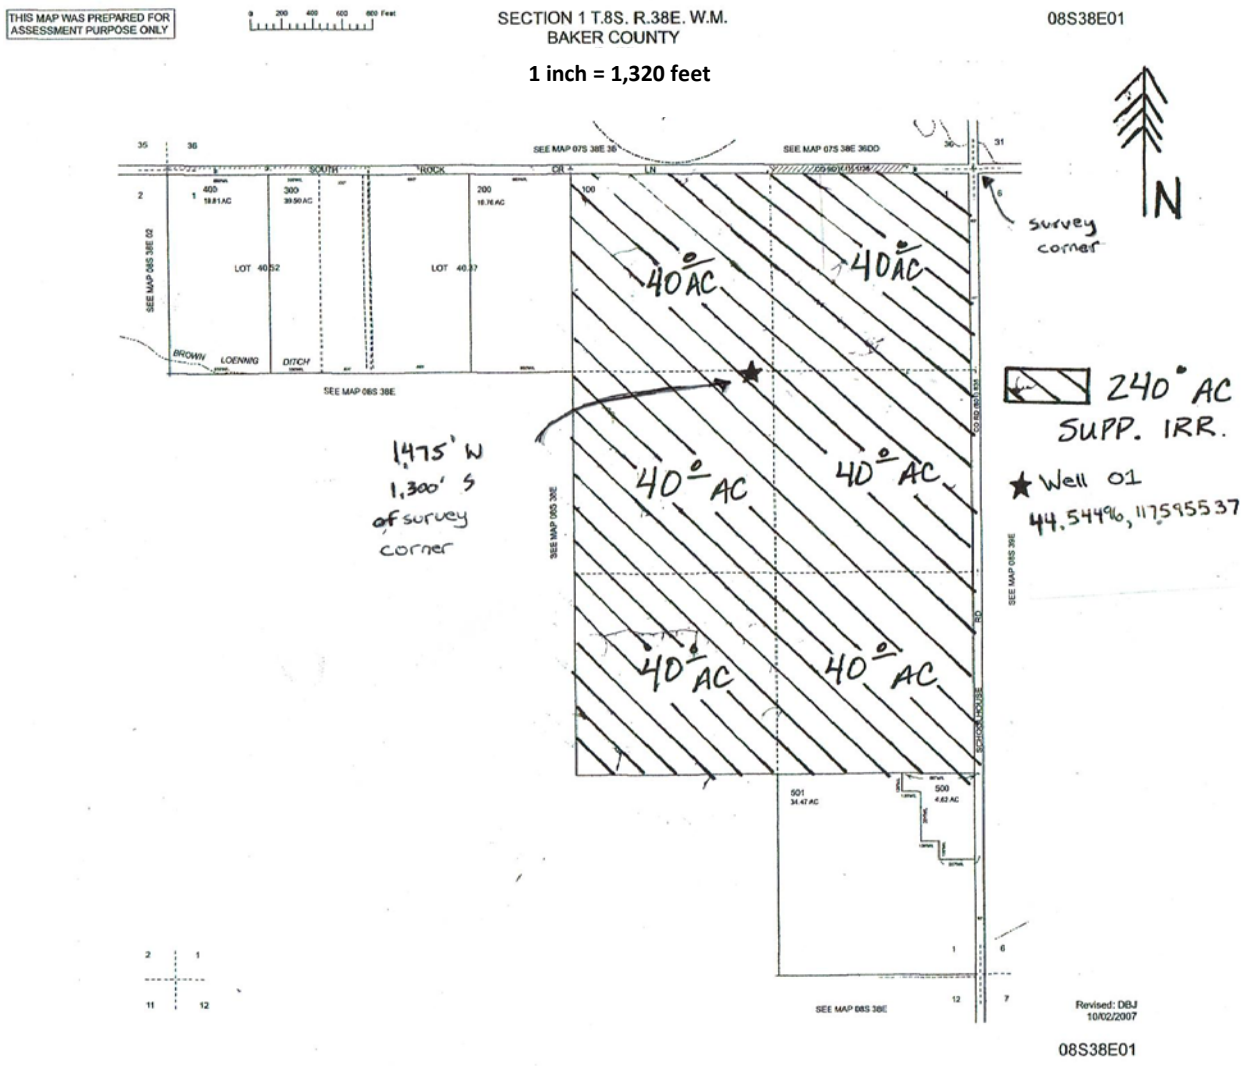E-RECEIVED
AUG 02 2021
OWRD