

Robertson Map

1" = 1320'

Tax Lot:

Township 9 South, Range 6 West, Section 23 & 24, Tax Lot 101 & 200


RECEIVED
JUL 26 2021



RECEIVED
JUN 25 2021

OWRD

OWRD

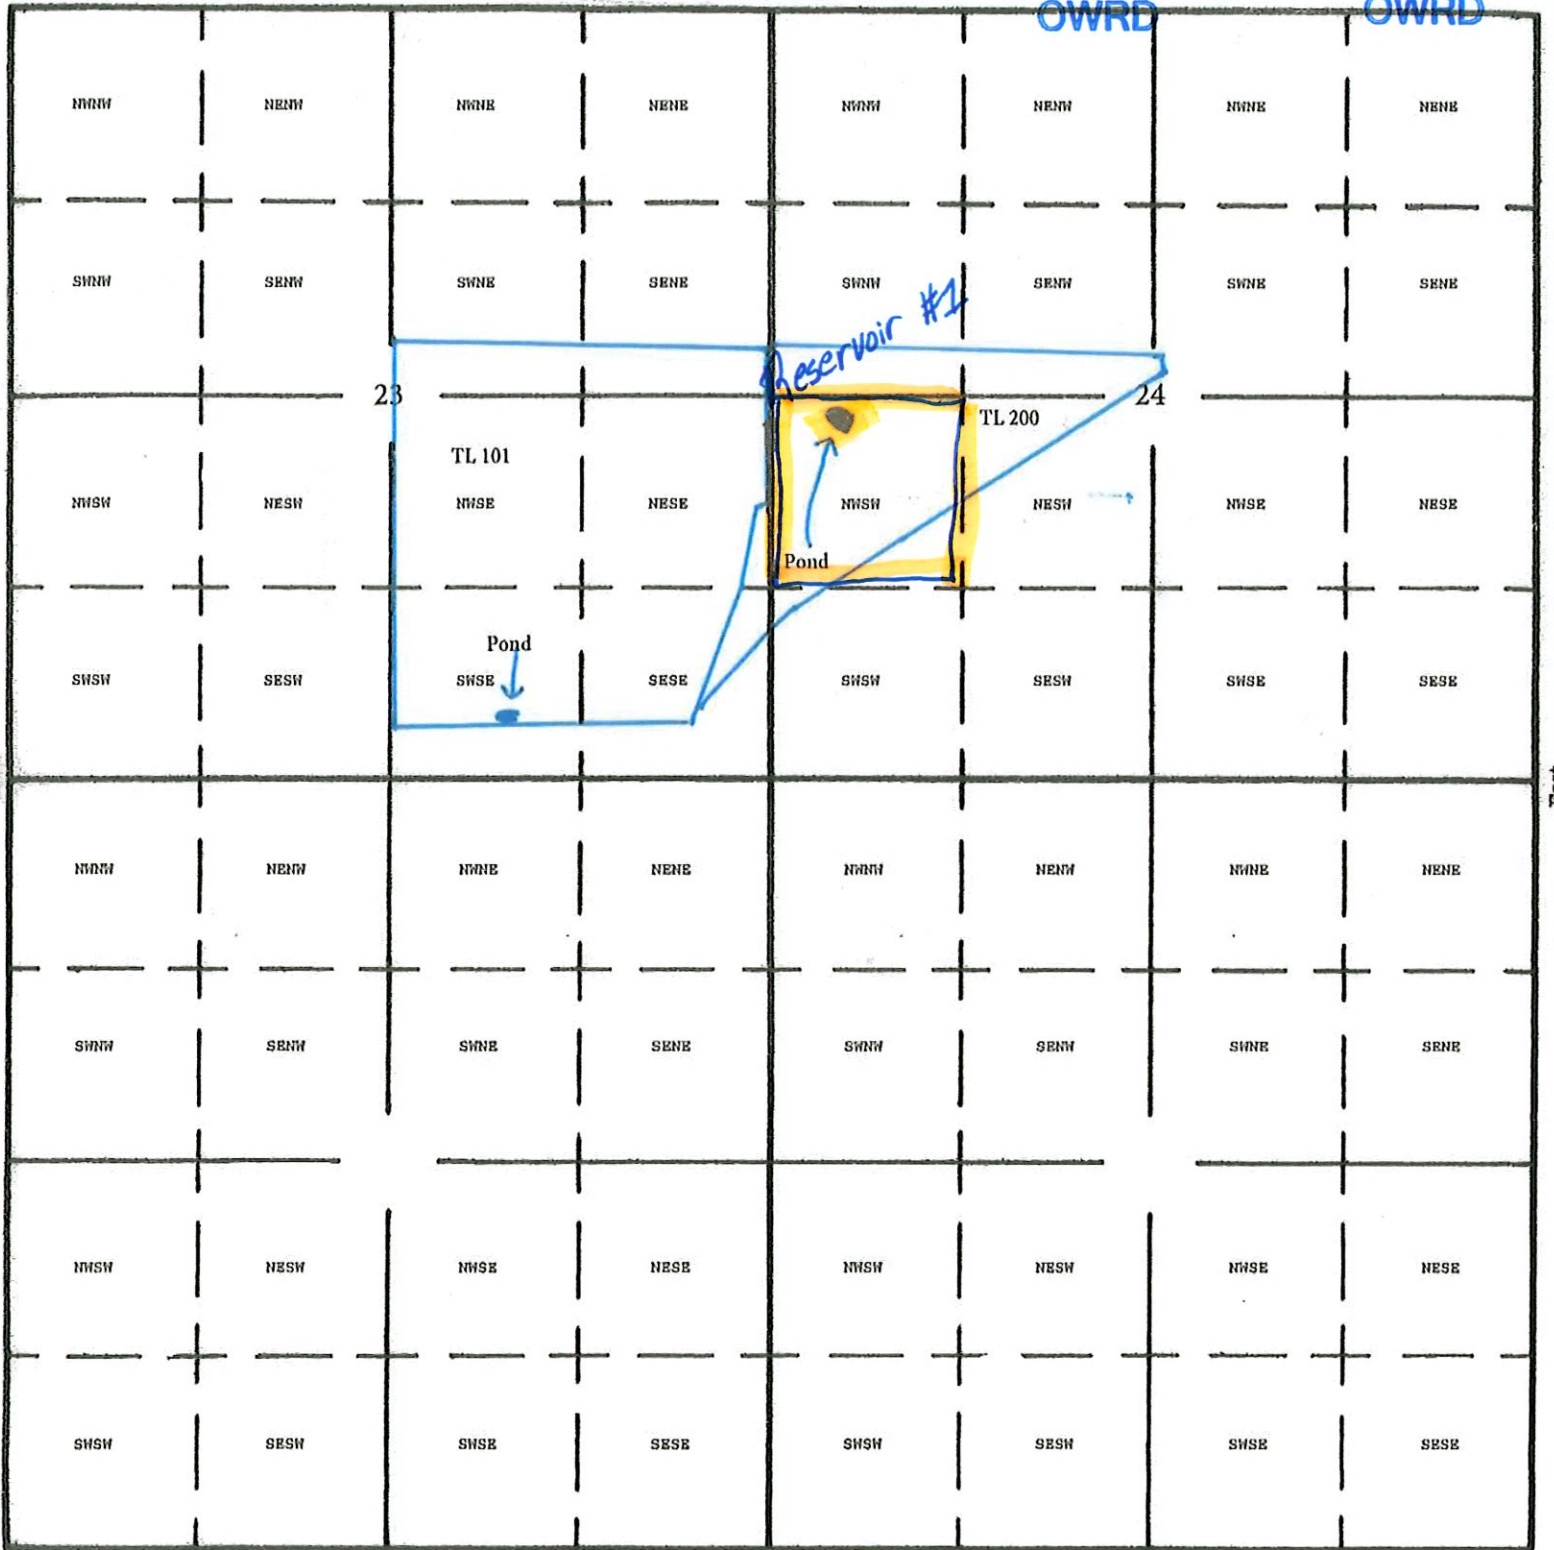

Dam: 405 North & 1725 West from SE Corner Section 23
Dam: 2,400 North & 525 East from SW Corner Section 24