

SECTION 02 T.41S. R.11E. W.M.  
KLAMATH COUNTY

41 11 02

THIS MAP WAS PREPARED FOR  
ASSESSMENT PURPOSE ONLY.

1"=400'


RECEIVED  
AUG 05 2021  
OWRD

NORTH

THIS R11E  
SEC 2  
Tax lots

200 = 20 Acres  
600 12 Acres  
700 11 Acres  
800 10 Acres

Scale 17  
1" = 880'

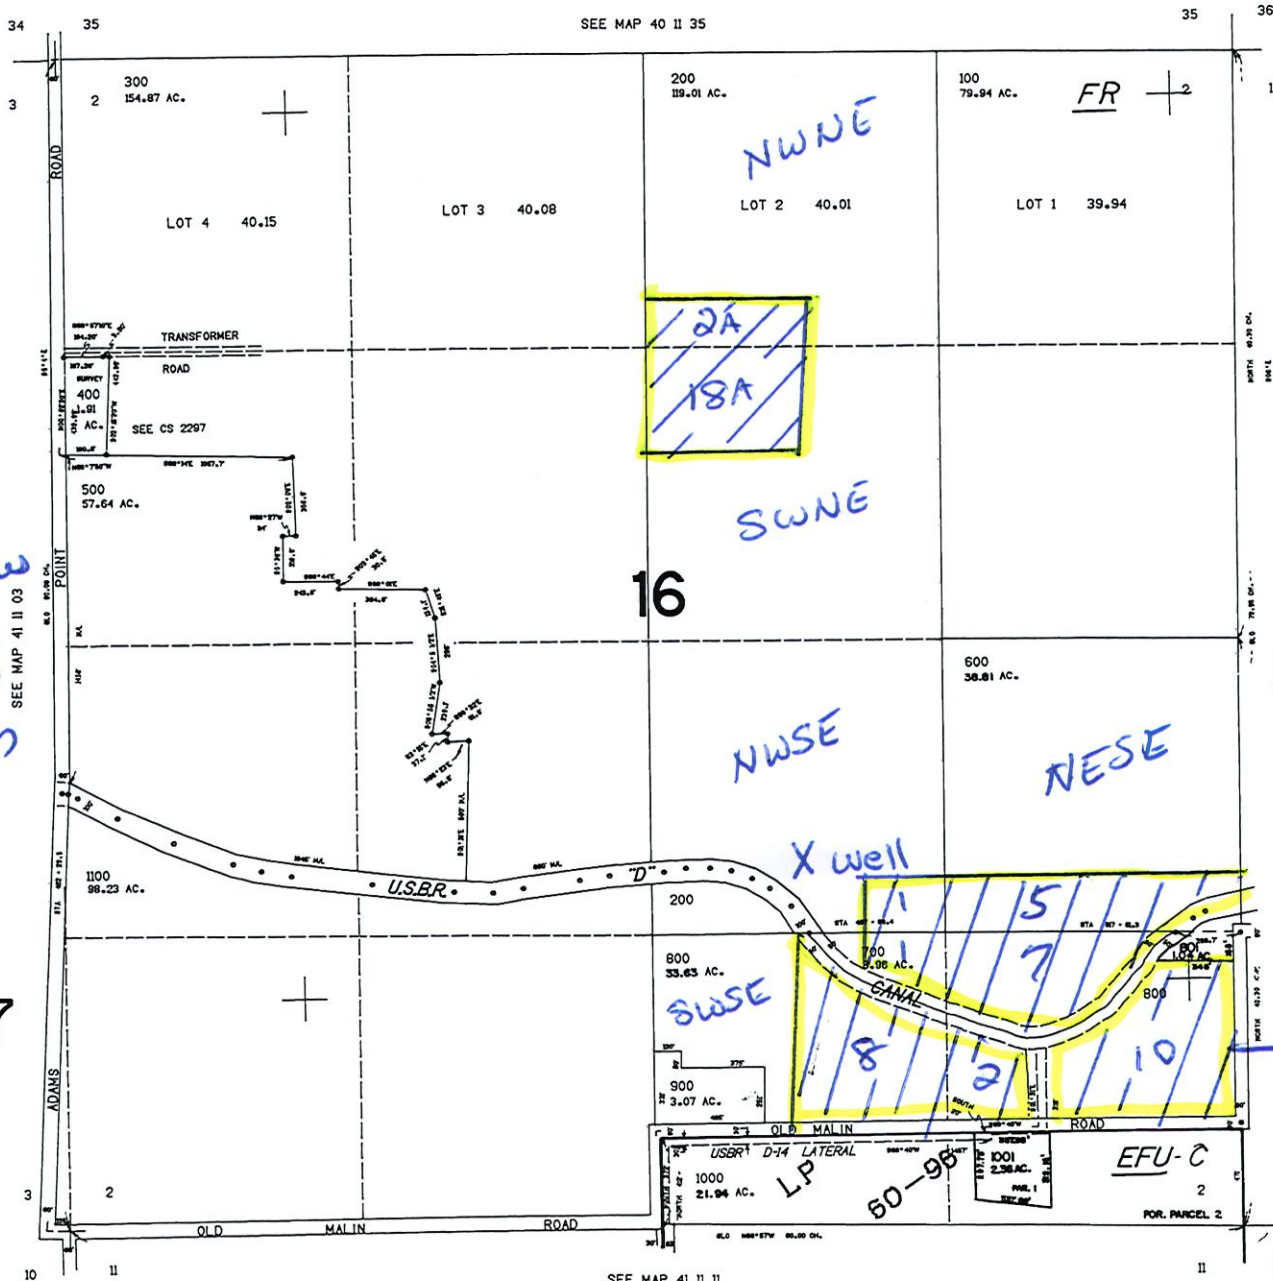

CANCELLED NOS  
601

Well location  
1500' North  
1800' West  
SE CORNER

SESE

133,000

1729,000

41 11 02