45.56214 9
45° 33' 43.74"

122.432831
122° 25' 58.19"

AL-1897

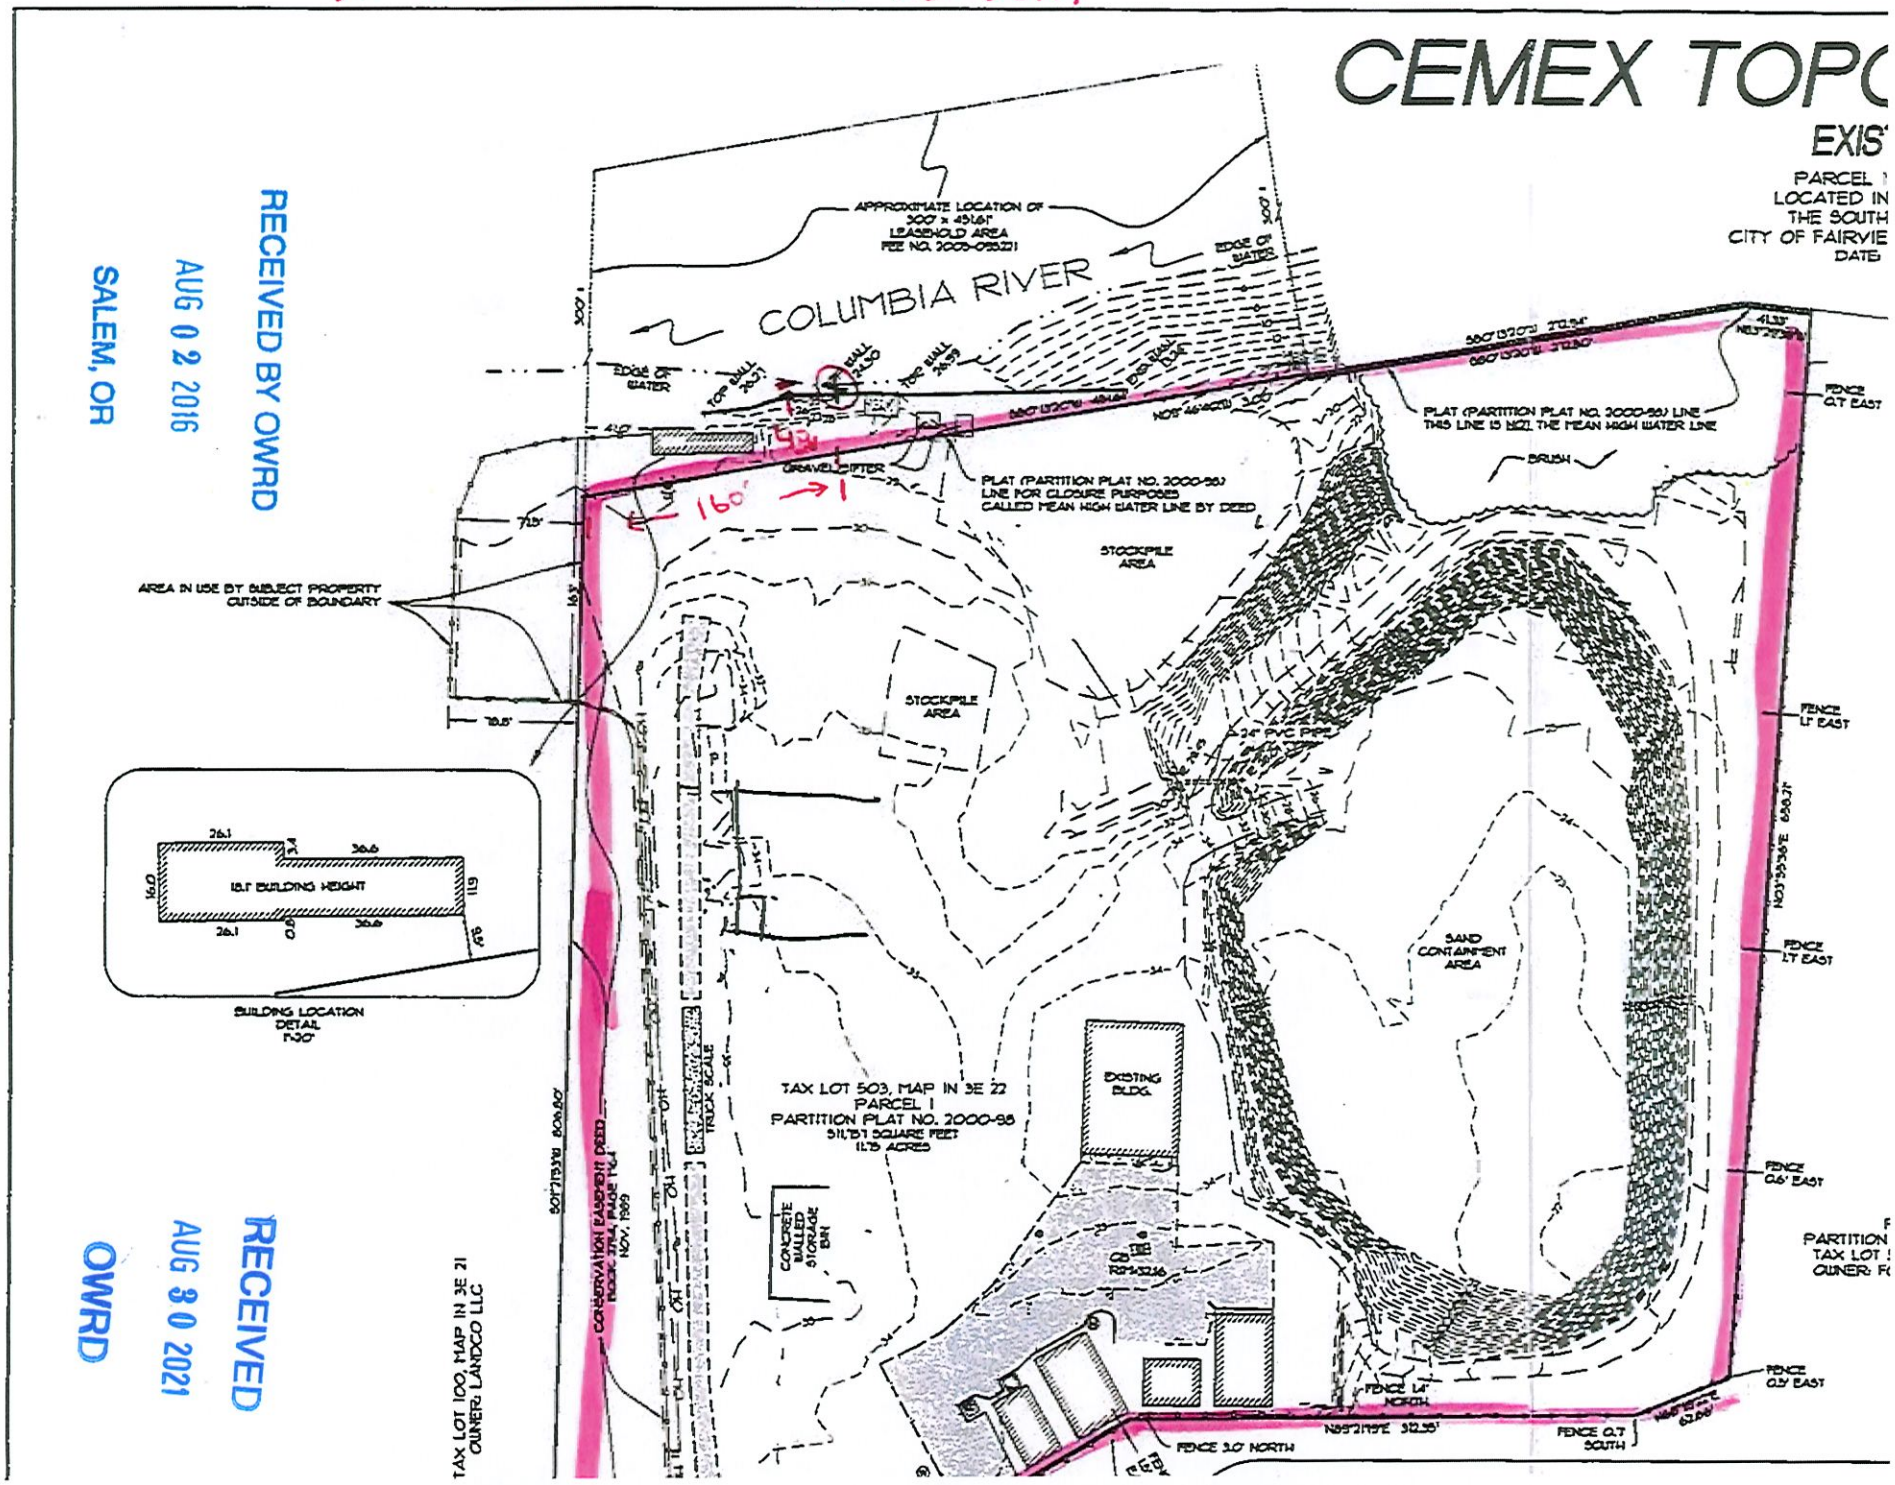

RECEIVED BY OWRD
AUG 02 2016
SALEM, OR

RECEIVED
AUG 30 2021
OWRD

RECEIVED
AUG 30 2021
OWRD

First American Title Insurance Company of Oregon

An assumed business name of TITLE INSURANCE COMPANY OF OREGON

This map is provided as a convenience in locating property
First American Title Insurance Company assumes no liability for any variations as may be disclosed by an actual survey

Reference Parcel Number 1N3E22 00503

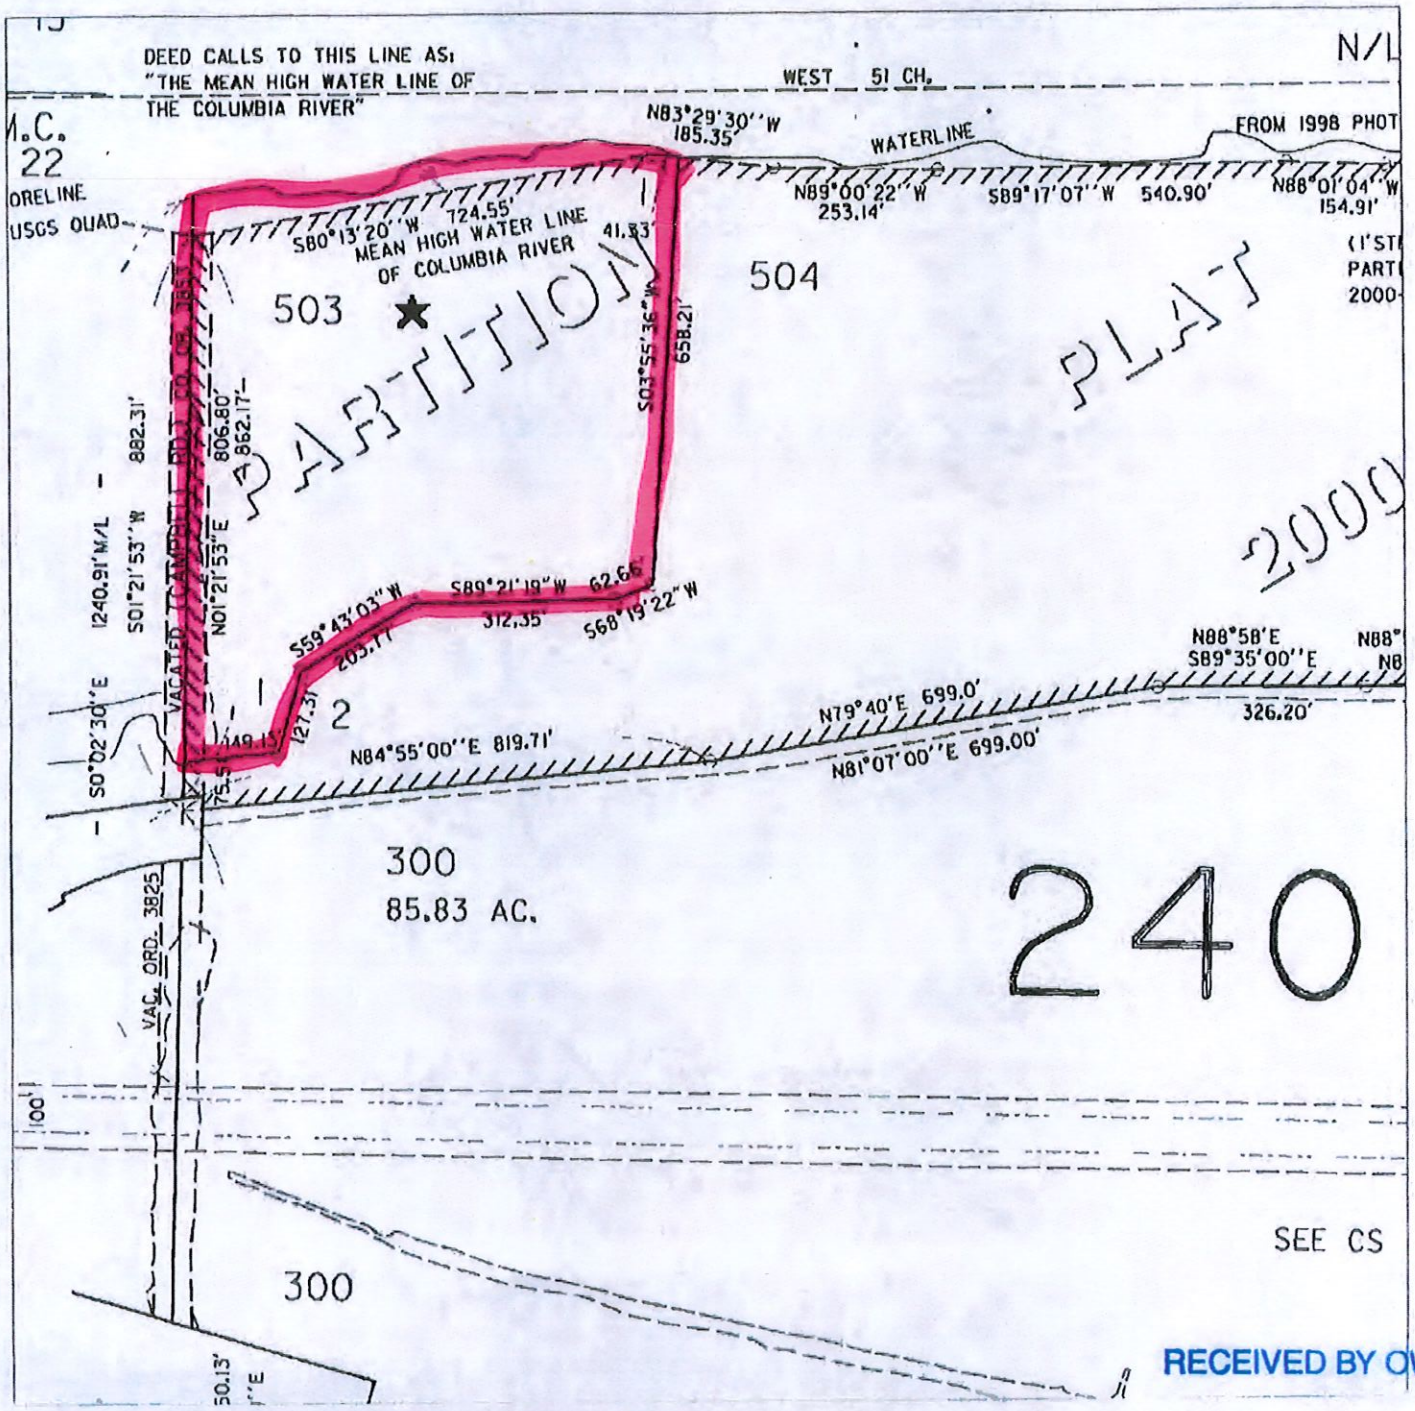

RECEIVED BY OWRD
AUG 02 2016
SALEM, OR

LL-1897