

Sections 31 & 32, T5S, R5W, W.M.,
Yamhill County, Oregon

RECEIVED

JUL 27 2021

OWRD

Transfer Application T-12250
Certificate 45563
CLAIM OF BENEFICIAL USE MAP
Christensen Farms

RECEIVED


AUG 20 2021

OWRD



EXPLANATION

TO LANDS

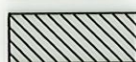

CERTIFICATE 45563 (26.5 A)
IRRIGATION
PRIORITY: 6/25/1971




POINT OF DIVERSION (POD)



PIPELINE (APPROX.)



SCALE

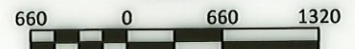

1 INCH = 1320 FEET

July 1, 2021

This map is not intended to provide legal
dimensions or locations of property
ownership lines

FIGURE 1



111 SW Fifth Ave., Suite 2400
Portland, OR 97204
O: 503.227.3251
F: 503.274.4681
www.kpff.com

Site inspection conducted
September 23, 2020