


RECEIVED

SECTION 23, T.2 S., R.2 W., W.M.

WASHINGTON COUNTY, OREGON

SEP 08 1999


WATER RESOURCES DEPT.
SALEM, OREGON

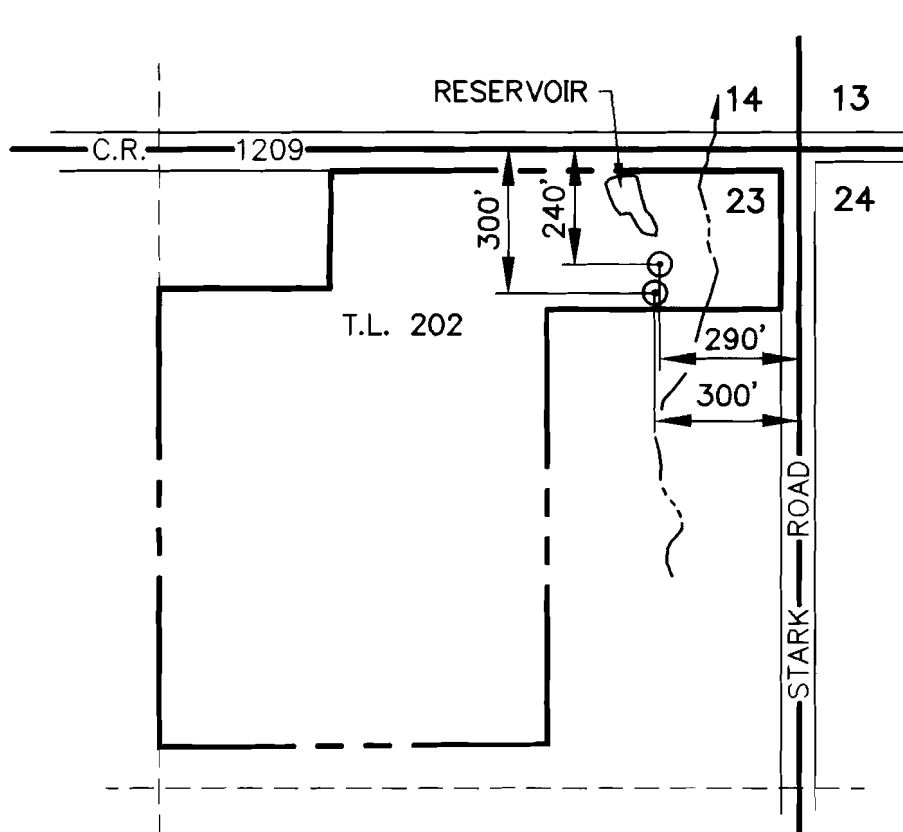

SCALE: 1"=400'

MAP BASE:
ASSESSORS MAP
DLUT PHOTO

PREPARATION OF THIS MAP IS FOR THE
PURPOSE OF IDENTIFYING THE LOCATION OF
THE WATER RIGHT ONLY. THERE IS NO INTENT
TO PROVIDE DIMENSIONS OR LOCATION OF
PROPERTY OWNERSHIP LINES.

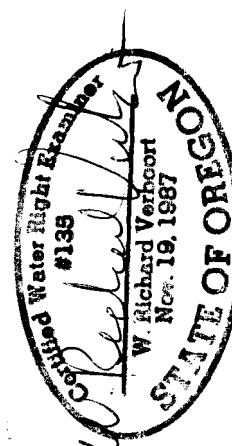

FINAL PROOF SURVEY

UNDER

APPLICATION R-73347 PERMIT R-11577

SURVEYED AUGUST 18, 1999

VERBOORT ENGINEERING

AGRICULTURE · CML · WATER RESOURCES
HILLSBORO, OREGON

by
designed WRV 8/20/99
drawn ER 8/20/99
checked WRV 8/20/99
drawing no. 99-A-10
sheet no. 1 / 1

RICHARD H. STARK

20880 S.W. SCHOLLS-SHERWOOD RD.
SHERWOOD, OR 97140