


FINAL PROOF SURVEY
IN THE NAME OF: HARLEY E. AND BETTY D. CISSNA
SECTION 9, T.2S., R.4E., W.M.

SCALE 1 inch = 400 FEET

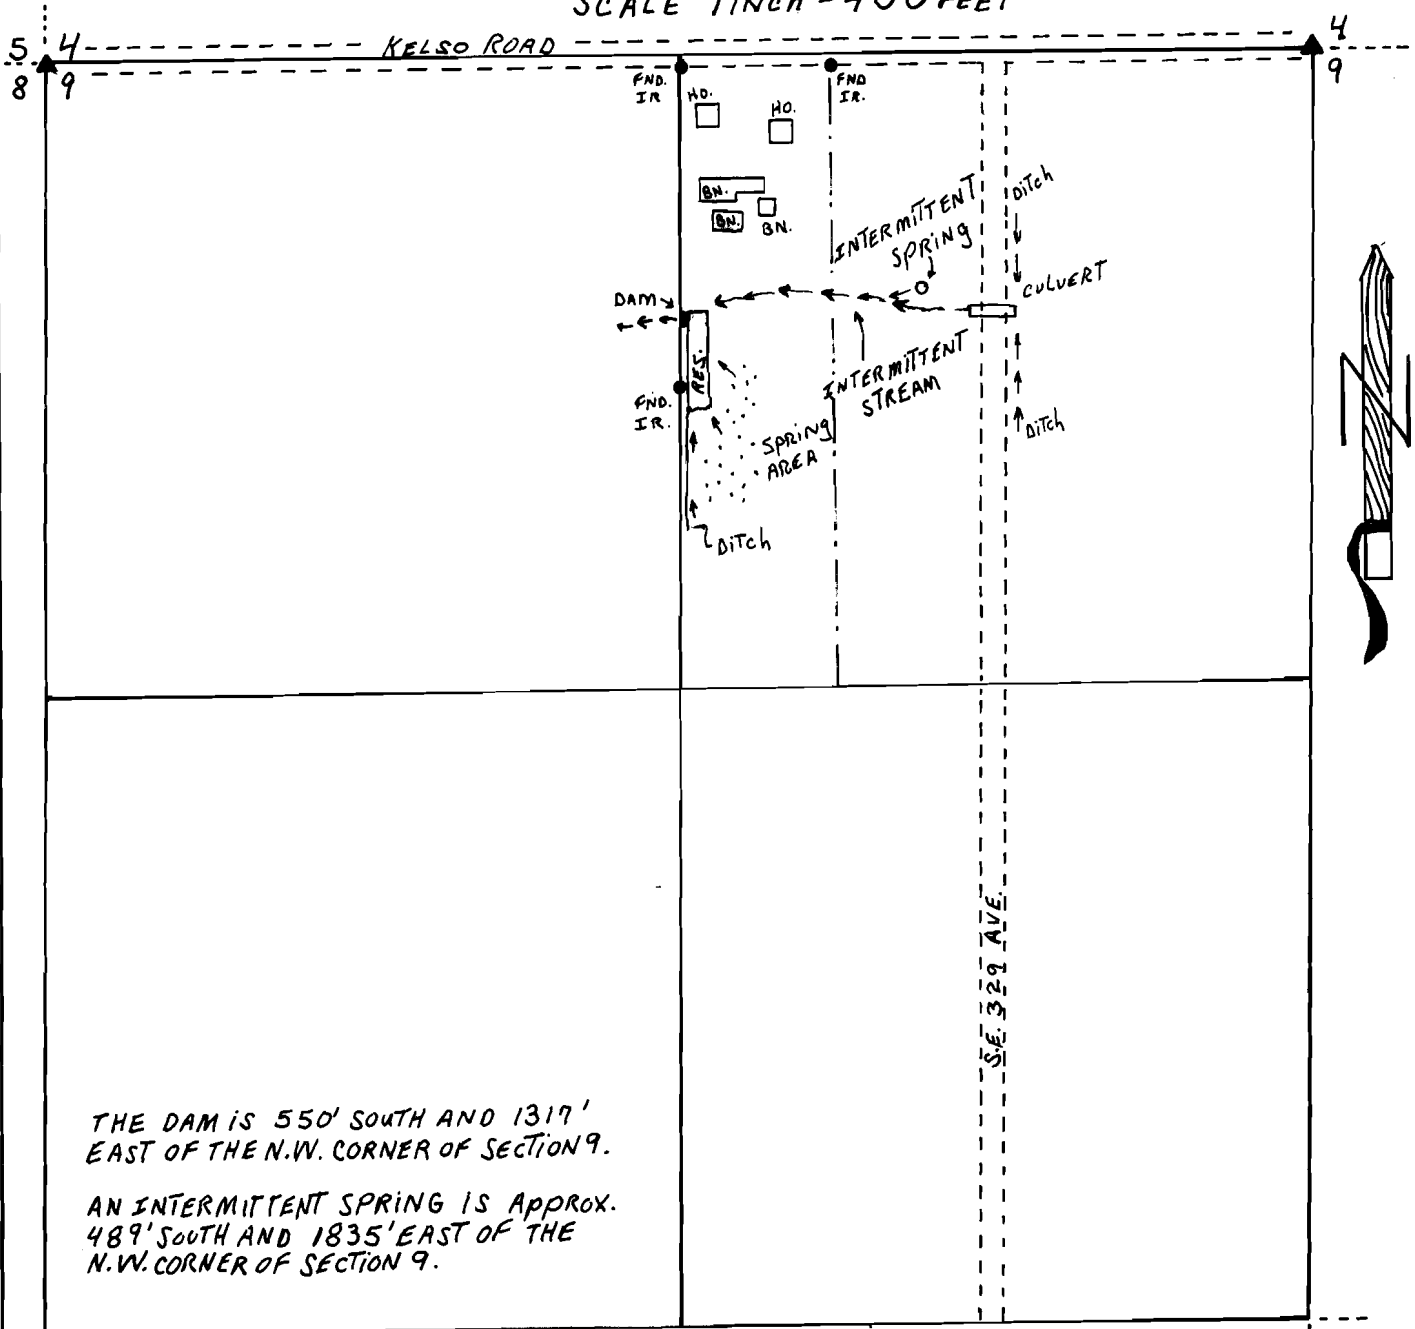

THE DAM IS 550' SOUTH AND 1317'
EAST OF THE N.W. CORNER OF SECTION 9.

AN INTERMITTENT SPRING IS APPROX.
489' SOUTH AND 1835' EAST OF THE
N.W. CORNER OF SECTION 9.

Basis of bearing P.S. #10612

SURVEYED MAY 17, 2004

APPLICATION # R73356

PERMIT # R11560

