


**T15S R6W, WM
BENTON COUNTY, OR**

- Well
- Intermittent Creek
-  POU NU
- Section
- DLC
- Quarter Quarter
-  Tax Lot

Well Locations:

Well #1 (BENT 56152 / L-135157):
1290' N, 540' W of SE Cor Sec 2


Well #2 (BENT 730 / L-120348):
850' N, 740' W of SE Cor Sec 2

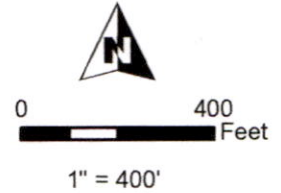

RECEIVED

SEP 13 2021

OWRD

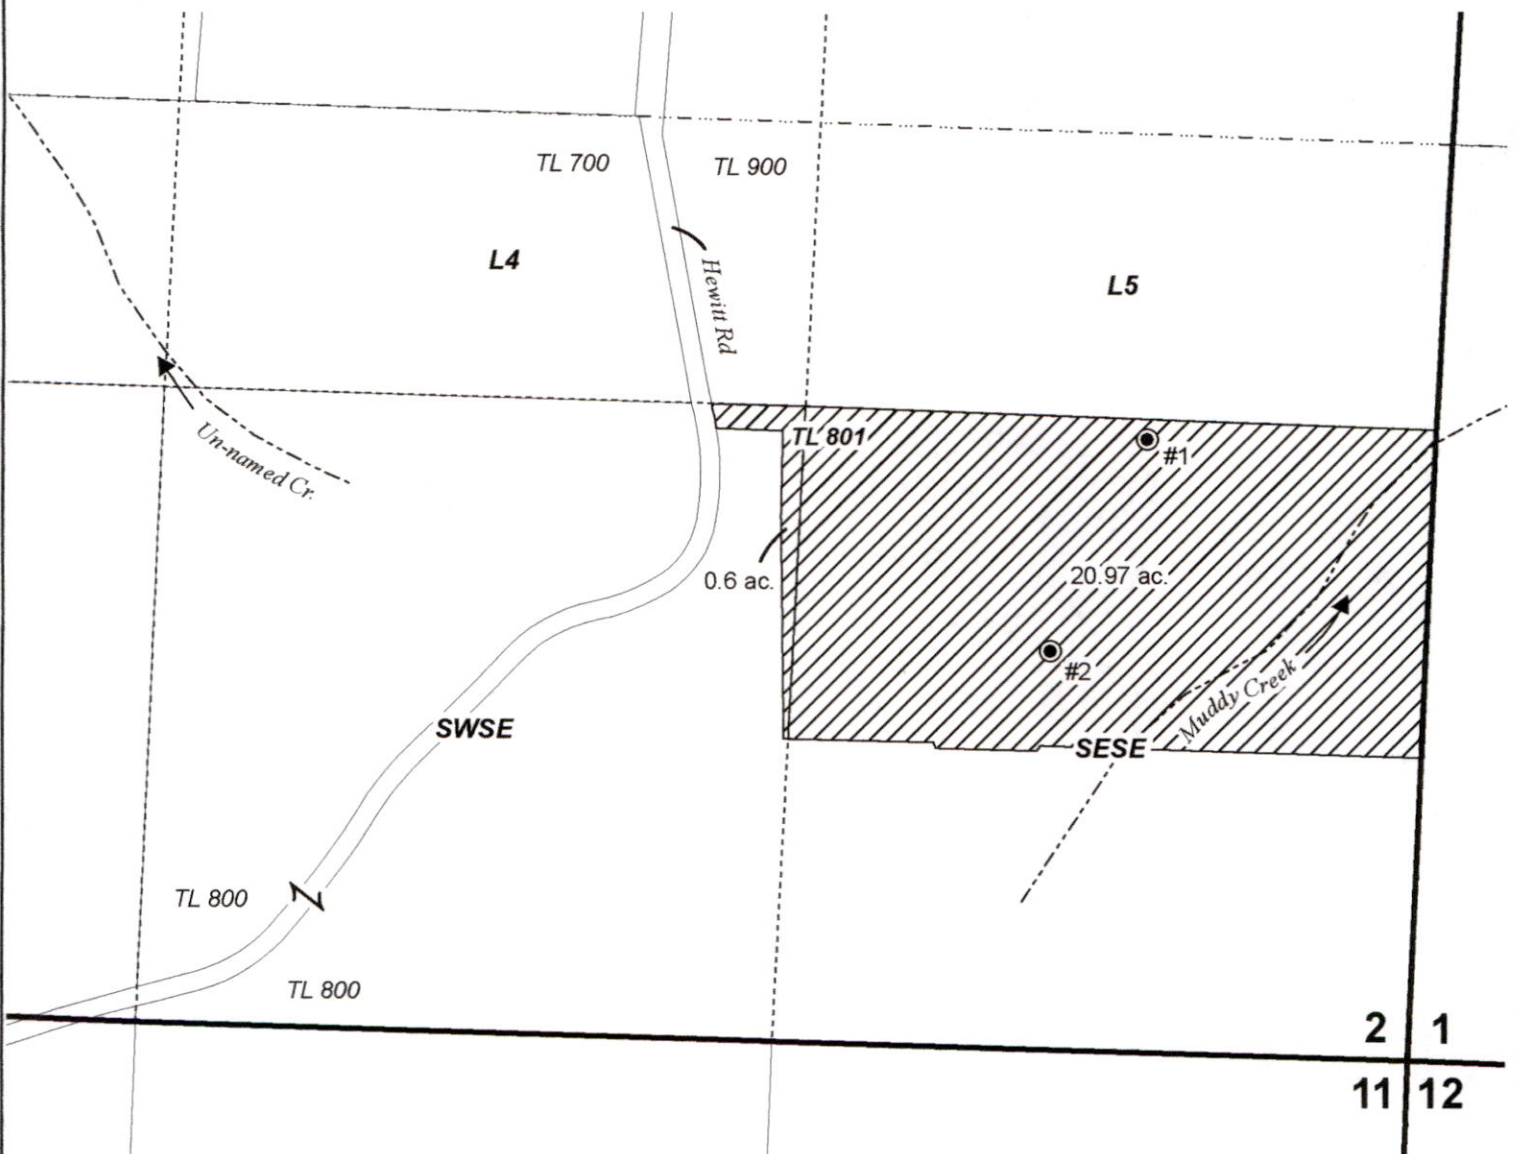

**GROUNDWATER APPLICATION MAP
A & J INVESTMENTS, LLC**

Date: 6/29/2021

This map is not intended
to provide legal dimensions
or locations of property
ownership lines.

WATER RIGHT SERVICES, LLC
PO BOX 1830, BEND, OR 97709
WWW.OREGONWATER.US CCB # 197121
johnshort@usa.com 541-389-2837

BENT 730



BENTON COUNTY ENVIRONMENTAL HEALTH ON-SITE SEWAGE DISPOSAL SYSTEM PLOT PLAN

Owner: Jared Dellinger & Andrew Felperin

Date: 03/11/16

Applicant: N/A


Assessor's Map and Tax Lot Numbers: 15-6-2 TL 801

Address: 24155 Hewett Road, Monroe, OR 97456

SITE #: -
PERMIT: -
TYPE: Property Line Adjustment

Parcel: 20.23 Acres

Scale: 1 inch = 200 feet

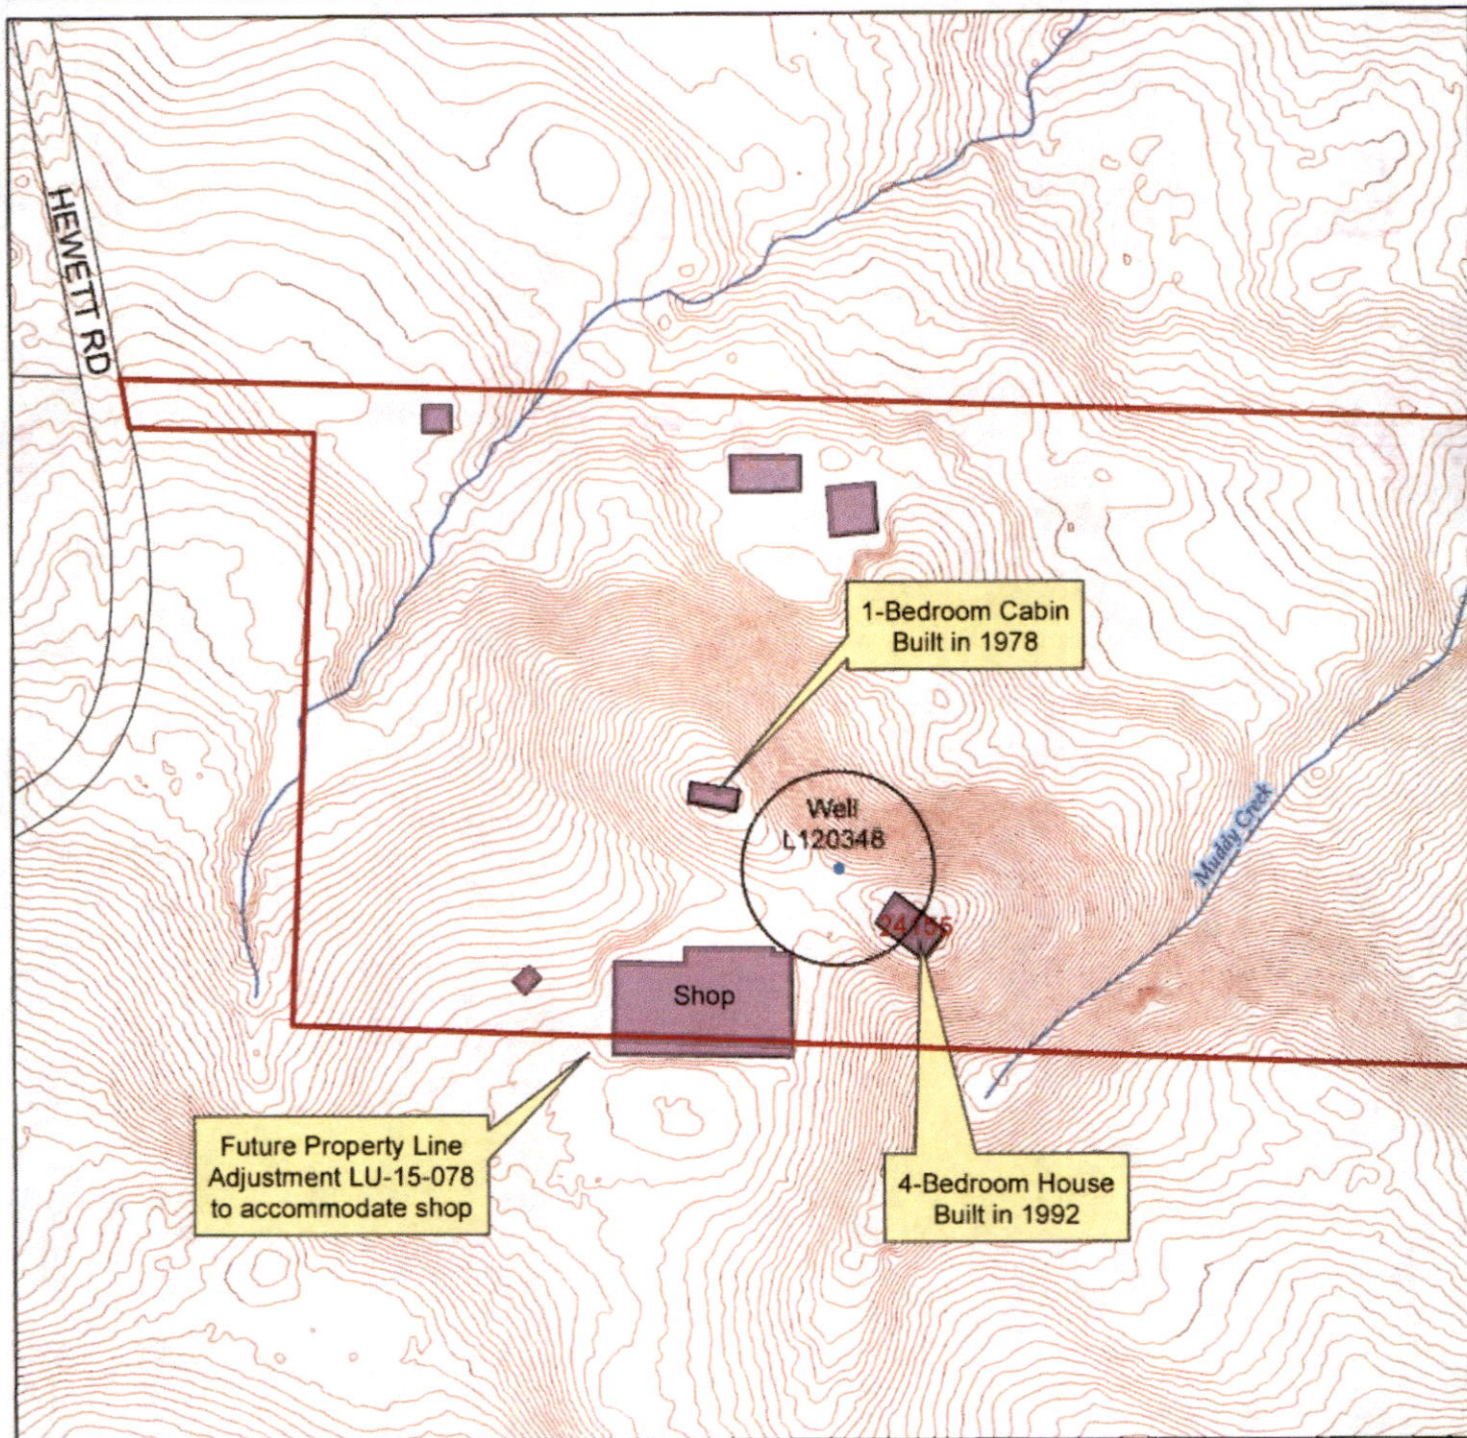

RECEIVED

MAR 11 2016

WATER RESOURCES DEPT
SALEM, OREGON

0 100 200 400
Feet

RECEIVED

SEP 13 2021

OWRD

