


Groundwater Application Red Hills Farm LLC


Township 4S, Range 3W, W.M.

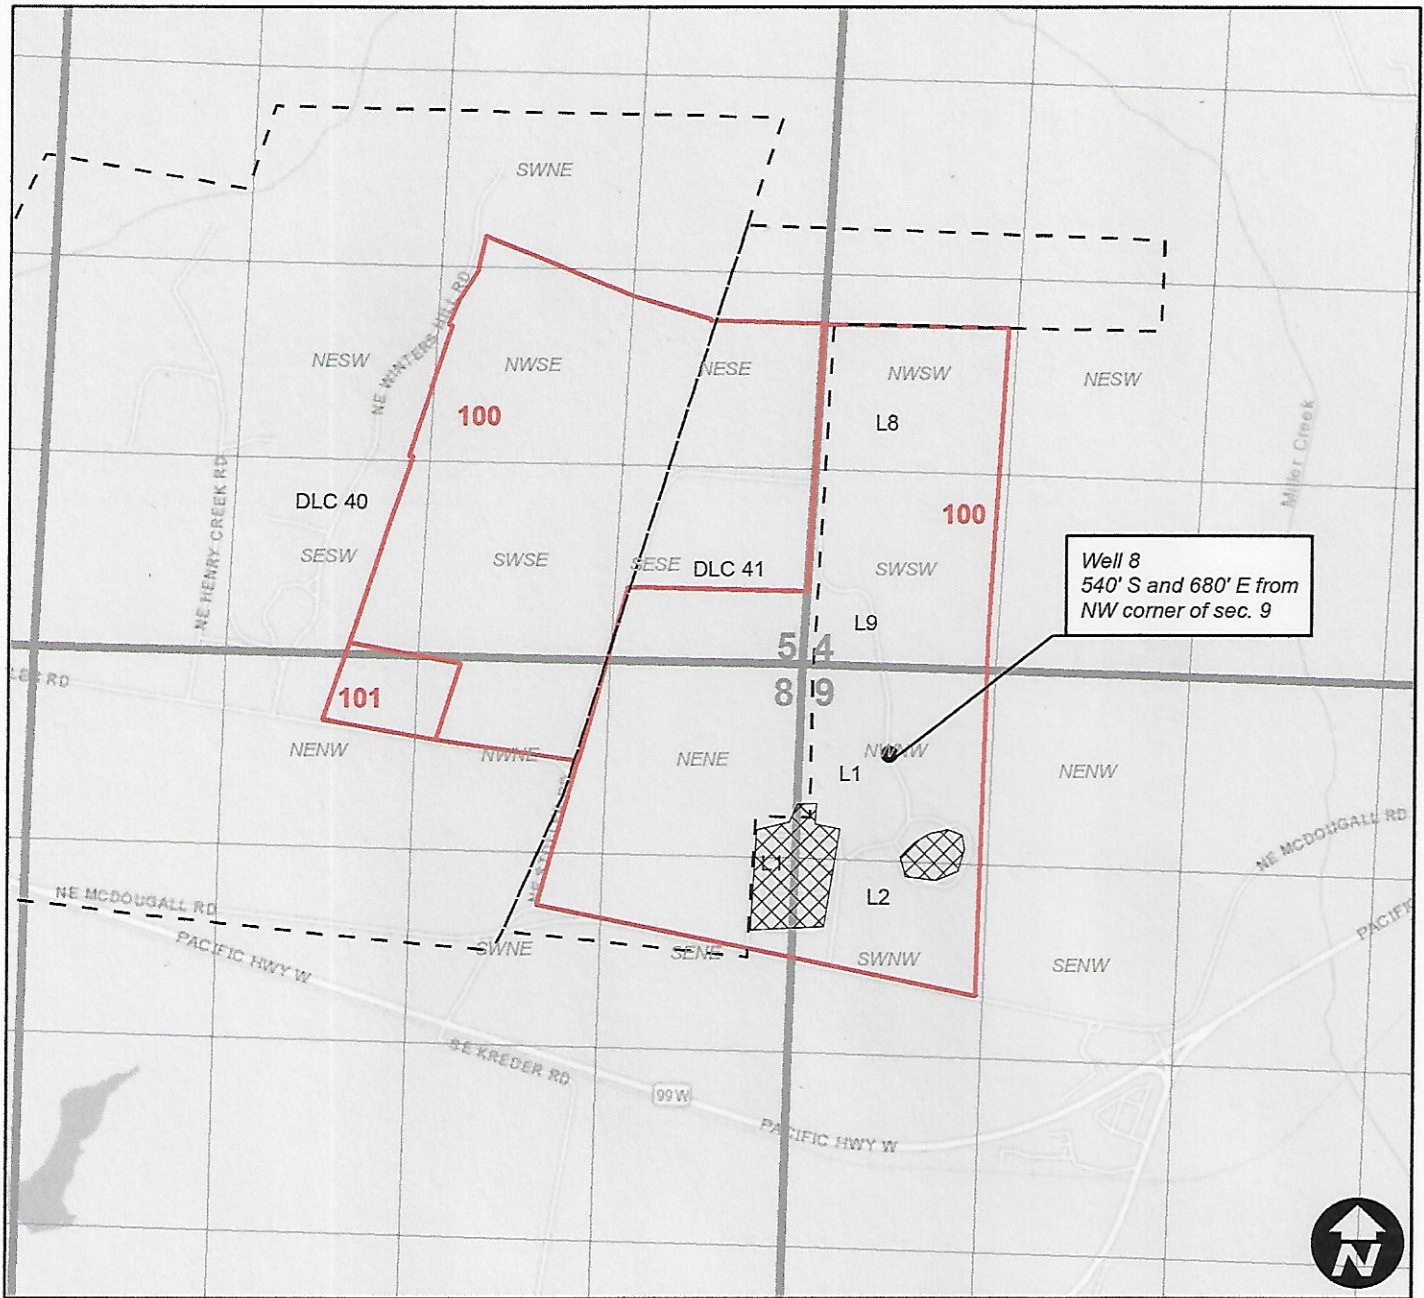

Well 8
540' S and 680' E from
NW corner of sec. 9

Legend

-  Industrial POU
-  Tax Lot
-  DLC

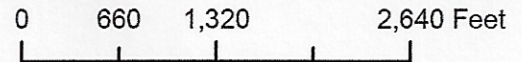

E-RECEIVED
July 28, 2021
OWRD