



Oregon Water Resources Department
 725 Summer Street NE, Suite A
 Salem, Oregon 97301
 (503) 986-0900
 www.oregon.gov/OWRD

Ownership Update for Certificated Rights Only

NO FEES ARE REQUIRED TO SUBMIT THIS FORM

NOTICE: A certificate of water right typically stays with the land. In order to track water right ownership, the Department requests that this form be submitted to the Department. To update multiple rights, a separate form is required for each right. If you have any questions about this form, please contact your local watermaster, or call the Water Resources Department at (503) 986-0900.

This form is not for Applications, Permits, Transfers, Groundwater Registrations, or Limited Licenses. To notify the Department of changes in ownership to these types of authorizations, an Assignment is required.

Current Landowner Information					
Name:	Lee H. and Marion B. Thompson Foundation				
Mailing Address:	P.O. Box 1488				
City:	Wilsonville	State:	OR	Zip:	97070
Phone:	c/o 503-694-5101	Email:	donriehards.law@gmail.com		

Property Information					
County:	Clackamas	Township:		Range:	
Tax Lot #:	Lot 1,2,3,4,5 Blueberry Meadow				
Street Address of Water Right:					

RECEIVED
JUN 17 2021

Water Right Information	
Application:	G-6880
Permit:	G-6412
Certificate:	Volume 42, page 48578

OWRD

Are all the lands associated with this water right owned by the requestor? Yes No
 (If no, include a map showing the portion of the water right involved)

Signature and Date	
Name of individual completing form:	Marc Hartman
Signature of requestor:	<i>Marc Hartman</i> Date: 6/14/2021
Phone or email:	mhartman@renaissance-homes.com

The Department does not change names on water right certificates. This form will be placed in the file for future reference only. If mailed, the Department will not provide acknowledgement of receipt.

This form can be mailed to the address above or sent via email to wrd_dl_customerservice@oregon.gov

STATE OF OREGON

COUNTY OF

CLACKAMAS

CERTIFICATE OF WATER RIGHT

This Is to Certify, That

LEE H. & MARION B. THOMPSON

of 24130 S.W. Graham Ferry Rd., Sherwood, State of Oregon, 97140, has made proof to the satisfaction of the Water Resources Director, of a right to the use of the waters of a well

a tributary of Willamette River for the purpose of irrigation of 8.9 acres

under Permit No. G-6412 and that said right to the use of said waters has been perfected in accordance with the laws of Oregon; that the priority of the right hereby confirmed dates from April 7, 1975

that the amount of water to which such right is entitled and hereby confirmed, for the purposes aforesaid, is limited to an amount actually beneficially used for said purposes, and shall not exceed 0.11 cubic foot per second

or its equivalent in case of rotation, measured at the point of diversion from the well. The well is located in the NE 1/4 SW 1/4, Section 10, T. 3 S., R. 1 W., W. M., 440 feet South and 560 feet West from the Center, Section 10

The amount of water used for irrigation, together with the amount secured under any other right existing for the same lands, shall be limited to one-eightieth of one cubic foot per second per acre, or its equivalent for each acre irrigated and shall be further limited to a diversion of not to exceed 2 1/2 acre feet per acre for each acre irrigated during the irrigation season of each year,

and shall conform to such reasonable rotation system as may be ordered by the proper state officer.

A description of the place of use under the right hereby confirmed, and to which such right is appurtenant, is as follows:

8.9 acres NE 1/4 SW 1/4
Section 10
T. 3 S., R. 1 W., W. M.

RECEIVED

JUN 17 2021

OWRD


The right to the use of the water for the purposes aforesaid is restricted to the lands or place of use herein described.

WITNESS the signature of the Water Resources Director, affixed

this date. October 5, 1979

James E. Seaman
Water Resources Director

T. 3 S., R. 1 W., W.M.

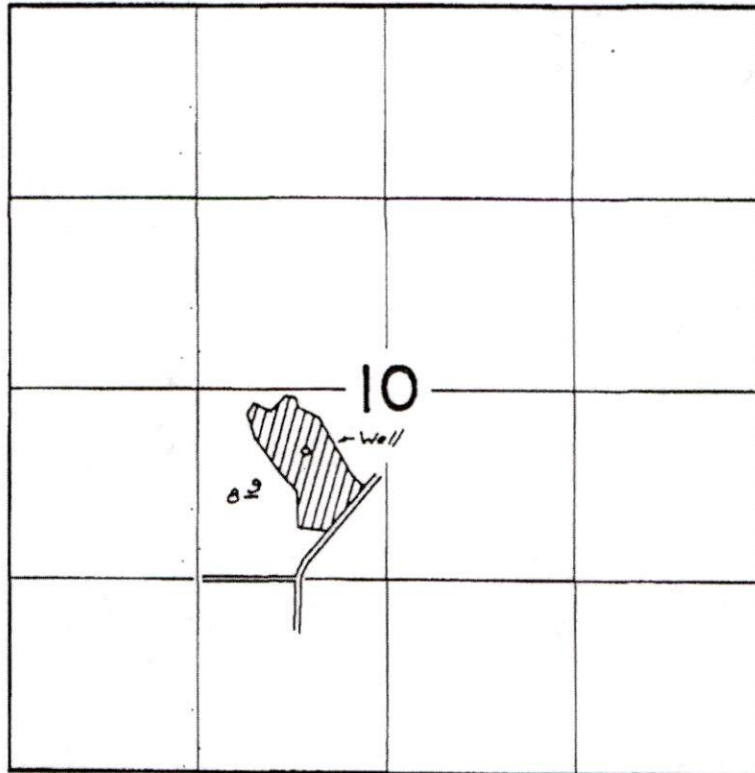

Well Loc.: 440 'S. & 560 'W. from Ctr. $\frac{1}{4}$ cor., Sec 10

RECEIVED

JUN 17 2021

OWRD

FINAL PROOF SURVEY
UNDER

Application No. G-6880 Permit No. G-6412
IN NAME OF

Lee & Marion Thompson

Surveyed Aug 2, 1977 by J.C. Brown

PTS-1977-L