

RECEIVED

SEP 16 2021



Oregon Water Resources Department
725 Summer Street NE, Suite A
Salem, Oregon 97301
(503) 986-0900
www.oregon.gov/OWRD

OWRD

Ownership Update
for Certificated Rights Only

NO FEES ARE REQUIRED TO SUBMIT THIS FORM

NOTICE: A certificate of water right typically stays with the land. In order to track water right ownership, the Department requests that this form be submitted to the Department. To update multiple rights, a separate form is required for each right. If you have any questions about this form, please contact your local watermaster, or call the Water Resources Department at (503) 986-0900.

This form is not for Applications, Permits, Transfers, Groundwater Registrations, or Limited Licenses. To notify the Department of changes in ownership to these types of authorizations, an Assignment is required.

Current Landowner Information
Name: Philip A Johnson
Mailing Address: 9566 W Wesley Ave
City: Lakewood State: CO Zip: 80227
Phone: 303-881-1260 Email: skilovlnd@yahoo.com

Property Information
County: Marion Township: 9 South Range: 2 East, W Section: 11 & 14
Tax Lot #: 092E11CC00700
Street Address of Water Right: 26107 Taylor Park Road Lyons, OR 97358

Water Right Information
Application: 17500
Permit: 13205
Certificate: 12466
Are all the lands associated with this water right owned by the requestor? [] Yes [x] No
(If no, include a map showing the portion of the water right involved)

Signature and Date
Name of individual completing form: Philip A Johnson
Signature of requestor: [Signature] Date: 09/12/2021
Phone or email: skilovlnd@yahoo.com 303-881-1260

The Department does not change names on water right certificates. This form will be placed in the file for future reference only. If mailed, the Department will not provide acknowledgement of receipt.

This form can be mailed to the address above or sent via email to wrd_dl_customerservice@oregon.gov

Search

Search: Water Right by File ▼

Application: ▼ 17500

Permit: ▼ 13205

Certificate: 12466

Claim: ▼

Transfer: ▼


POD Source: Equal ▼

Include Municipal:

(Draw box on map.)

Places of Diversion: (Count: 1)

Places of Use: (Count: 1)

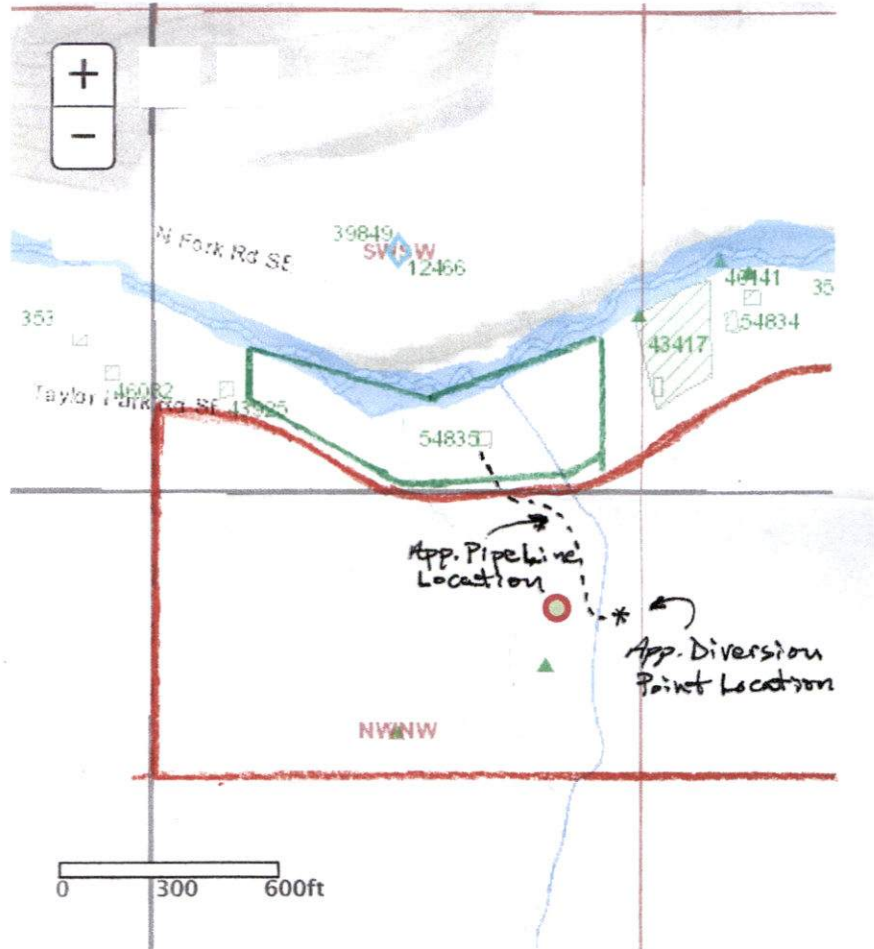

- Identify Non-Water Right Features
- Tax Lots
- Layers
- Tools

Tax Lot # 092E11C00700

Tax Lot # 092E14B00100

#	iD (select)	WRIS	Zoom	Water Right	Water Type	First Name	Last Name	Company
1	25308	(Details)	Map WR	Cert:12466 OR * DI	SW	A A	SCHRAMM	

Record ID: 25308

RECEIVED
SEP 16 2021
OWRD