

JUN 01 2021



Oregon Water Resources Department
 725 Summer Street NE, Suite A
 Salem, Oregon 97301
 (503) 986-0900
www.oregon.gov/OWRD

OWRD Ownership Update for Certificated Rights Only

NO FEES ARE REQUIRED TO SUBMIT THIS FORM

NOTICE: A certificate of water right typically stays with the land. In order to track water right ownership, the Department requests that this form be submitted to the Department. **To update multiple rights, a separate form is required for each right.** If you have any questions about this form, please contact your local watermaster, or call the Water Resources Department at (503) 986-0900.

This form is **not** for Applications, Permits, Transfers, Groundwater Registrations, or Limited Licenses. To notify the Department of changes in ownership to these types of authorizations, an Assignment is required.

Current Landowner Information					
Name:	Hudgens, Billie R Jr. & Penny M				
Mailing Address:	28362 Hunter Creek Hts				
City:	Gold Beach	State:	OR	Zip:	97444
Phone:	(541) 247-2815	Email:	hudg2@charter.net		

Property Information					
County:	Curry	Township:	37	Range:	14
				Section:	18A
Tax Lot #:	2310				
Street Address of Water Right:	28362 Hunter Creek Hts				
Water Right Information					
Application:	S 60715				
Permit:	45477				
Certificate:	56800				
Are all the lands associated with this water right owned by the requestor? ☐ Yes ☒ No					
(If no, include a map showing the portion of the water right involved)					

Signature and Date			
Name of individual completing form:	Penny M. Hudgens		
Signature of requestor:		Date:	5/28/21
Phone or email:	(541) 247-2815 or hudg2@charter.net		

The Department does not change names on water right certificates. This form will be placed in the file for future reference only. If mailed, the Department will not provide acknowledgement of receipt.


This form can be mailed to the address above or sent via email to wrd_dl_customerservice@oregon.gov

RECEIVED

JUN 01 2021

OWRD

T. 37S., R. 14 W., W.M.

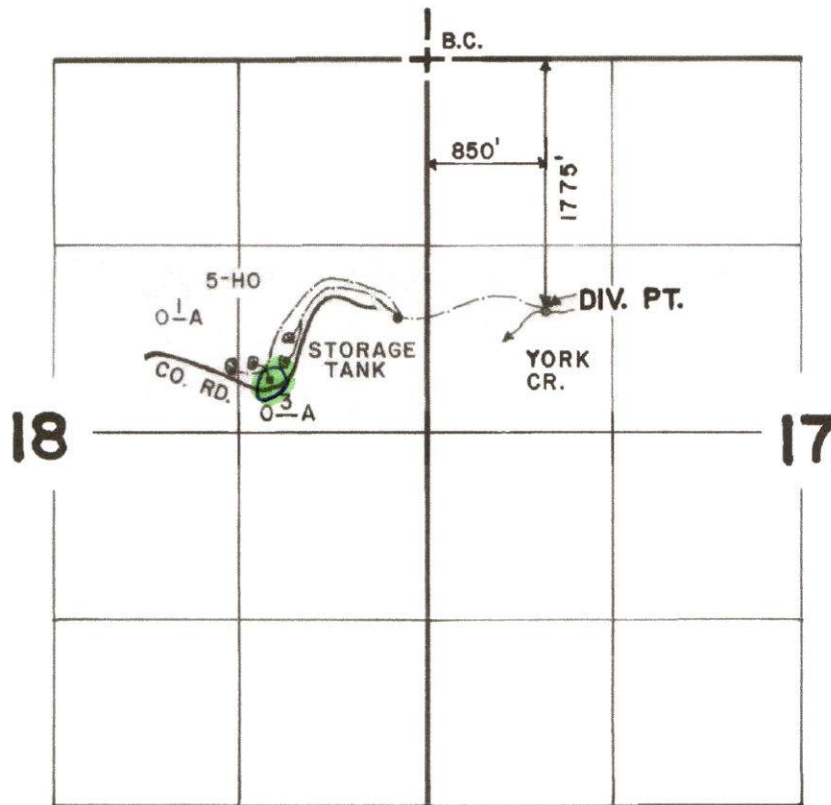

SCALE: 4" = 1 MILE

FINAL PROOF SURVEY

UNDER

Application No. 60715 Permit No. 45477
IN NAME OF

JAMES A. CHRISTENSEN

Surveyed SEPT. 24 1985, by J.M. SCHMORDE