

REVISED 01-03-14

THIS MAP WAS PREPARED FOR ASSESSMENT PURPOSE ONLY

SECTION 28 T.40S. R.10E. W.M. KLAMATH COUNTY

1"=400'

MAP 1 OF 4


MAP CREATED 5/13/2021

RECEIVED

SEP 30 2021

OWRD

NORTH T40S R10E SEC 28

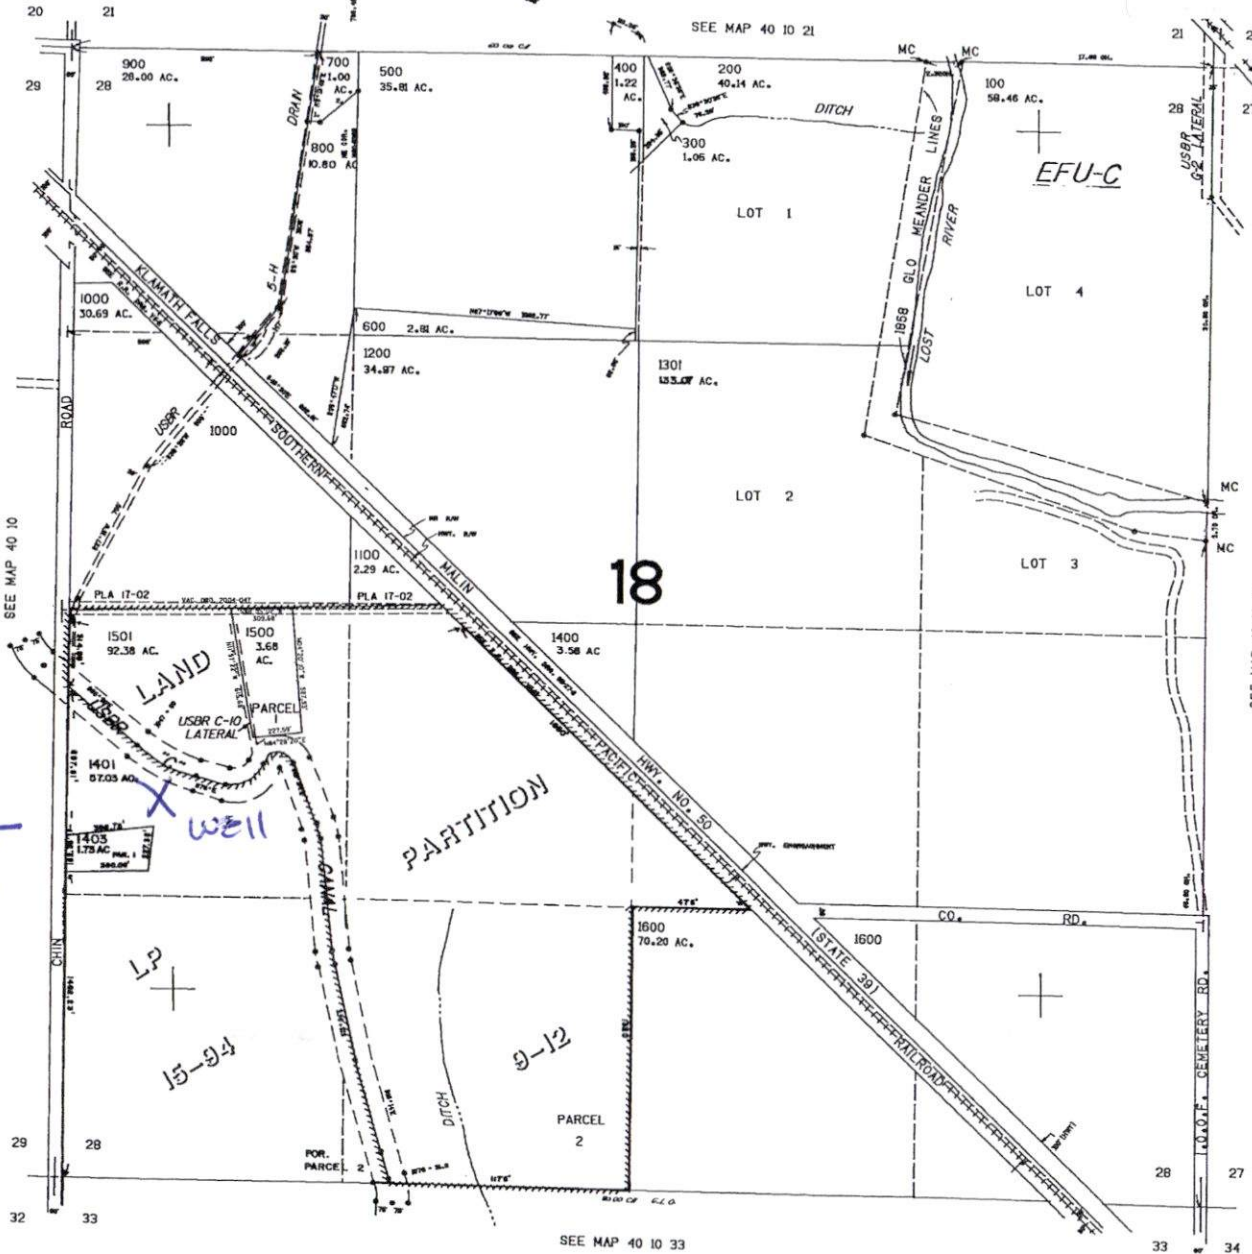

PARCEL 700 & 700M
 CANCELLED NO. 1300
 1402
 900 MI

RECEIVED

SEP 07 2021

OWRD

RECEIVED

AUG 11 2021

OWRD

Proposed Well

440' EAST OF
880' South of
W 1/4 of Sec 28

Scale

1"=880'

16896.000

REVISED 01-03-14

THIS MAP WAS PREPARED FOR ASSESSMENT PURPOSE ONLY

SECTION 28 T.40S. R.10E. W.M. KLAMATH COUNTY

1"=400'

MAP 2 OF 4

MAP CREATED 05/03/2001

RECEIVED

AUG 11 2021

OWRD

NORTH

T40S R10E

SEC 28

Tax lot

1000 SWNW 30.69

1100 SENW 2.29

1401 NWSE 3.00

BWSW 35.00

NWSW 22.03

1501 NWSW 19.38

NESW 36.00


SESW 37.00

RECEIVED

SEP 30 2021

OWRD

Scale 1"=880'

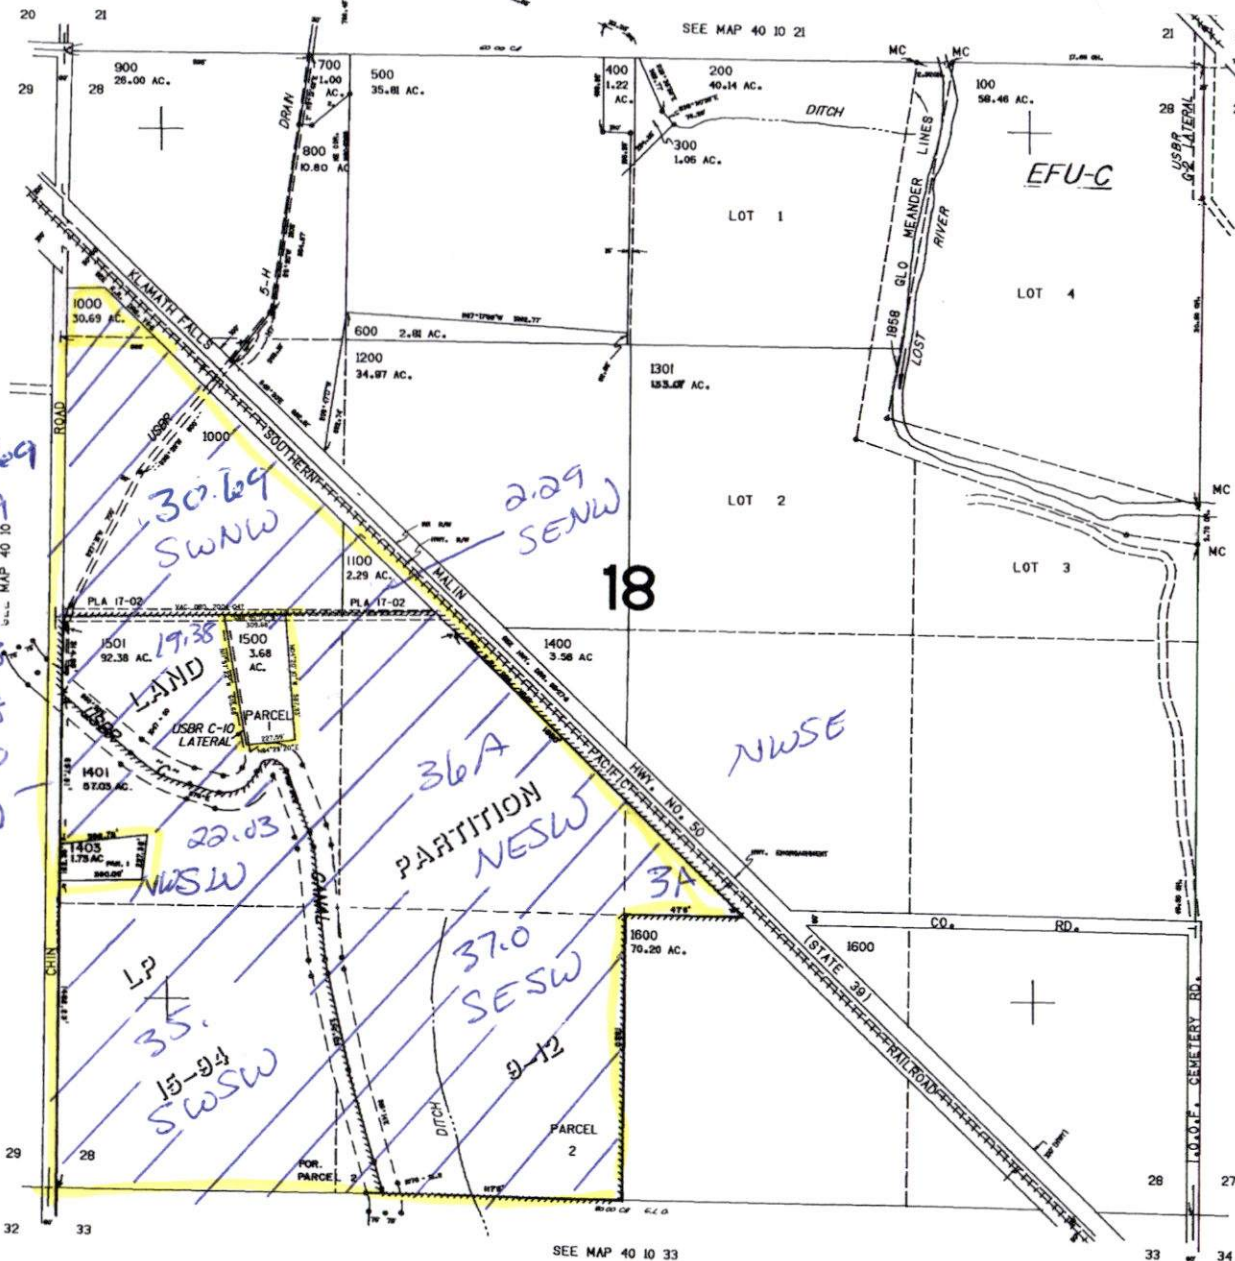

RECEIVED

SEP 07 2021

OWRD

SEE MAP 40 10 27

SEE MAP 40 10 33

40 10 28

THIS MAP WAS PREPARED FOR
ASSESSMENT PURPOSE ONLY

SECTION 29 T.40S. R.10E. W.M.
KLAMATH COUNTY

1"=400'

MAP 3 OF 4

MAP CREATED 05/03/2021

RECEIVED

AUG 11 2021

OWRD

NORTH

T40S R10E

Sec 29

Tax 703

NESW 3.00

NWSE 40.00

NESE 38.00

RECEIVED


SEP 30 2021

OWRD

RECEIVED

SEP 07 2021

OWRD

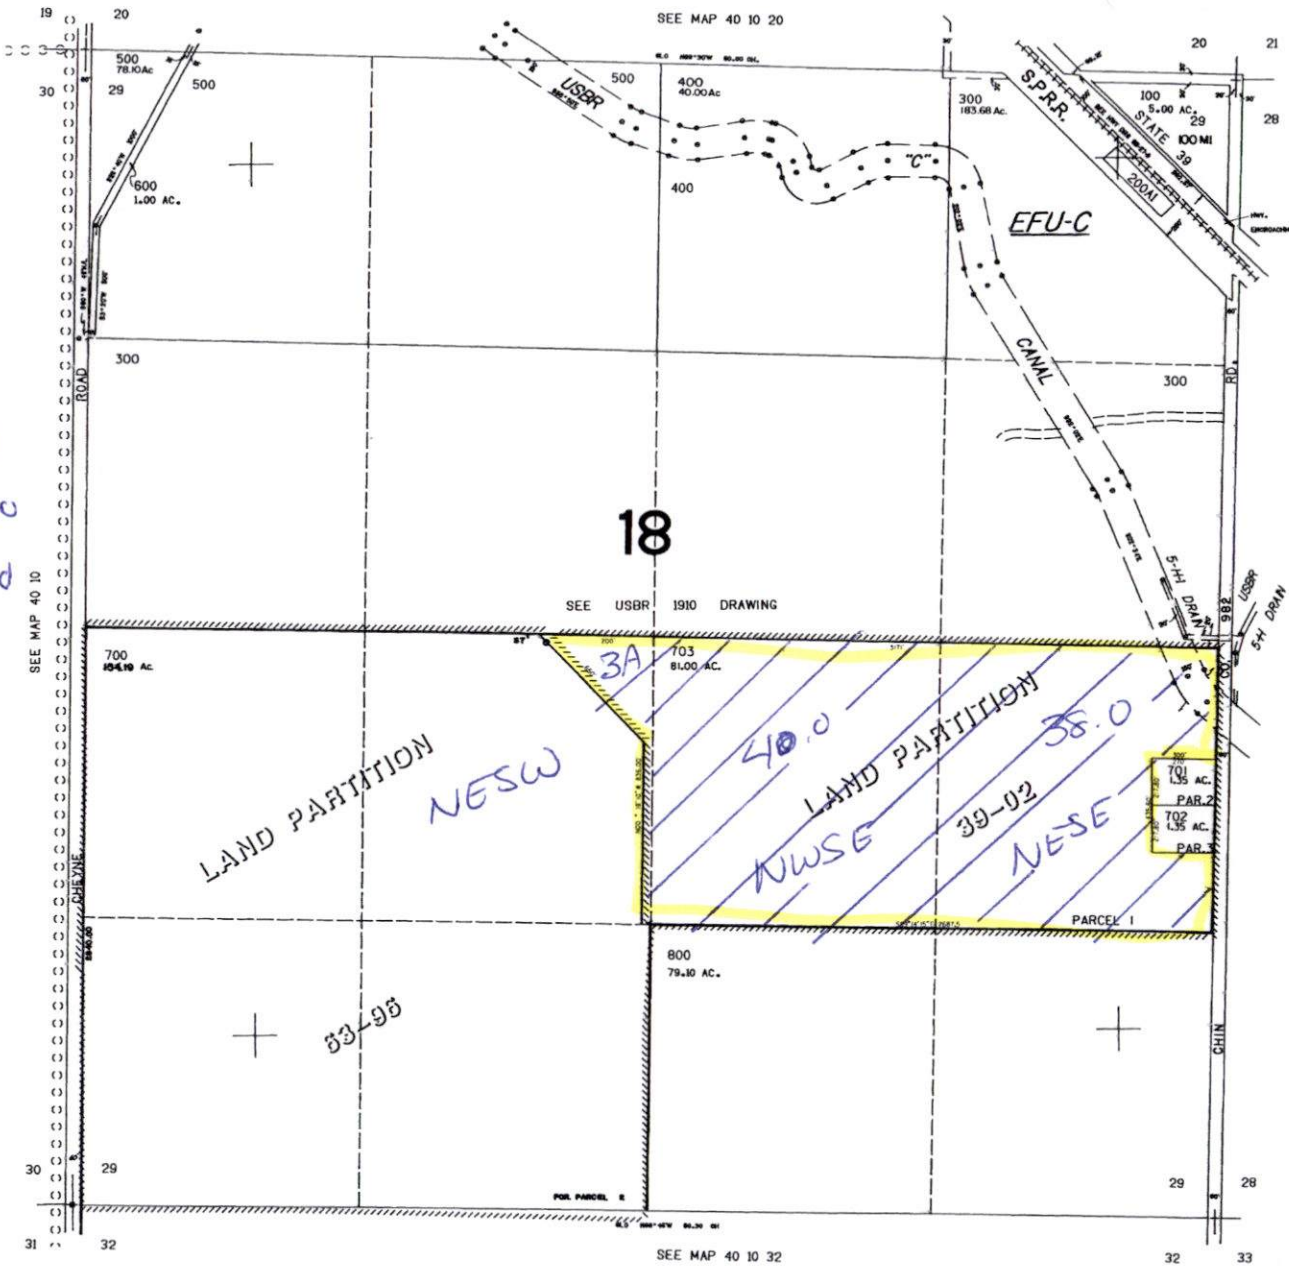

Scale
1" = 400'

18B1000

REVISED 04-25-15
THIS MAP WAS PREPARED FOR
ASSESSMENT PURPOSE ONLY

SECTION 33 T.40S. R.10E. W.M.
KLAMATH COUNTY

T-400'

MAP 4 OF 4

MAP CREATED 5/03/2021

RECEIVED

AUG 11 2021


OWRD

NORTH
T40S R10E
SEC 33
Tax Lot
300 NENW
37.9
SESW 30.A

400
NNNW 37.67
SWNW 39.0
RECEIVED
SEP 30 2021

OWRD

Scale
1" = 880'

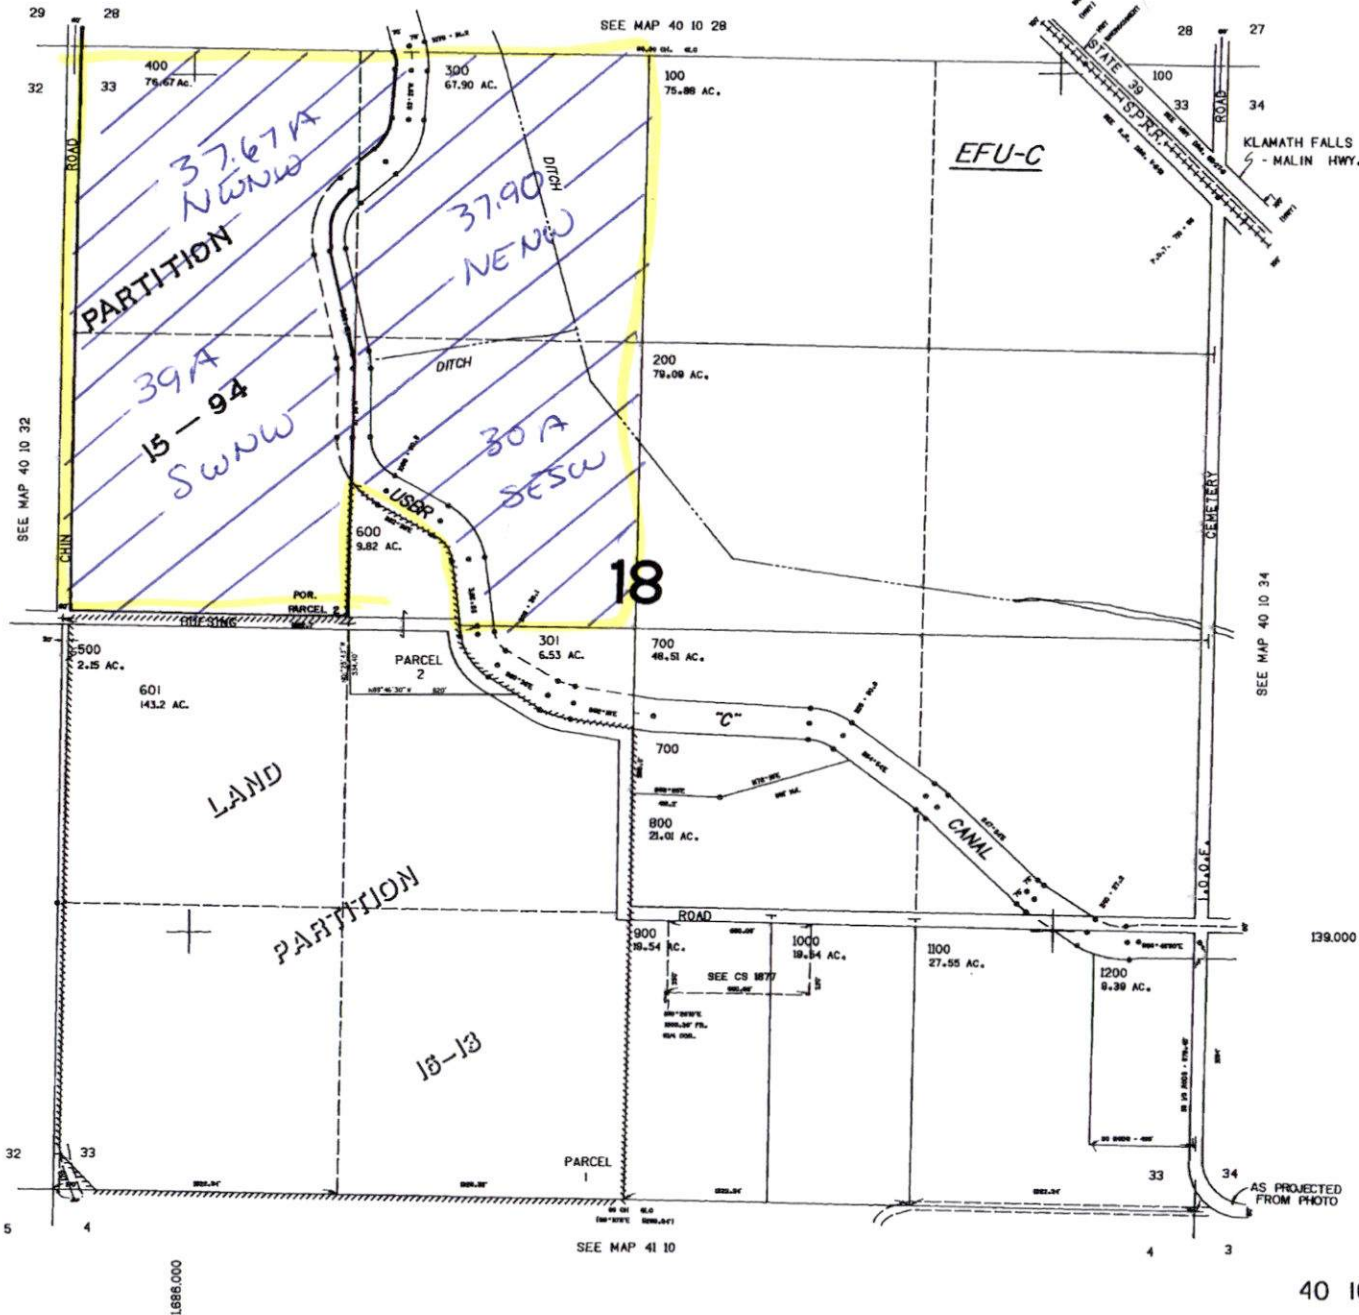

RECEIVED

SEP 07 2021

OWRD

40 10 33