

RECEIVED

OCT 21 2021


OWRD

THIS MAP WAS PREPARED FOR ASSESSMENT PURPOSE ONLY

0 100 200 400 Feet

SECTION 3 T.7N. R.4W. W.M.
COLUMBIA COUNTY
1" = 400'

07 04 03 00

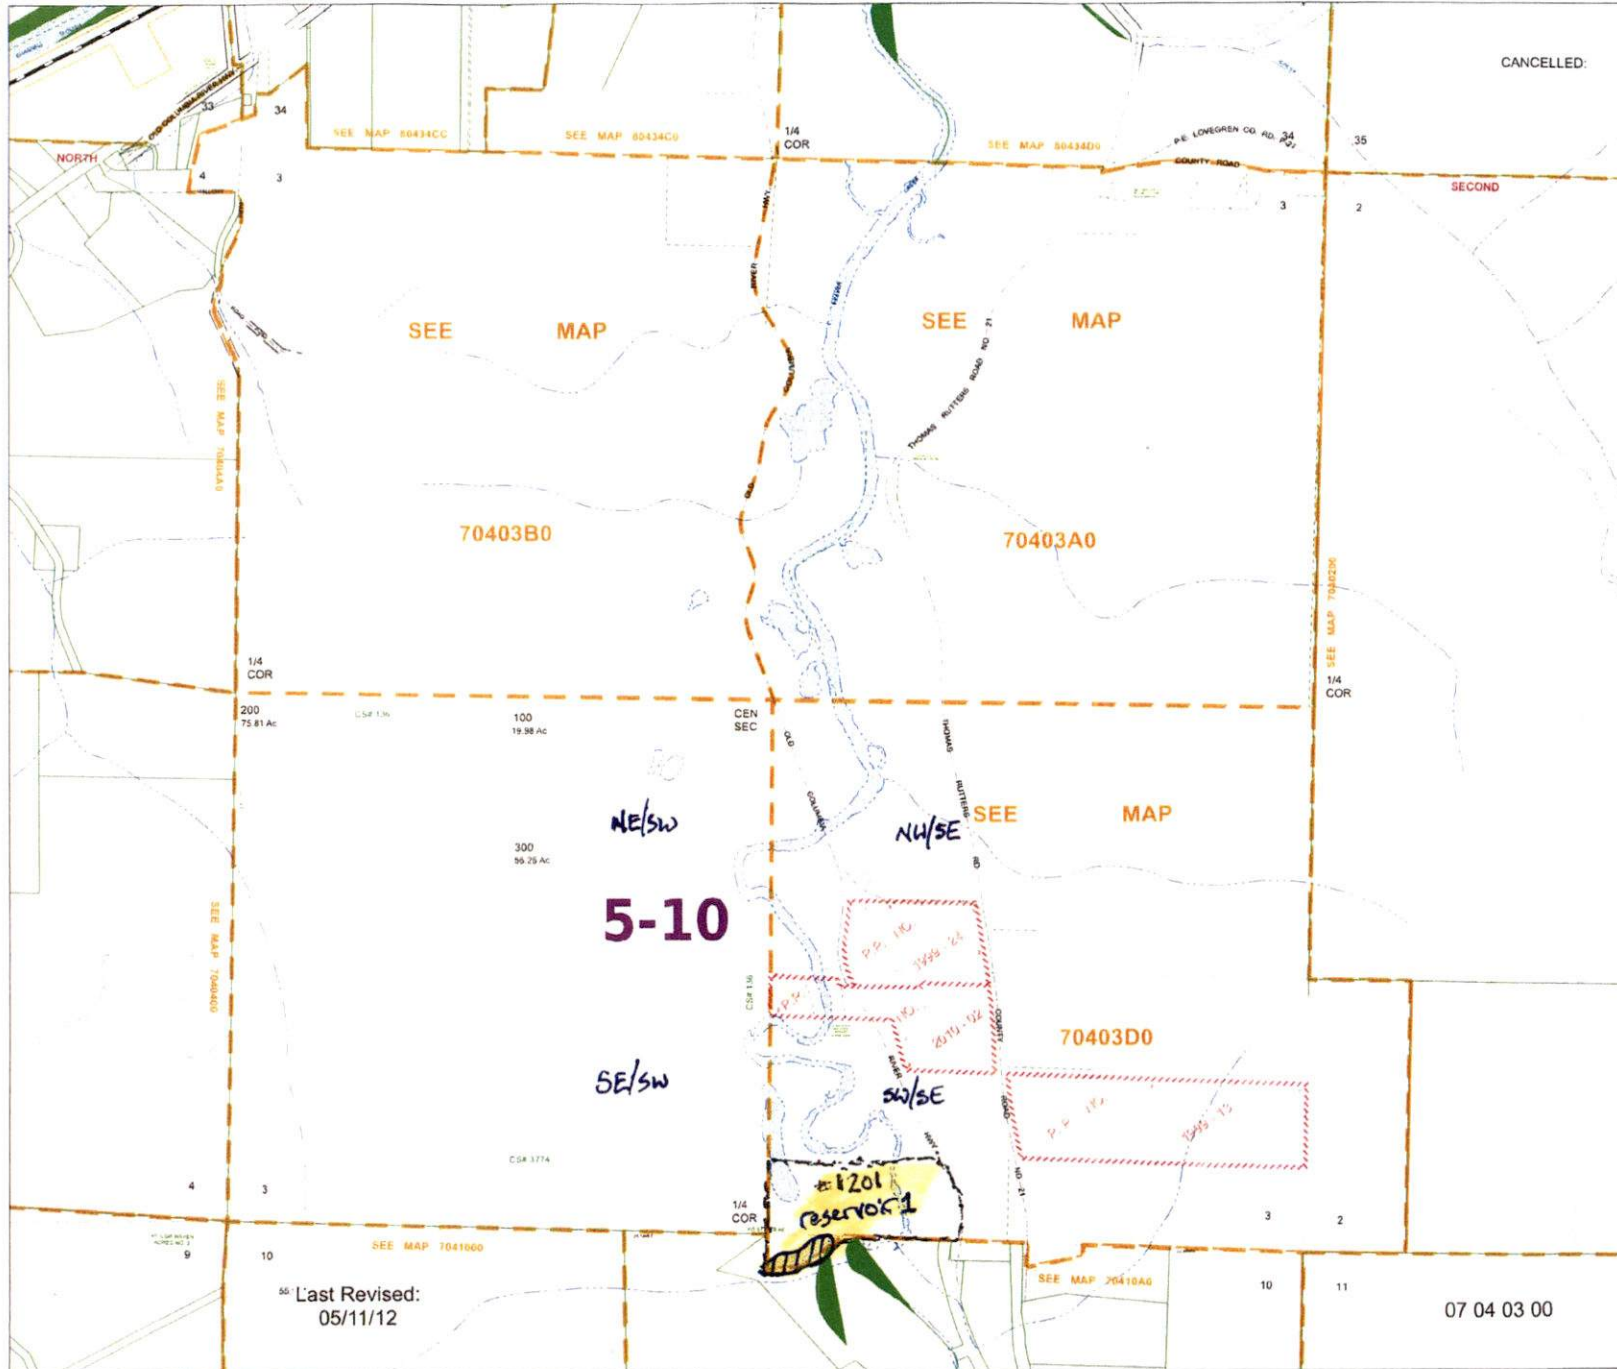

Dam location
2,177' west
and 10' north
of the ~~SE~~ SE
corner of section
3

RECEIVED
JUN 17 2019
OWRD

Last Revised:
05/11/12

07 04 03 00