

THIS MAP WAS PREPARED FOR ASSESSMENT PURPOSE ONLY

0 100 200 400 Feet


SECTION 3 T.7N. R.4W. W.M.

07 04 03 00

COLUMBIA COUNTY

1" = 400'

CANCELLED:

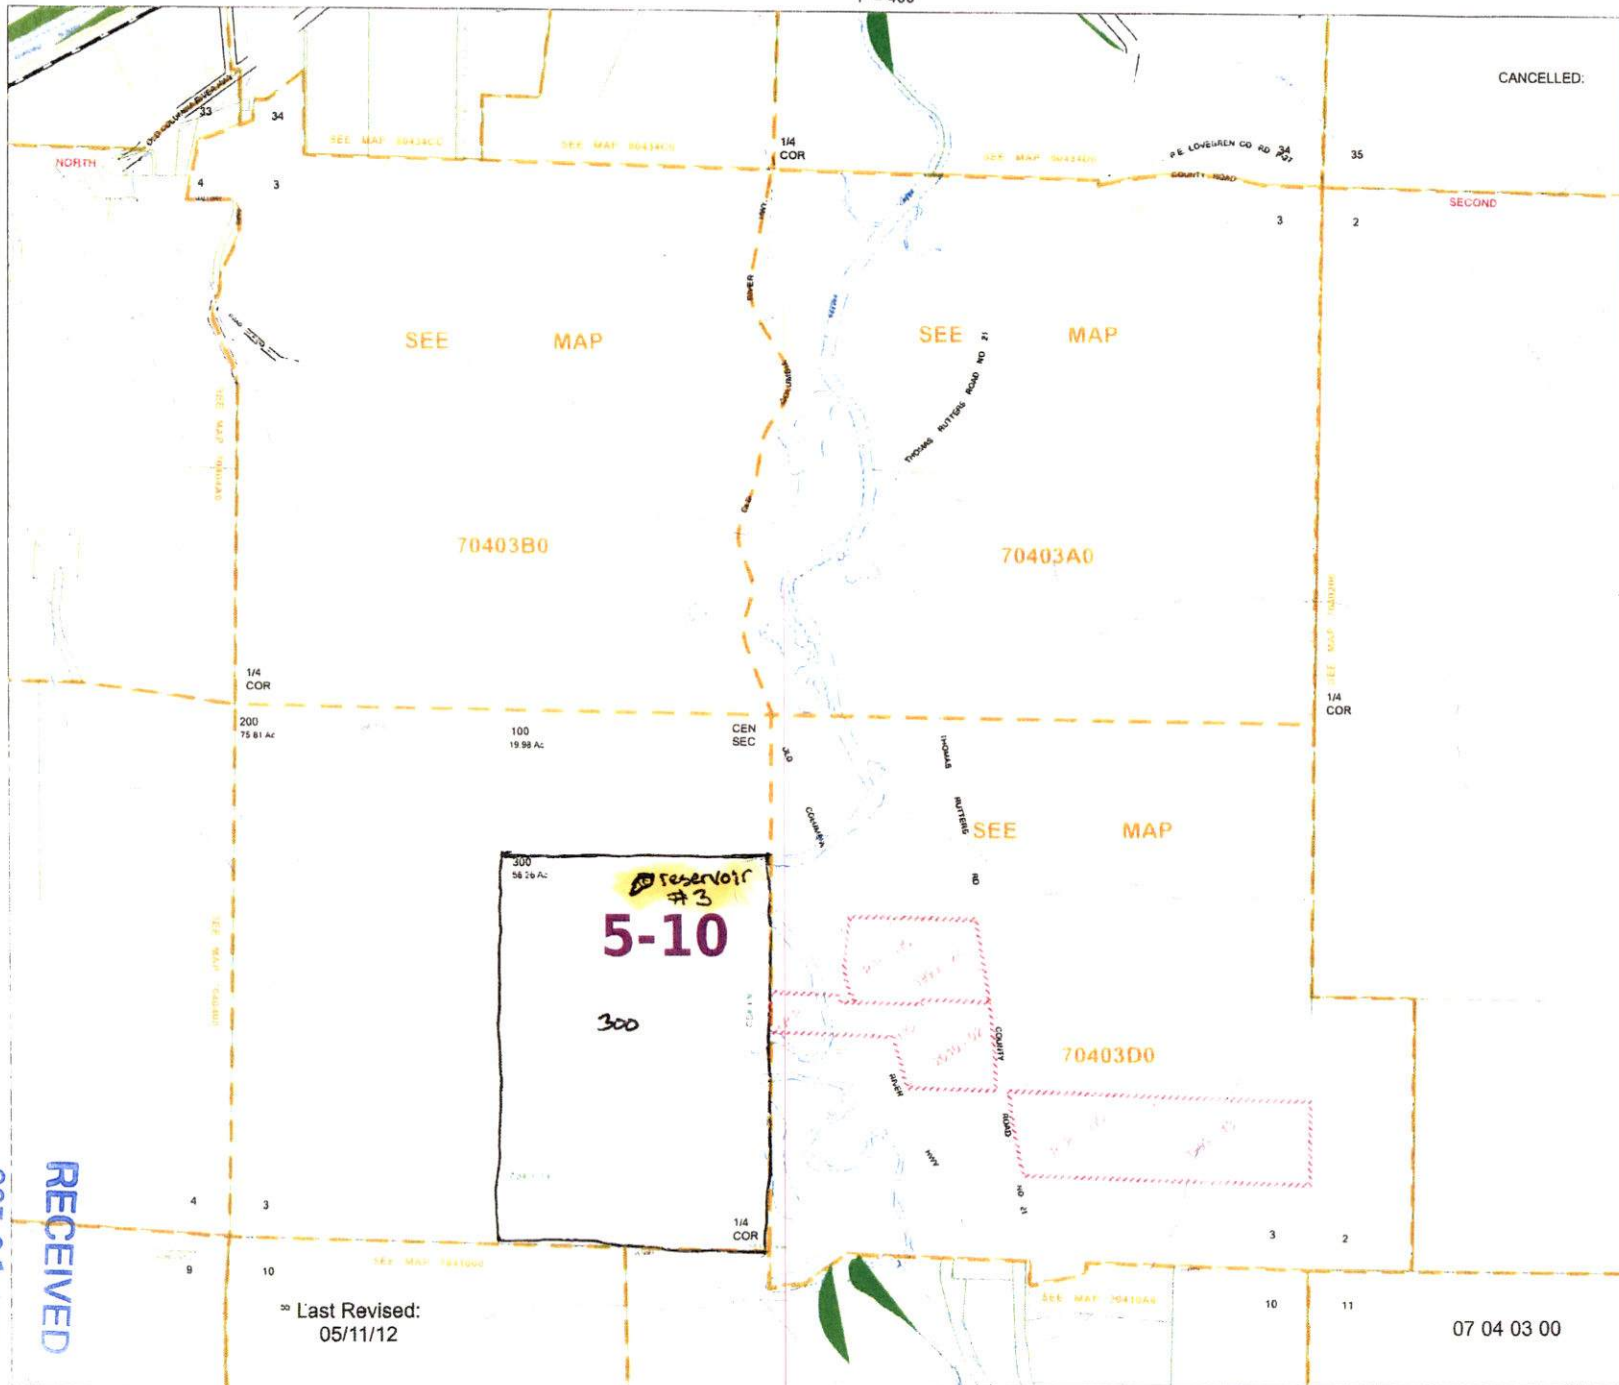

↑  
N  
 Dam location  
 3,015' west  
 and 1,828' north  
 of the SE  
 corner of  
 section 3

Last Revised: 05/11/12

07 04 03 00

RECEIVED  
OCT 21 2021  
OWRD

RECEIVED  
JUN 17 2019  
OWRD