

18487 S. Valley Vista Rd.  
Mulino, Oregon 97042  
(503) 632-5016 Phone  
(503) 632-5983 Fax

**Pacific Hydro-Geology Inc.**

# Memo

**To:** Oregon Water Resources Department / Travis Brown, Justin Iverson  
**From:** Doann Hamilton, CWRE  
**CC:**  
**Date:** December 10, 2019  
**Re:** Application G—18868 Groundwater report.


---

On November 26, 2019, the groundwater report for our client Steven Stadel Application G-18868 was issued by Travis Brown. In that report, the report noted the well location on the application map was incorrect. Corrections have been made to the map to correct the well location of Proposed Well 1 (CLAC 72984). Attached is the corrected map to reflect this change.

Oregon Water Rights Examiner  
85503  
*Doan H*  
DOANN M. HAMILTON  
May 10, 2012

RECEIVED *June 30, 2021*

# T.5S. R.2E. Section 24, W.M.

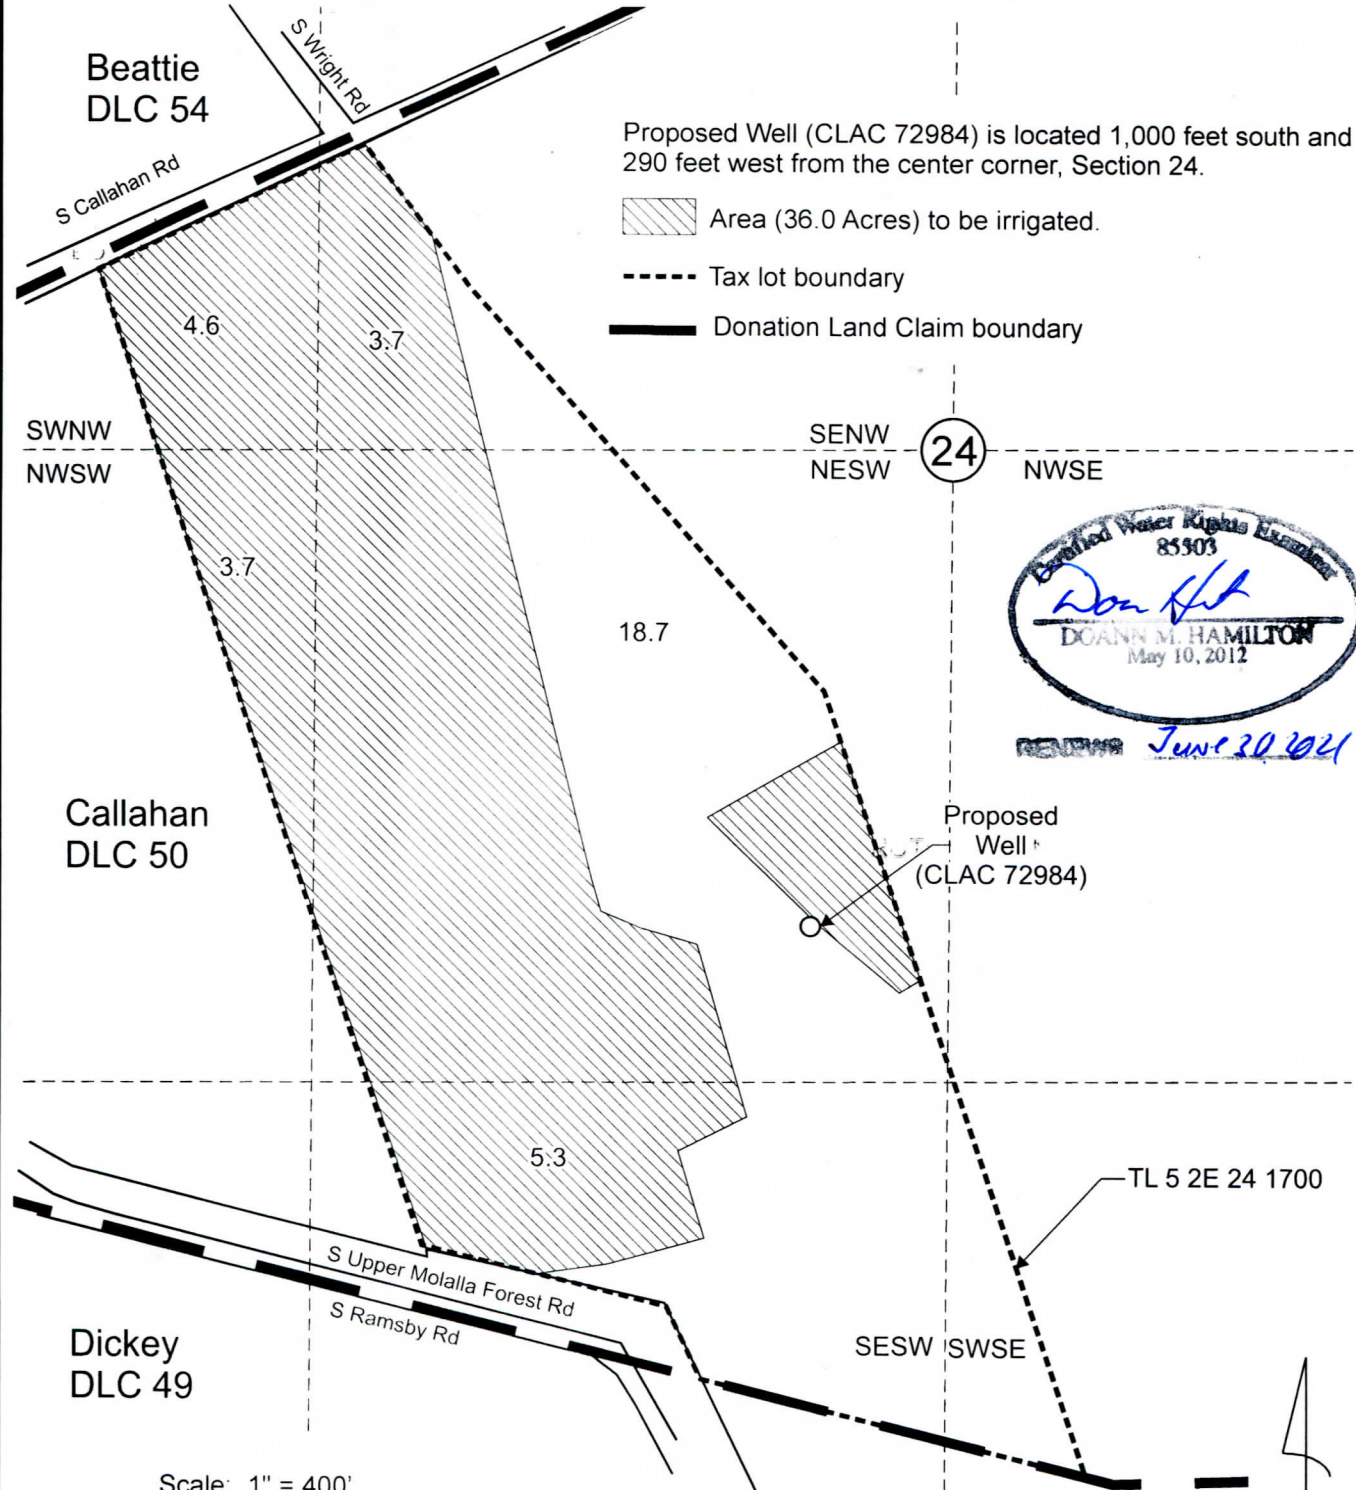


Proposed Well (CLAC 72984) is located 1,000 feet south and 290 feet west from the center corner, Section 24.

- Area (36.0 Acres) to be irrigated.
- Tax lot boundary
- Donation Land Claim boundary



Scale: 1" = 400'

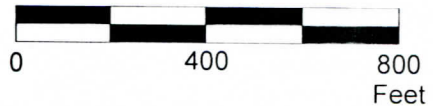

This map was prepared for the purpose of identifying the location of a water right only and is not intended to provide legal dimensions or location of property ownership lines.

## Water Right Application Map

Pacific Hydro-Geology Inc.

09/2019  
Rev. 12/2019

Steven N. and Karen L. Stadel  
T.5S. R.2E. Section 24, W.M.

StadelIGWApptMap.cdr