


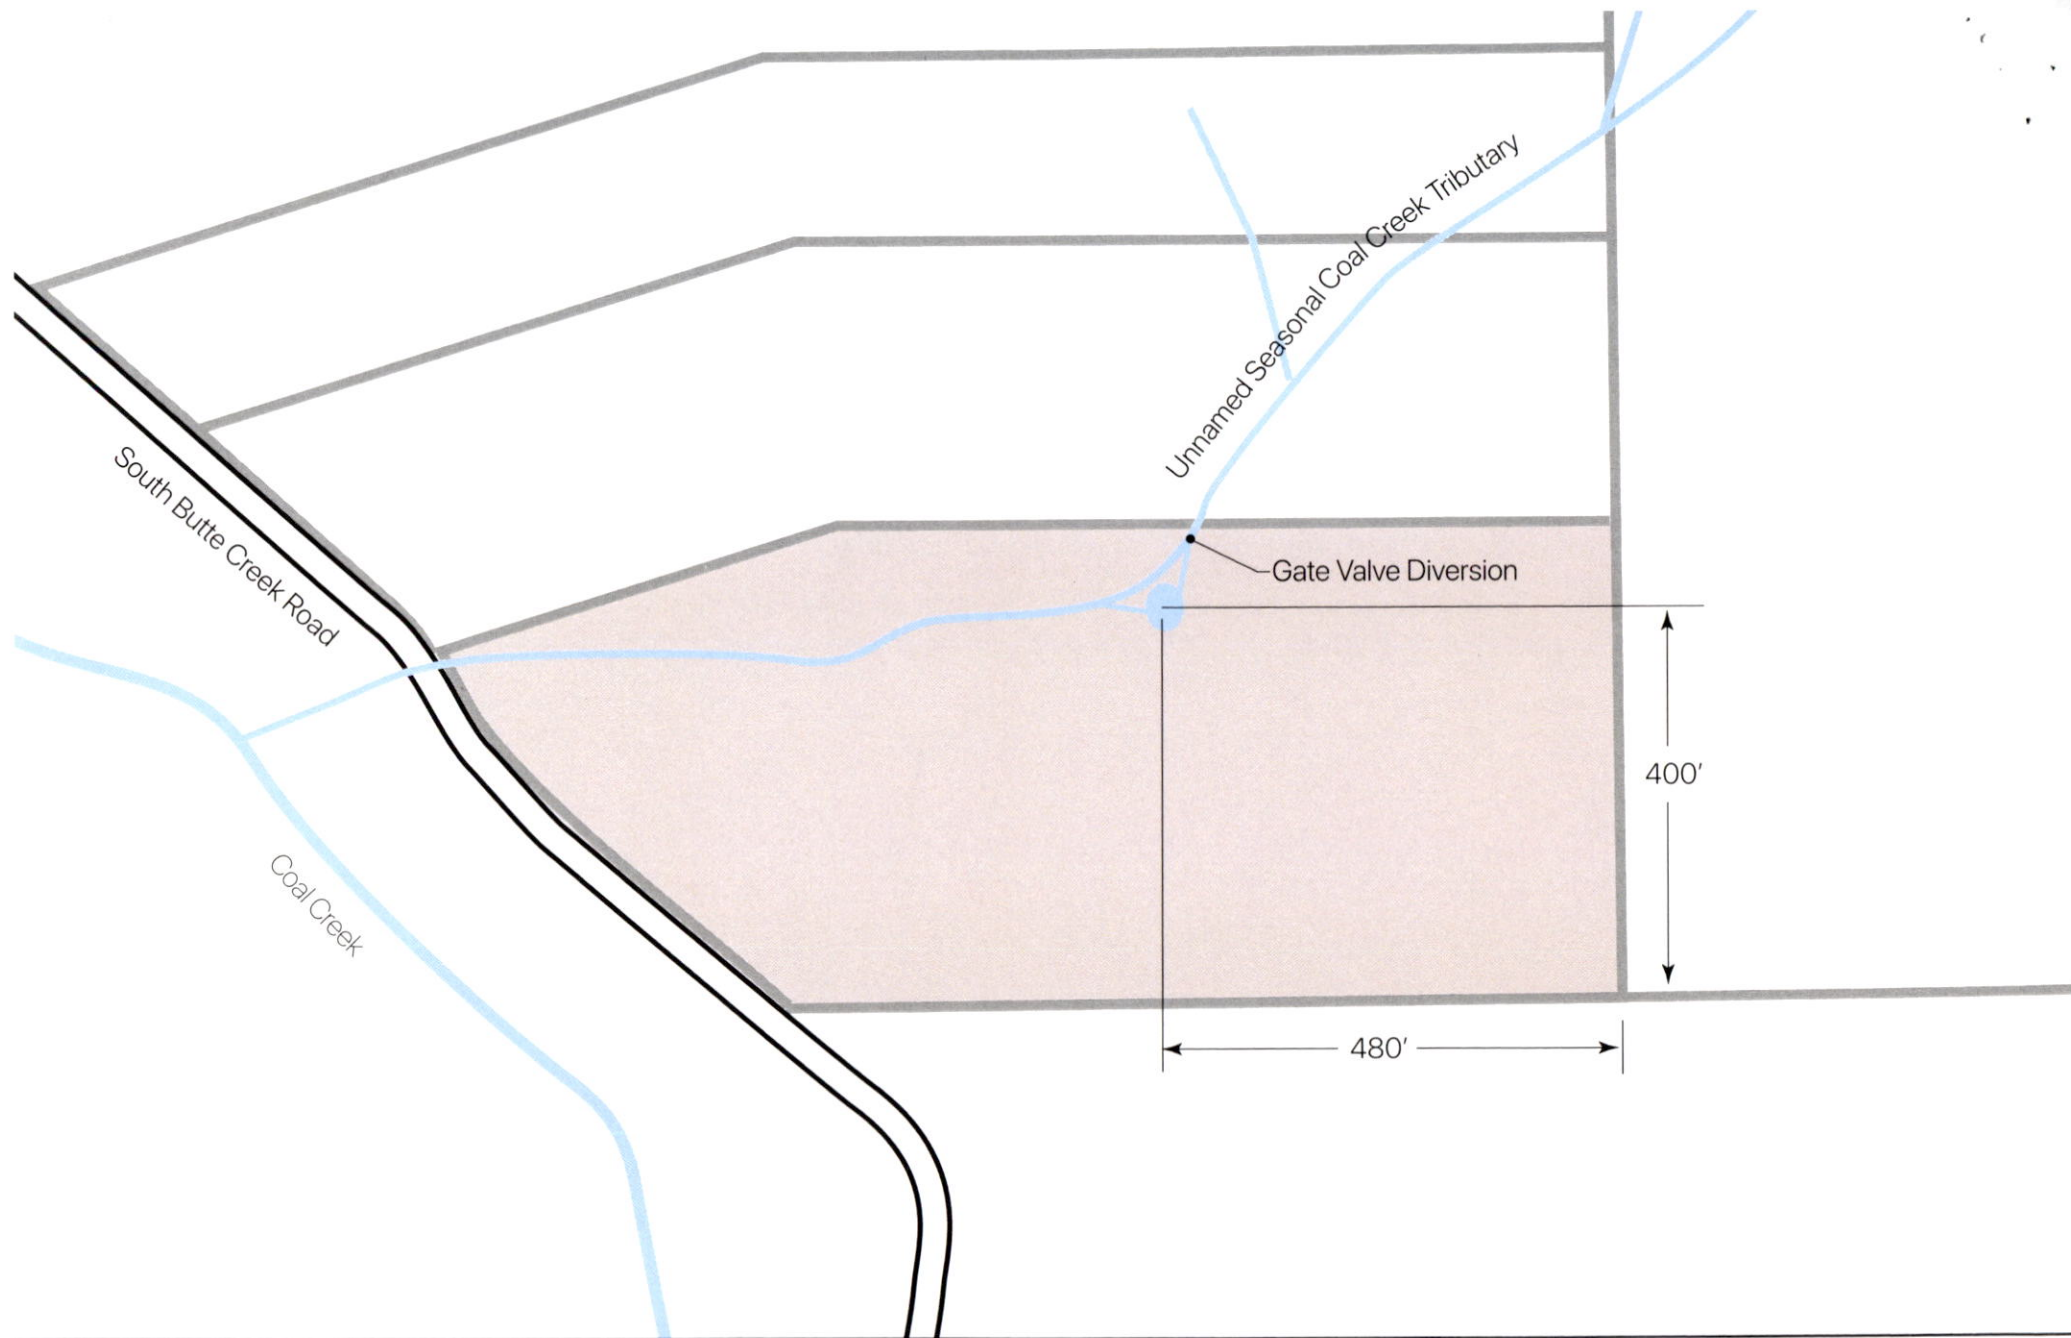

Scale: 1" = 200'

Township: 6 South
Range: 2 East
Section: 29
Quarter-Quarter: SW $\frac{1}{4}$ SE $\frac{1}{4}$
Tax Lot Number: 00401

RECEIVED

MAY 10 2021

OWRD



HYDROLOGY, ROADS, PROPERTY BOUNDARIES FROM
CLACKAMAS COUNTY GEOGRAPHIC INFORMATION SYSTEMS - 1.11.21

RECEIVED

AUG 16 2021

OWRD