

Township 17S Range 6W Section 34 NW-SW 600


Scale 1 inch = 300ft

Address 88083 & 88085 Rustad La Veneta OR 97487

E-RECEIVED  
April 5, 2022  
OWRD



Well is located 225 ft. west and 600ft. north of DLC Reference point.

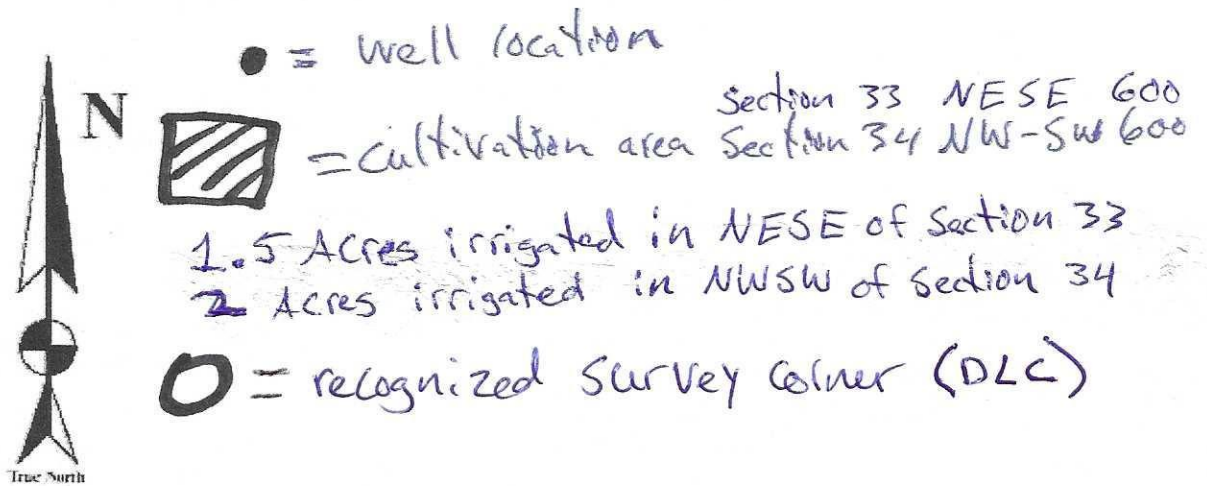

Grow area is inside 30 foot x 30 foot building approximately 850 sq ft of cultivation area.