


T.11S., R.30E., W.M.

T.11S., R.29E.
T.11S., R.30E.

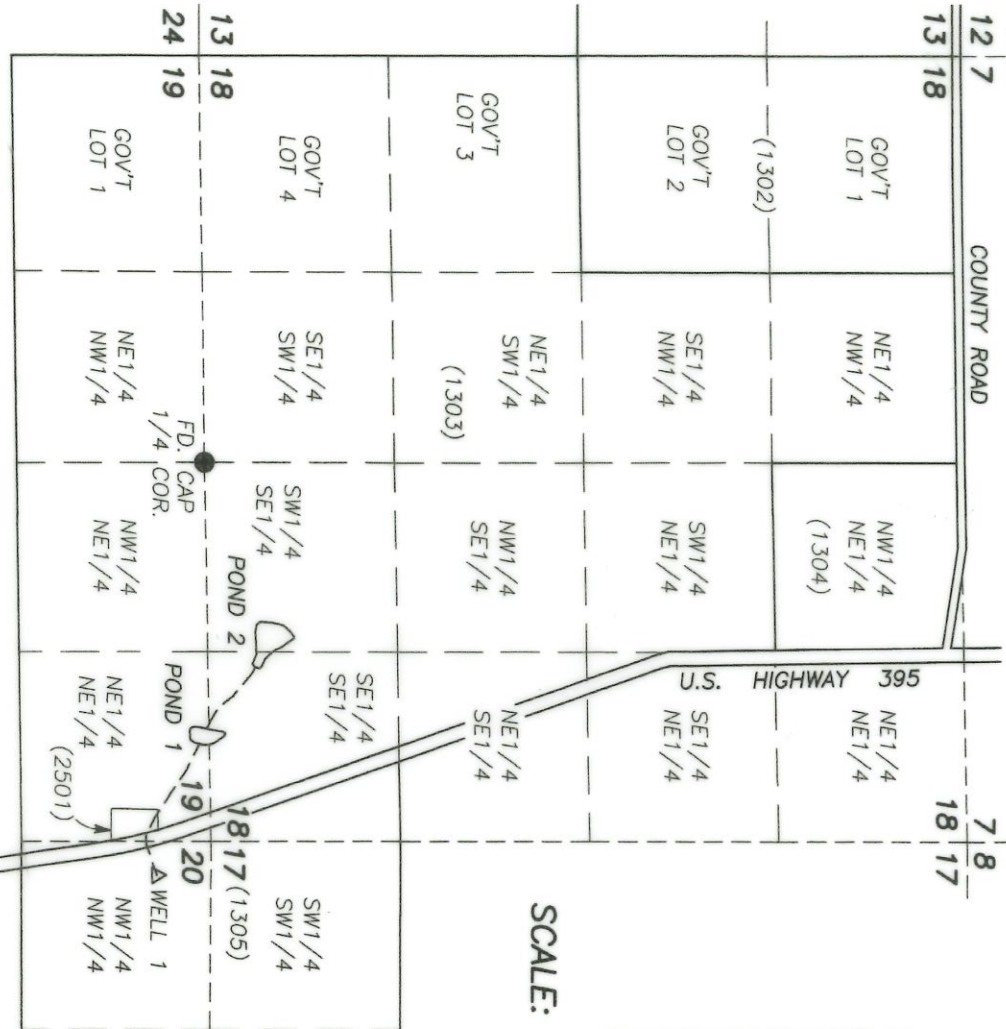

SCALE: 1"=1320'



CLAIM OF BENEFICIAL USE MAP

UNDER
APPLICATION G-17944
PERMIT G-17586
IN NAME OF
ROY VARDANEGA

POA - WELL 1: 330 FT. SOUTH & 2890 FT. EAST FROM
THE N1/4 CORNER SECTION 19,
T.11S., R.30E., W.M.

----- PIPELINE

() TAX LOT

RECEIVED

SEP 16 2021

OWRD

PREPARED BY
ROBERT D. BAGETT, PLS. CWRE
217 N. CANYON BLVD.
JOHN DAY, OR 97845

MAY 22, 2021



RENEW 12/31/2021

RECEIVED
SEP 16 2021

DISCLAIMER: THIS MAP IS NOT INTENDED TO
PROVIDE LEGAL DIMENSIONS OR LOCATIONS
OF PROPERTY OWNERSHIP LINES.